


STATE OF CALIFORNIA - DEPARTMENT OF TRANSPORTATION
Caltrans
 DESIGN OVERSIGHT
 BEHZAD GOLEMOHAMMADI

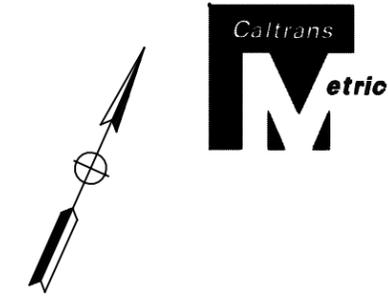


| | | | | | | |
|------|-------------|-------|-------------------------|--------------------|----------|--------------|
| DIST | COUNTY | ROUTE | KILOMETER TOTAL PROJECT | POST TOTAL PROJECT | SHEET No | TOTAL SHEETS |
| 04 | SF, Alameda | 80 | 12.2/14.3 | 0.0/4.0 | 407a | 1204 |
| | | | | | 06S02 | |

Registered Professional Engineer
 SYN YEE CHIN
 No. 18186
 Exp. 09/30/2011
 ELECTRICAL
 STATE OF CALIFORNIA

03/08/10
 REGISTERED ELECTRICAL ENGINEER DATE
 05-06-2010
 PLANS APPROVAL DATE
 PB AMERICAS, Inc.
 A Parsons Brinckerhoff Company
 303 Second St., Suite 700N
 San Francisco, CA 94107-1317

The State of California or its officers or agents shall not be responsible for the accuracy or completeness of electronic copies of this plan sheet.
 Caltrans now has a web site! To get to the web site, go to <http://www.dot.ca.gov>

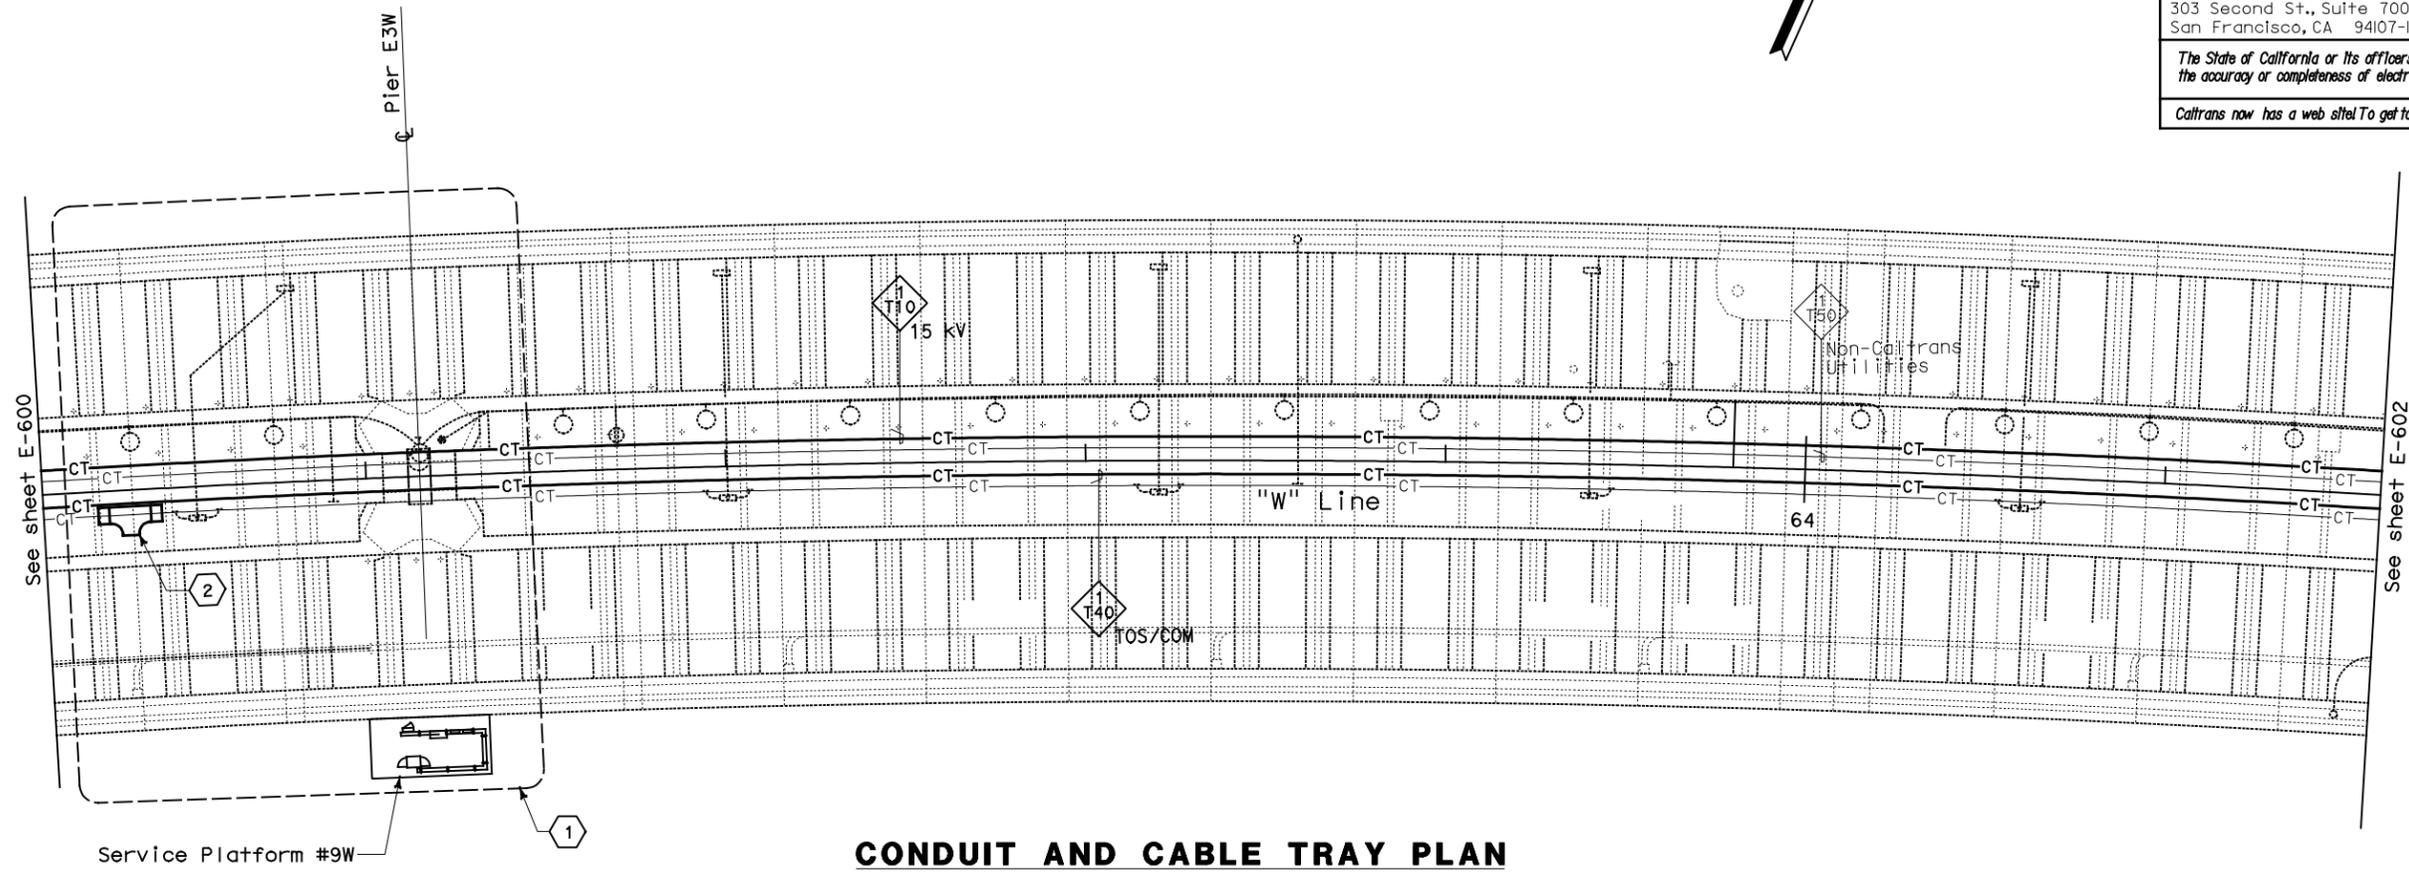

CONDUIT AND CABLE TRAY PLAN

NOTES:

- This plan sheet is a record drawing from Skyway Structures contract. The Contractor shall verify the existing installation. See sheet EE-62 of Skyway Structures, contract No. 04-012024.
- The installed components shall not be limited to the ones listed below, but shall be a complete installation. For details, see Bridge Structures Girder Westbound, typical Details sheets.
 - Furnish and install 15 kV cables into existing cable tray shown on this drawing. Refer to riser diagram on sheets E-664 and E-665.
 - Furnish and install TOS fiber optic cables into existing cable tray shown on this drawing. Refer to riser diagram on sheets E-978 through E-981.
 - Inspect for system ground continuity. See sheets E-666 and E-667.
- All cable trays shown on this drawing are existing. Bold ones are to be used for pulling cable.

SHEET NOTES:

- For Service Platform #9W details, see sheet E-638.
- Furnish and install splice cable tray as shown on sheet E-663, plan detail 2.

| | | | | | |
|---|----------|-----------------|-----|------|------|
| REQUEST FOR INFORMATION NOT ADDRESSED IN THIS CCO REMAIN IN FORCE | | | | | |
| △ | 03/08/10 | MEP INTEGRATION | SYC | FW | 110 |
| MARK | DATE | DESCRIPTIONS | BY | CH'D | CCO# |
| REVISIONS | | | | | |


CONTRACT CHANGE ORDER NO. _____
 SHEET _____ OF _____

**BRIDGE STRUCTURES GIRDER WESTBOUND
 SKYWAY STRUCTURES**
 SCALE: 1:200

E-601

THIS PLAN ACCURATE FOR ELECTRICAL WORK ONLY.

ALL DIMENSIONS ARE IN METERS UNLESS OTHERWISE SHOWN
 FOR REDUCED PLANS ORIGINAL SCALE IS IN MILLIMETERS

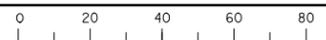

DGN FILE => 04-0120f1_E-601.dgn
 USERNAME => ilorico

CU 04251

EA 0120F1

DATE PLOTTED => 26-MAY-2010
 TIME PLOTTED => 11:16
 LAST REVISION 00-00-00