


STATE OF CALIFORNIA - DEPARTMENT OF TRANSPORTATION
Caltrans
 DESIGN OVERSIGHT
 BEHZAD GOLEHAMMADI
 CALCULATED/DESIGNED BY
 CHECKED BY
 DATE 01/10
 REVISED BY
 DATE REVISED



DIST	COUNTY	ROUTE	KILOMETER TOTAL PROJECT	POST TOTAL PROJECT	SHEET No	TOTAL SHEETS
04	SF, Alameda	80	12.2/14.3	0.0/4.0	407a	1204
REGISTERED ELECTRICAL ENGINEER SYN YEE CHIN 03/08/10 DATE						
PLANS APPROVAL DATE 05-06-2010						
PB AMERICAS, Inc. A Parsons Brinckerhoff Company 303 Second St., Suite 700N San Francisco, CA 94107-1317						
The State of California or its officers or agents shall not be responsible for the accuracy or completeness of electronic copies of this plan sheet.						
Caltrans now has a web site! To get to the web site, go to http://www.dot.ca.gov						

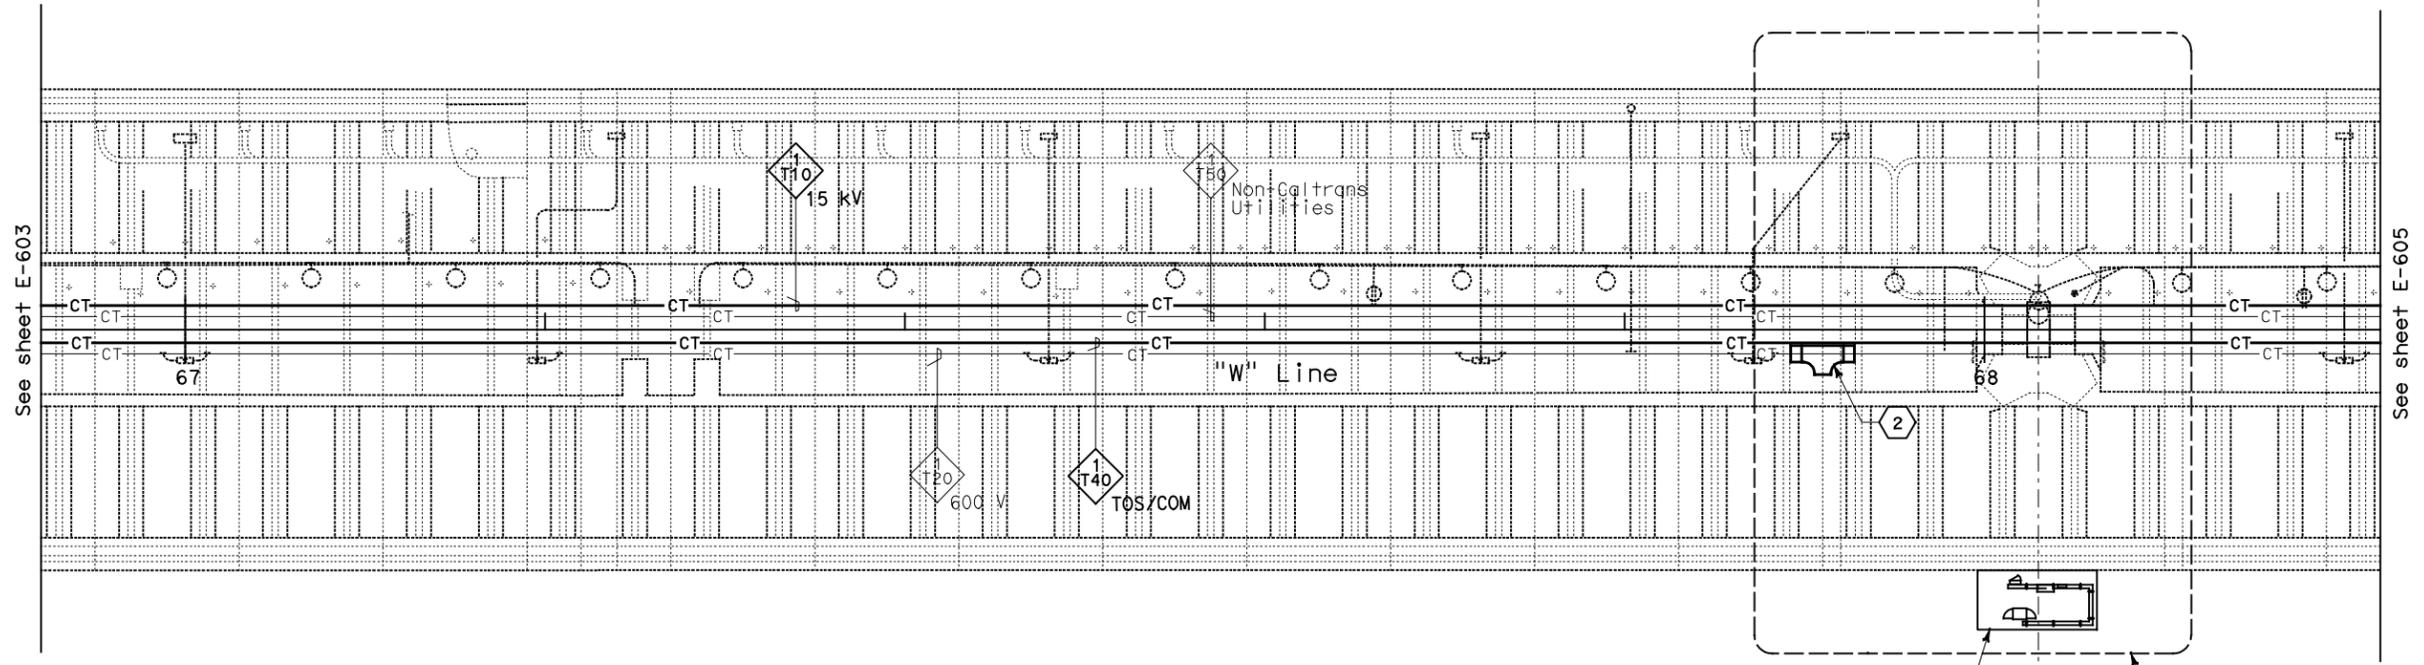

CONDUIT AND CABLE TRAY PLAN

NOTES:

1. This plan sheet is a record drawing from Skyway Structures contract. The Contractor shall verify the existing installation. See sheet EE-65 of Skyway Structures, contract No. 04-012024.
2. The installed components shall not be limited to the ones listed below, but shall be a complete installation. For details, see Bridge Structures Girder Westbound, typical Details sheets.
 - Furnish and install 15 kV cables into existing cable tray shown on this drawing. Refer to riser diagram on sheets E-664 and E-665.
 - Furnish and install TOS fiber optic cables into existing cable tray shown on this drawing. Refer to riser diagram on sheets E-978 through E-981.
 - Inspect for system ground continuity. See sheets E-666 and E-667.
3. All cable trays shown on this drawing are existing. Bold ones are to be used for pulling cable.

SHEET NOTES:

- 1 For Service Platform #12W details, See sheet E-641.
- 2 Furnish and install splice cable tray as shown on E-663, plan detail 2.

REQUEST FOR INFORMATION NOT ADDRESSED IN THIS CCO REMAIN IN FORCE					
△	03/08/10	MEP INTEGRATION	SYC	FW	110
MARK	DATE	DESCRIPTIONS	BY	CH'D	CCO#
REVISIONS					

CONTRACT CHANGE ORDER NO. _____
 SHEET ____ OF ____

**BRIDGE STRUCTURES GIRDER WESTBOUND
 SKYWAY STRUCTURES**
 SCALE: 1:200

E-604

THIS PLAN ACCURATE FOR ELECTRICAL WORK ONLY.



DGN FILE => 04-0120f1_E-604.dgn
 USERNAME => ilorico

CU 04251

EA 0120F1

DATE PLOTTED => 25-MAY-2010
 TIME PLOTTED => 11:17
 LAST REVISION
 00-00-00