


STATE OF CALIFORNIA - DEPARTMENT OF TRANSPORTATION
Caltrans
 DESIGN OVERSIGHT
 BEHZAD GOLEHAMMADI
 CHECKED BY
 CALCULATED/DESIGNED BY
 DATE 01/10
 REVISED BY
 DATE 01/10
 REVISED BY
 DATE 01/10

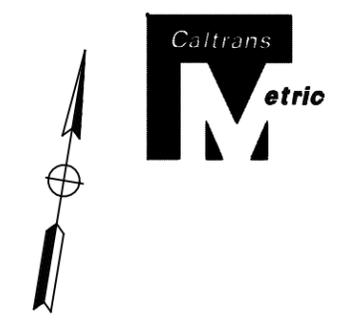


DIST	COUNTY	ROUTE	KILOMETER TOTAL PROJECT	POST PROJECT	SHEET No	TOTAL SHEETS
04	SF, Alameda	80	12.2/14.3	0.0/4.0	407a	1204
					06S08	

Registered Professional Engineer
 SYN YEE CHIN
 No. 18186
 Exp. 09/30/2011
 ELECTRICAL
 STATE OF CALIFORNIA

03/08/10
 REGISTERED ELECTRICAL ENGINEER DATE
 PLANS APPROVAL DATE
 05-06-2010
 PB AMERICAS, Inc.
 A Parsons Brinckerhoff Company
 303 Second St., Suite 700N
 San Francisco, CA 94107-1317

The State of California or its officers or agents shall not be responsible for the accuracy or completeness of electronic copies of this plan sheet.
 Caltrans now has a web site! To get to the web site, go to <http://www.dot.ca.gov>

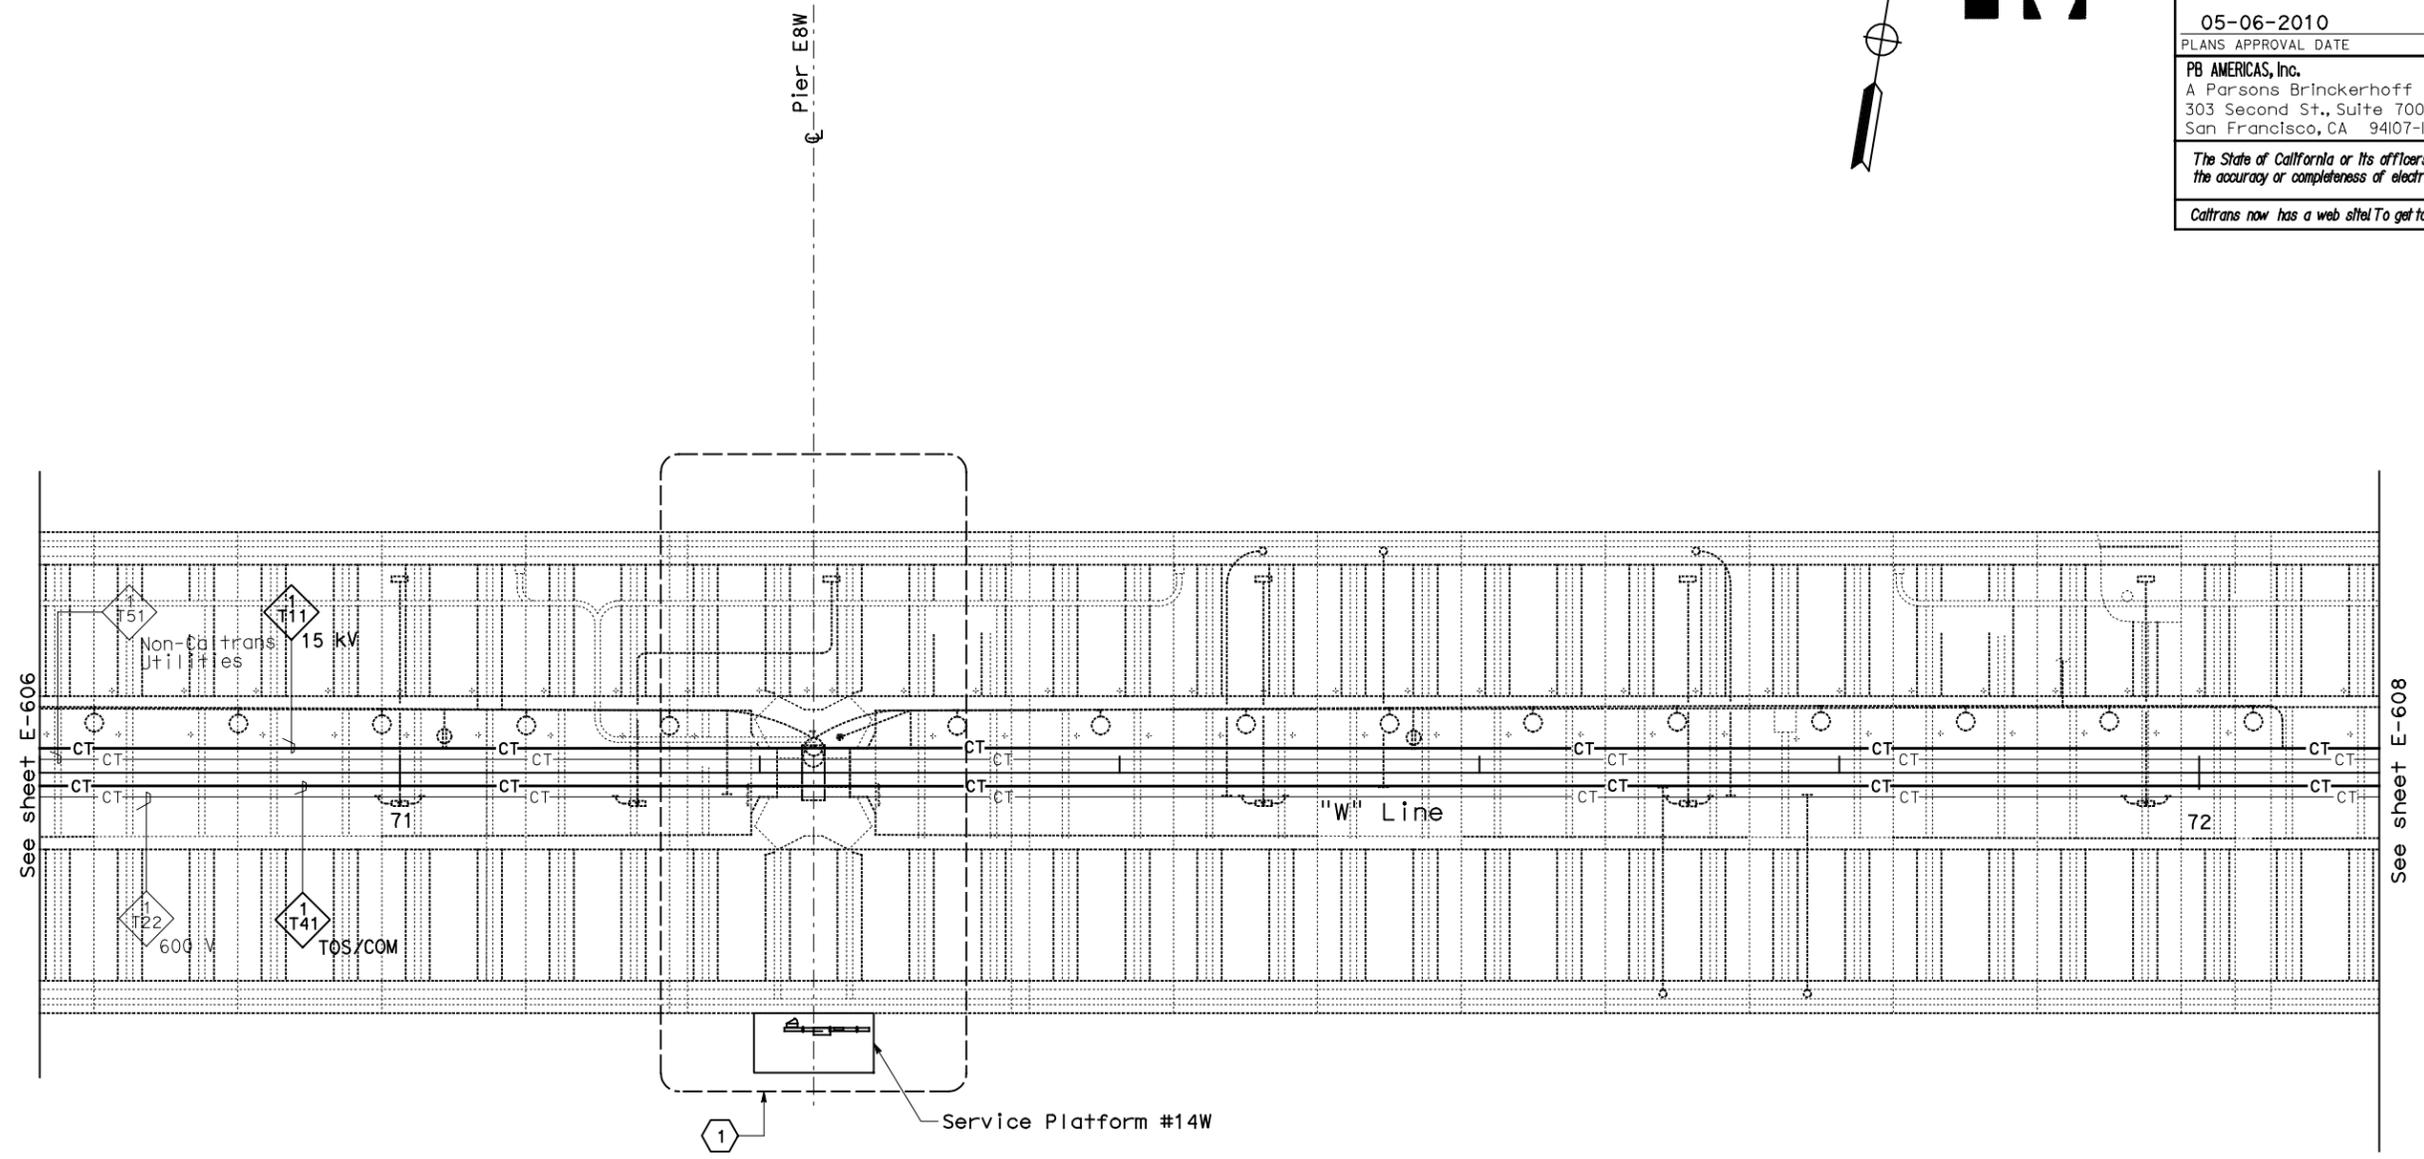

CONDUIT AND CABLE TRAY PLAN

NOTES:

- This plan sheet is a record drawing from Skyway Structures contract. The Contractor shall verify the existing installation. See sheet EE-68 of Skyway Structures, contract No. 04-012024.
- The installed components shall not be limited to the ones listed below, but shall be a complete installation. For details, see Bridge Structures Girder Westbound, typical Details sheets.
 - Furnish and install 15 kv cables into existing cable tray shown on this drawing. Refer to riser diagram on E-664 and E-665.
 - Furnish and install TOS fiber optic cables into existing cable tray shown on this drawing. Refer to riser diagram on sheets E-978 through E-981.
 - Inspect for system ground continuity. See sheets E-666 and E-667.
- All cable trays shown on this drawing are existing. Bold ones are to be used for pulling cable.

SHEET NOTES:

- For Service Platform #14W details, see sheet E-645.

REQUEST FOR INFORMATION NOT ADDRESSED IN THIS CCO REMAIN IN FORCE					
△	03/08/10	MEP INTEGRATION	SYC	FW	110
MARK	DATE	DESCRIPTIONS	BY	CH'D	CCO#
REVISIONS					

CONTRACT CHANGE ORDER NO. _____
 SHEET ____ OF ____

**BRIDGE STRUCTURES GIRDER WESTBOUND
 SKYWAY STRUCTURES**
 SCALE: 1:200

E-607

THIS PLAN ACCURATE FOR ELECTRICAL WORK ONLY.



DGN FILE => 04-0120f1_E-607.dgn
 USERNAME => ilorico

CU 04251

EA 0120F1

DATE PLOTTED => 25-MAY-2010
 TIME PLOTTED => 11:17
 LAST REVISION 00-00-00