

STATE OF CALIFORNIA - DEPARTMENT OF TRANSPORTATION
Caltrans
 DESIGN OVERSIGHT
 BEHZAD GOLEHAMMADI
 CALCULATED/DESIGNED BY
 CHECKED BY
 DATE 01/10
 REVISED BY
 DATE REVISED

DIST	COUNTY	ROUTE	KILOMETER TOTAL PROJECT	POST PROJECT	SHEET No	TOTAL SHEETS
04	SF, Alameda	80	12.2/14.3	0.0/4.0	4079	1204
					06S10	

REGISTERED ELECTRICAL ENGINEER
 SYN YEE CHIN
 No. 18186
 Exp. 09/30/2011
 STATE OF CALIFORNIA



03/08/10
 PLANS APPROVAL DATE

05-06-2010
 PLANS APPROVAL DATE

PB AMERICAS, Inc.
 A Parsons Brinckerhoff Company
 303 Second St., Suite 700N
 San Francisco, CA 94107-1317

The State of California or its officers or agents shall not be responsible for the accuracy or completeness of electronic copies of this plan sheet.

Caltrans now has a web site! To get to the web site, go to <http://www.dot.ca.gov>

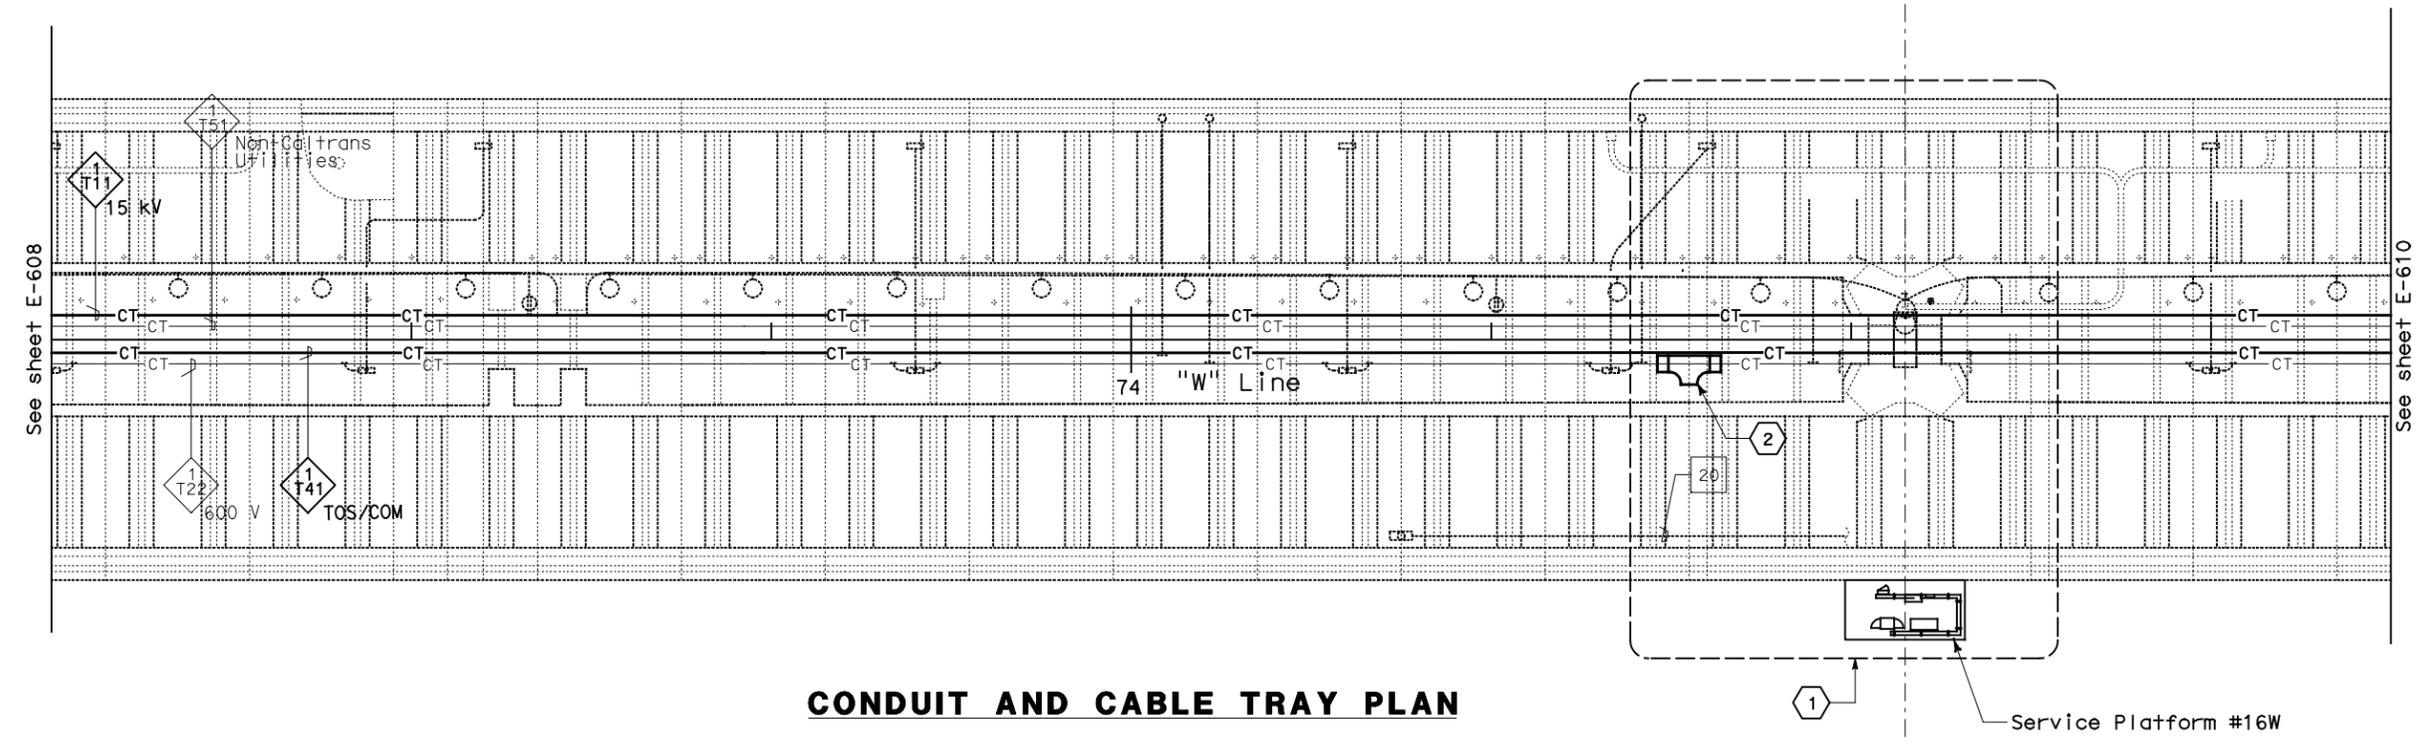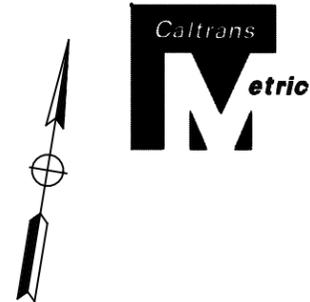

CONDUIT AND CABLE TRAY PLAN

NOTES:

- This plan sheet is a record drawing from Skyway Structures contract. The Contractor shall verify the existing installation. See sheet EE-70 of Skyway Structures, contract No. 04-012024.
- The installed components shall not be limited to the ones listed below, but shall be a complete installation. For details, see Bridge Structures Girder Westbound, typical Details sheets.
 - Furnish and install 15 kV cables into existing cable tray shown on this drawing. Refer to riser diagram on sheets E-664 and E-665.
 - Furnish and install TOS fiber optic cables into existing cable tray shown on this drawing. Refer to riser diagram on sheets E-978 through E-981.
 - Inspect for system ground continuity. See sheets E-666 and E-667.
- All cable trays shown on this drawing are existing. Bold ones are to be used for pulling cable.

SHEET NOTES:

- For Service Platform #16W details, see sheet E-647.
- Furnish and install splice cable tray as shown on sheet E-663, plan detail 2.

REQUEST FOR INFORMATION NOT ADDRESSED IN THIS CCO REMAIN IN FORCE					
△	03/08/10	MEP INTEGRATION	SYC	FW	110
MARK	DATE	DESCRIPTIONS	BY	CH'D	CCO#
REVISIONS					

CONTRACT CHANGE ORDER NO. _____
 SHEET _____ OF _____


**BRIDGE STRUCTURES GIRDER WESTBOUND
 SKYWAY STRUCTURES**

SCALE: 1:200

E-609

THIS PLAN ACCURATE FOR ELECTRICAL WORK ONLY.

ALL DIMENSIONS ARE IN METERS UNLESS OTHERWISE SHOWN. DIMENSIONS ARE IN MILLIMETERS UNLESS OTHERWISE SHOWN.
 FOR REDUCED PLANS ORIGINAL SCALE IS IN MILLIMETERS

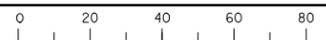

DGN FILE => 04-0120f1_E-609.dgn
 USERNAME => ilorico

CU 04251

EA 0120F1

DATE PLOTTED => 06-MAY-2010
 TIME PLOTTED => 18:03
 LAST REVISION
 00-00-00