



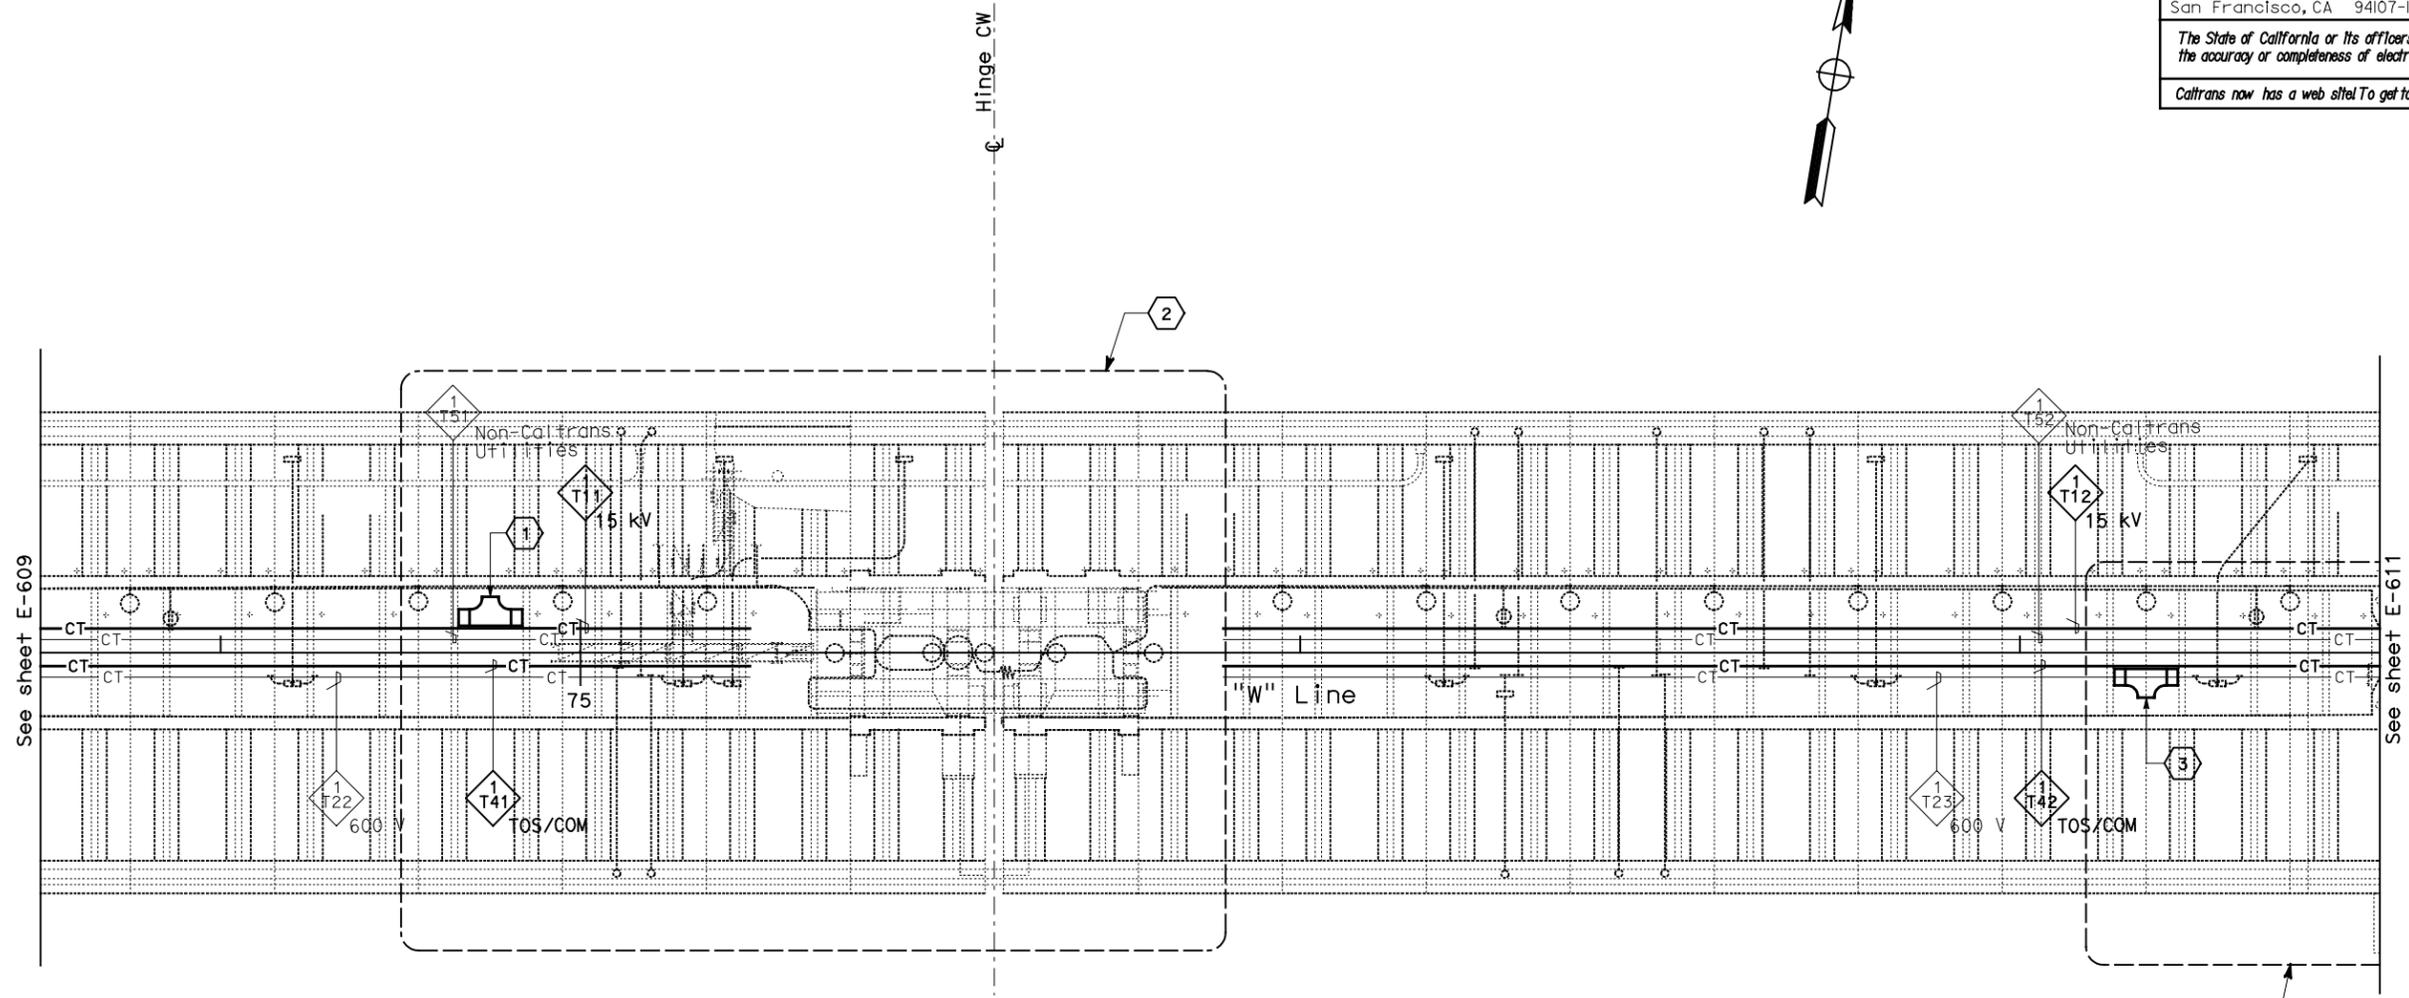

DIST	COUNTY	ROUTE	KILOMETER TOTAL PROJECT	POST PROJECT	SHEET No	TOTAL SHEETS
04	SF, Alameda	80	12.2/14.3	0.0/4.0	4079	1204
REGISTERED ELECTRICAL ENGINEER					DATE	
05-06-2010					PLANS APPROVAL DATE	
PB AMERICAS, Inc. A Parsons Brinckerhoff Company 303 Second St., Suite 700N San Francisco, CA 94107-1317						
The State of California or its officers or agents shall not be responsible for the accuracy or completeness of electronic copies of this plan sheet.						
Caltrans now has a web site! To get to the web site, go to <a href="http://www.dot.ca.gov">http://www.dot.ca.gov</a>						

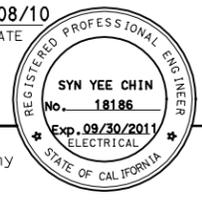

**CONDUIT AND CABLE TRAY PLAN**

**NOTES:**

- This plan sheet is a record drawing from Skyway Structures contract. The Contractor shall verify the existing installation. See sheet EE-71 from Skyway Structures, contract No. 04-012024.
- The installed components shall not be limited to the ones listed below, but shall be a complete installation. For details, see Bridge Structures Girder Westbound, typical Details sheets.
  - Furnish and install 15kv cables into existing cable tray shown on this drawing. Refer to riser diagram on sheets E-664 and E-665.
  - Furnish and install TOS fiber optic cables into existing cable tray shown on this drawing. Refer to riser diagram on sheets E-978 through E-981.
  - Inspect for system ground continuity. See sheets E-666 and E-667.
- All cable trays shown on this drawing are existing. Bold ones are to be used for pulling cable.

**SHEET NOTES:**

- Furnish and install splice cable tray as shown on sheet E-663, plan detail 1.
- For Hinge CW area details, see sheet E-648.
- Furnish and install splice cable tray as shown on sheet E-663, plan detail 2.


REQUEST FOR INFORMATION NOT ADDRESSED IN THIS CCO REMAIN IN FORCE					
△	03/08/10	MEP INTEGRATION	SYC	FW	110
MARK	DATE	DESCRIPTIONS	BY	CH'D	CCO#
REVISIONS					

CONTRACT CHANGE ORDER NO. \_\_\_\_\_  
SHEET \_\_\_\_ OF \_\_\_\_

**BRIDGE STRUCTURES GIRDER WESTBOUND  
SKYWAY STRUCTURES**  
SCALE: 1:200

**E-610**

THIS PLAN ACCURATE FOR ELECTRICAL WORK ONLY.

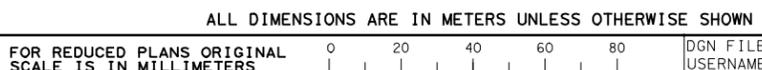

DGN FILE => 04-0120f1\_E-610.dgn  
USERNAME => ilorico

CU 04251

EA 0120F1

STATE OF CALIFORNIA - DEPARTMENT OF TRANSPORTATION  
 DESIGN OVERSIGHT  
 BEHZAD GOLEHAMMADI  
 CALCULATED/DESIGNED BY  
 CHECKED BY  
 DATE 01/10  
 REVISED BY  
 DATE REVISED  
 SYNC  
 FW  
 Caltrans

DATE PLOTTED => 06-MAY-2010  
 TIME PLOTTED => 18:03  
 LAST REVISION  
 00-00-00