

DIST	COUNTY	ROUTE	KILOMETER TOTAL PROJECT	POST PROJECT	SHEET No	TOTAL SHEETS
04	SF, Alameda	80	12.2/14.3	0.0/4.0	407a 06S23	1204


Syn Yee Chin 03/08/10  
 REGISTERED ELECTRICAL ENGINEER DATE

05-06-2010  
 PLANS APPROVAL DATE


PB AMERICAS, Inc.  
 A Parsons Brinckerhoff Company  
 303 Second St., Suite 700N  
 San Francisco, CA 94107-1317

The State of California or its officers or agents shall not be responsible for the accuracy or completeness of electronic copies of this plan sheet.

Caltrans now has a web site to get to the web site, go to <http://www.dot.ca.gov>

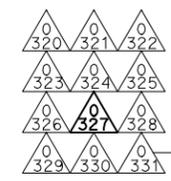

STATE OF CALIFORNIA - DEPARTMENT OF TRANSPORTATION  
 DESIGN OVERSIGHT: BEHZAD GOLEMOHAMMADI  
 CHECKED BY: \_\_\_\_\_  
 DATE 01/10  
 REVISOR: \_\_\_\_\_  
 DATE 01/10

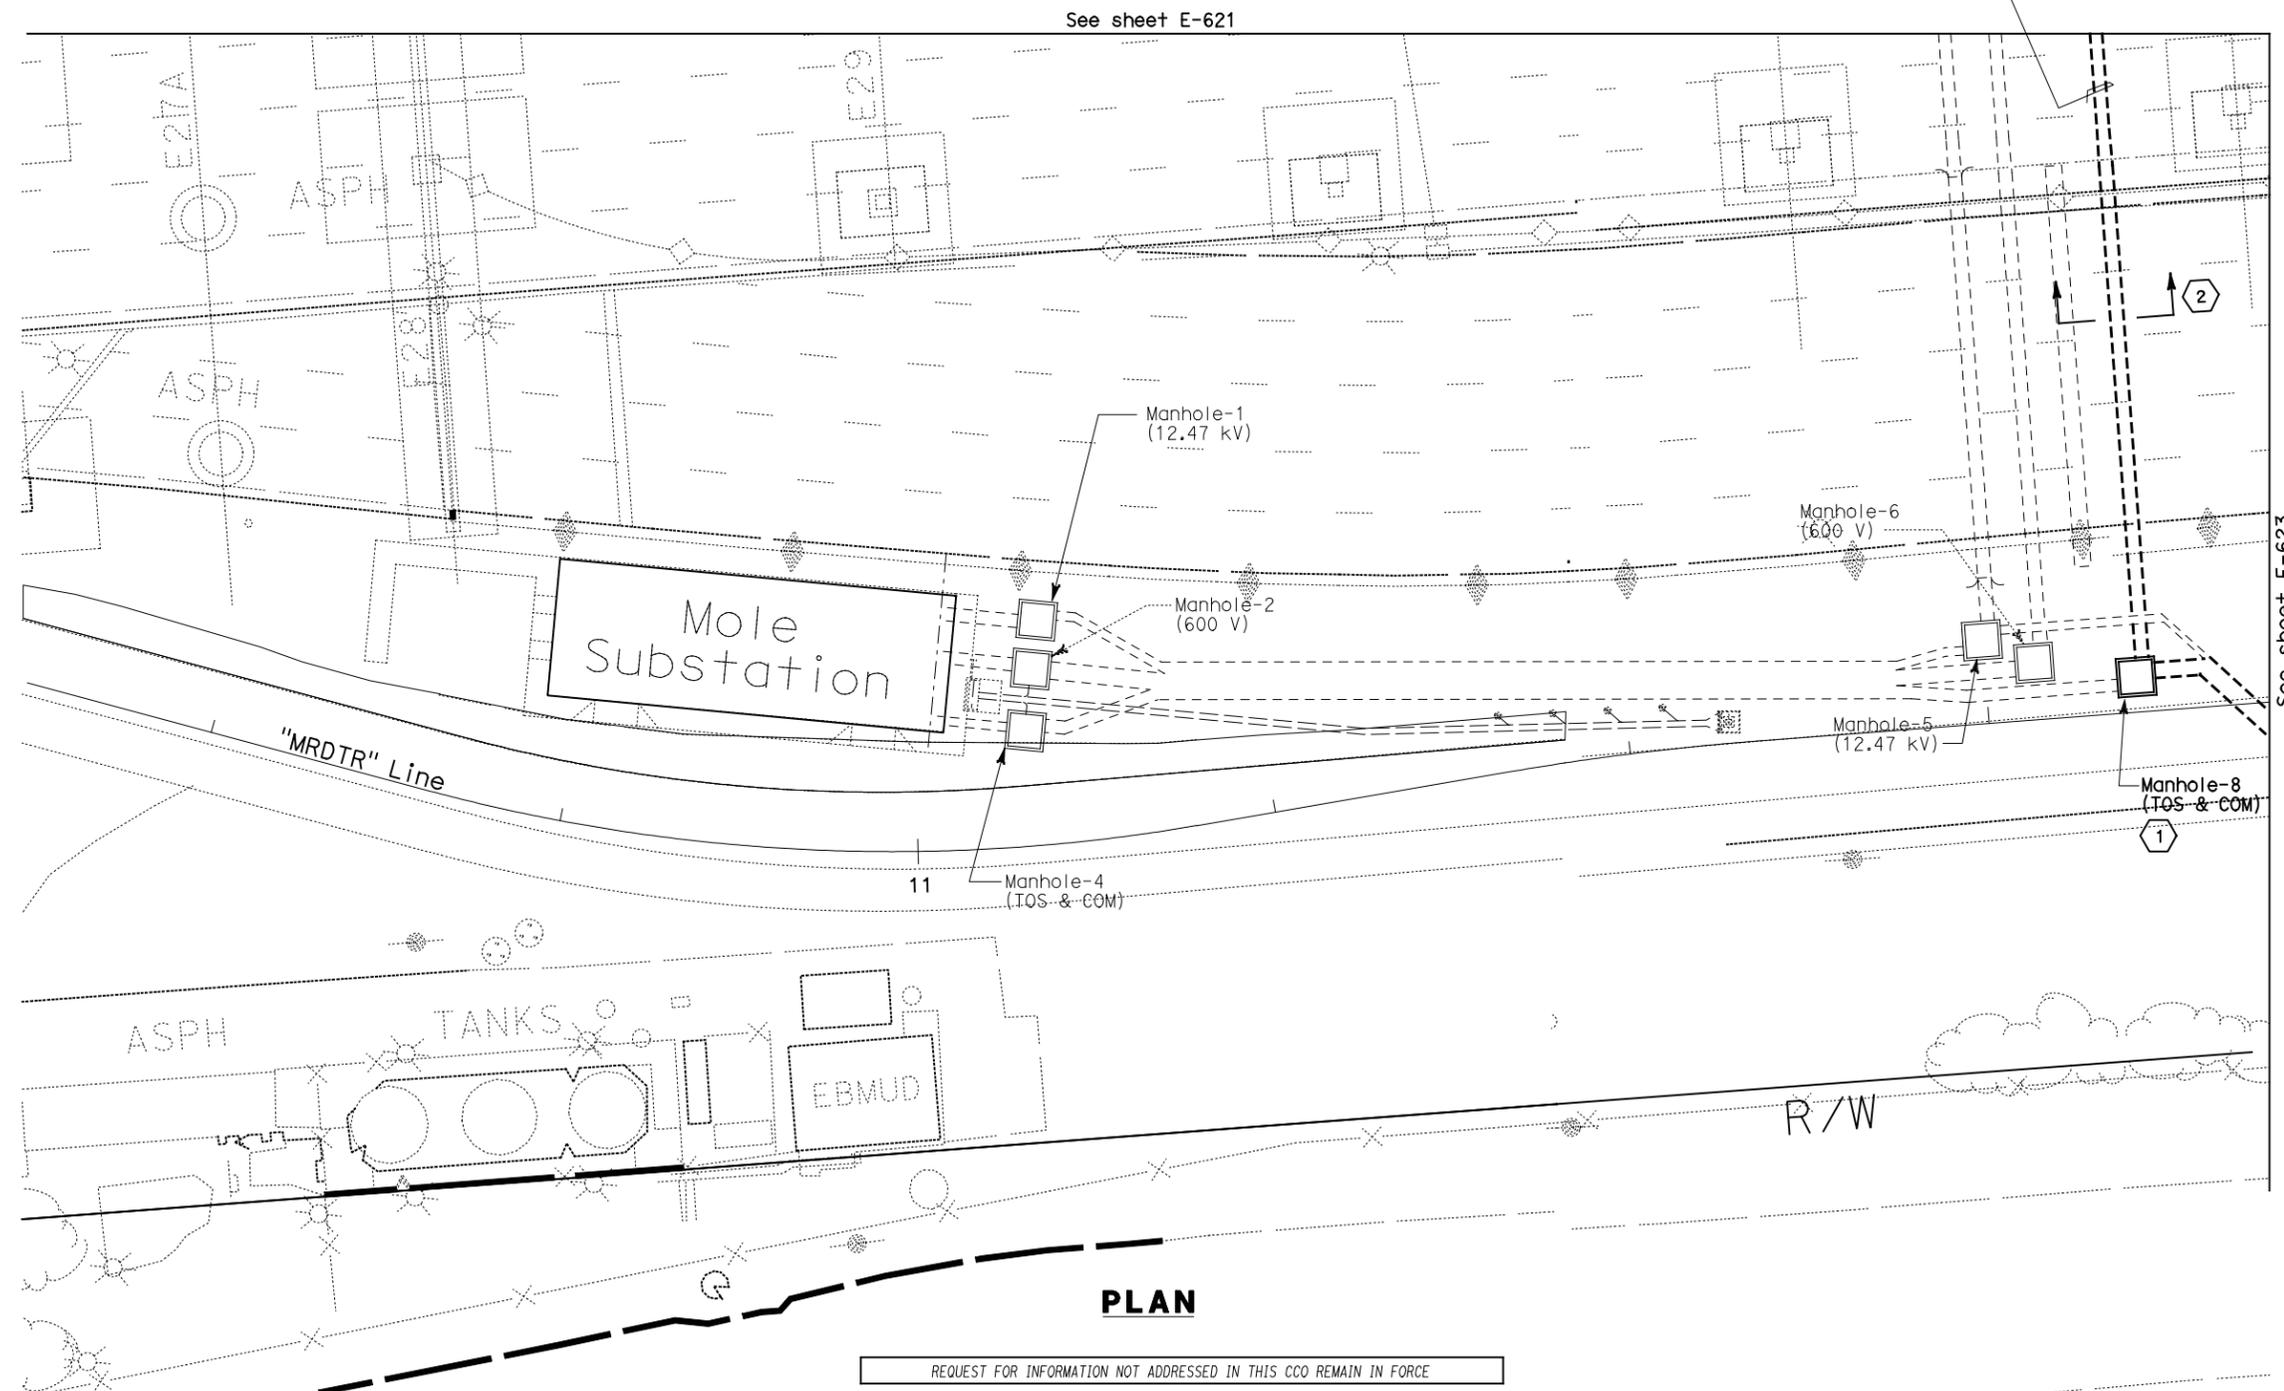

**PLAN**

REQUEST FOR INFORMATION NOT ADDRESSED IN THIS CCO REMAIN IN FORCE

△	03/08/10	MEP INTEGRATION	SYC	FW	110
MARK	DATE	DESCRIPTIONS	BY	CH'D	CCO#
REVISIONS					


CONTRACT CHANGE ORDER NO. \_\_\_\_\_  
 SHEET \_\_\_\_\_ OF \_\_\_\_\_

**BRIDGE STRUCTURES GIRDER WESTBOUND  
 OAKLAND APPROACH STRUCTURES  
 UNDERGROUND**  
 SCALE: 1:200

- NOTES:**
- This plan sheet is a record drawing from Oakland Touchdown 1 contract. The Contractor shall verify the existing installation. See sheet E-80 of Oakland Touchdown 1, contract No. 04-0120L4.
  - The installed components shall not be limited to the ones listed below, but shall be a complete installation. For details, see Bridge Structures Girder Westbound, typical Details sheets.
    - Furnish and install (4) one-inch inner-ducts with TOS fiber optic cables in one inner-duct, into existing conduit shown on this drawing. Refer to riser diagram on sheets E-978 through E-981 and detail on E-973.
  - All conduits shown on this drawing are existing. Bold ones are to be use for pulling cable.
- SHEET NOTES:**
- For details on racking TOS fiber inside manhole, see E-663A, Detail 3.
  - Cross section reference for conduit configuration.

THIS PLAN ACCURATE FOR ELECTRICAL WORK ONLY.

ALL DIMENSIONS ARE IN METERS UNLESS OTHERWISE SHOWN

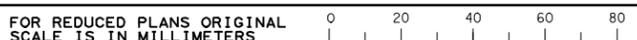

DGN FILE => 04-0120f1\_E-622.dgn  
 USERNAME => ilorico

CU 04251 EA 0120F1

**E-622**

DATE PLOTTED => 06-MAY-2010  
 TIME PLOTTED => 18:04  
 LAST REVISION 00-00-00