

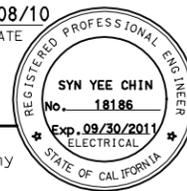


DIST	COUNTY	ROUTE	KILOMETER TOTAL PROJECT	POST TOTAL PROJECT	SHEET No	TOTAL SHEETS
04	SF, Alameda	80	12.2/14.3	0.0/4.0	407a	1204
					REGISTERED ELECTRICAL ENGINEER Syn Yee Chin DATE: 03/08/10	
PLANS APPROVAL DATE: 05-06-2010						
PB AMERICAS, Inc. A Parsons Brinckerhoff Company 303 Second St., Suite 700N San Francisco, CA 94107-1317						
<i>The State of California or its officers or agents shall not be responsible for the accuracy or completeness of electronic copies of this plan sheet.</i>						
Caltrans now has a web site! To get to the web site, go to http://www.dot.ca.gov						

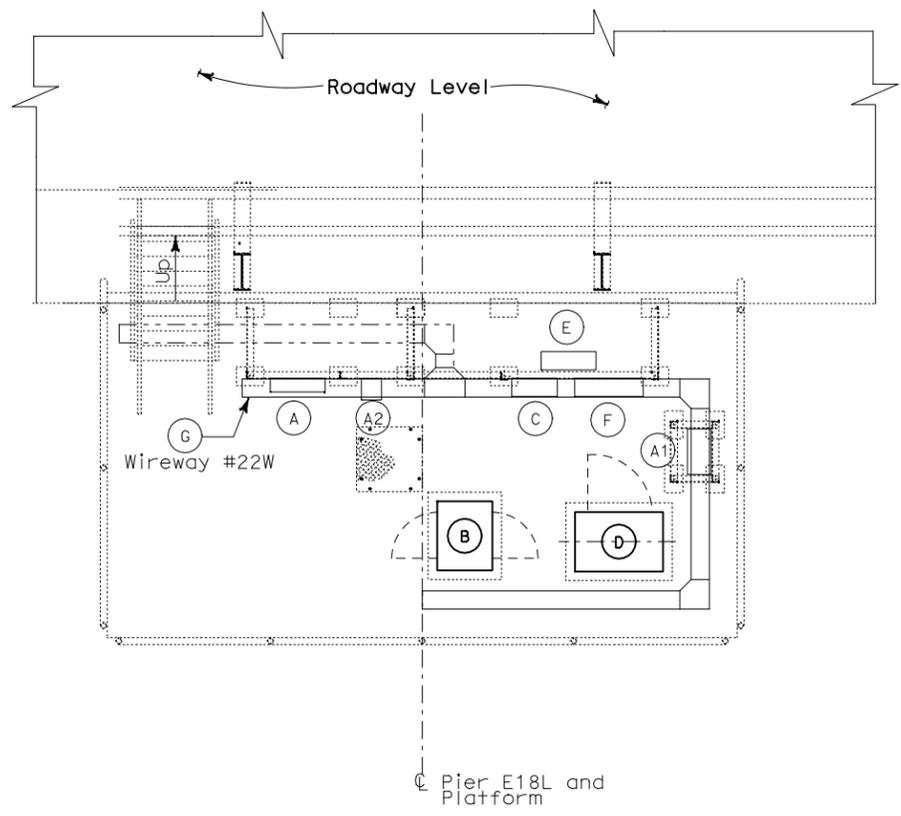

**SERVICE PLATFORM #22W
EQUIPMENT ARRANGEMENT PLAN**
SCALE 1:40

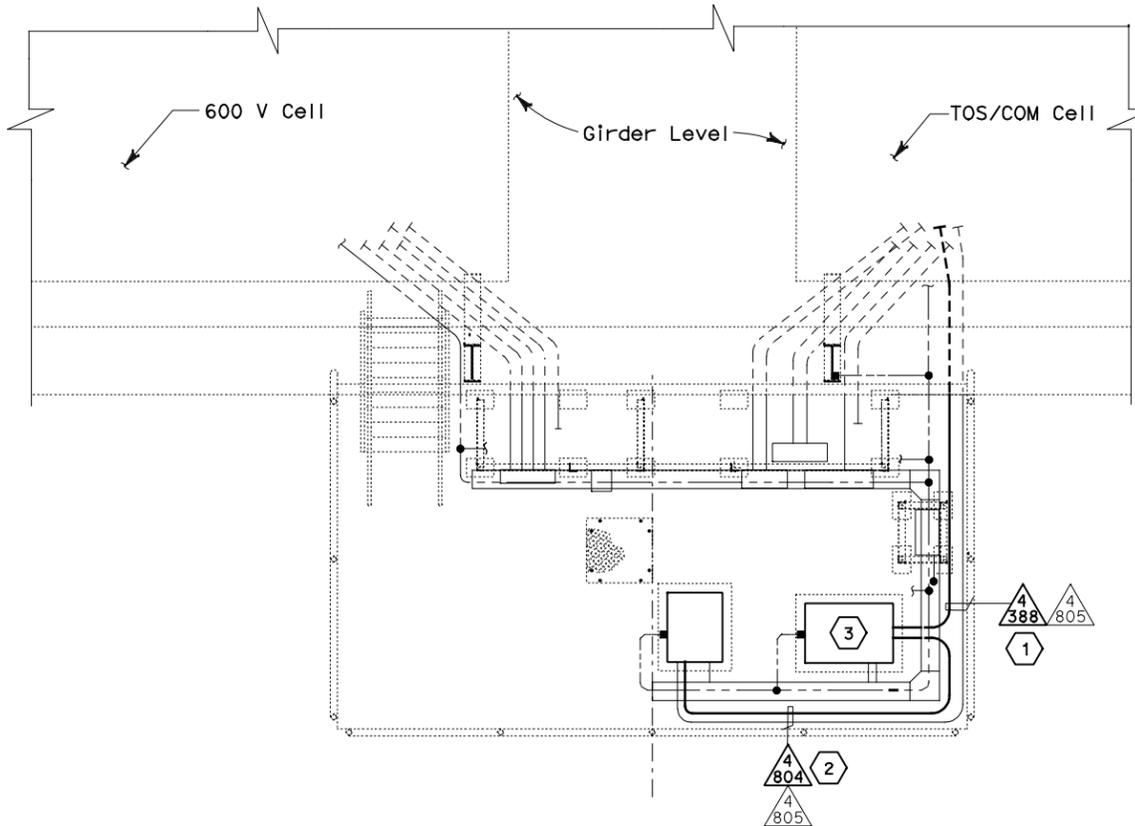

CONDUIT AND GROUNDING PLAN
SCALE 1:40

REVISOR	DATE	REVISION

DESIGNED BY	CHECKED BY
BEHZAD GOLEMOHAMMADI	

STATE OF CALIFORNIA - DEPARTMENT OF TRANSPORTATION
Caltrans

NOTES:

- This plan sheet is a record drawing from Oakland Touchdown 1 contract. The Contractor shall verify the existing installation. See sheet E-20 from Oakland Touchdown 1, contract No. 04-0120L4.
- The installed components shall not be limited to the ones listed below, but shall be a complete installation. For details, see Bridge Structures Girder Westbound, typical Details sheets.
 - Furnish and install TOS fiber optic cables into existing conduits shown on this drawing. See sheets E-978 through E-981.
- All conduits and equipment shown on this drawing are existing. Bold ones are to be used for pulling cable.

SHEET NOTES:

- Furnish and install TOS fiber optic cables into existing conduit. Pull a 72 fiber and terminate in the splice closure inside TOS Splice Cabinet. See sheets E-980, E-981, and E-982.
- Furnish and install 12 fiber optic cables from Fiber Optic Splice Closure to Controller Cabinet. Coil 3m of cable inside Controller Cabinet for connection by others. The coiled end of the fiber optic cables shall be terminated with mated connectors. See sheets E-972 and E-973.
- Furnish and install Fiber Splice Closure in existing TOS Splice Cabinet.

EQUIPMENT SCHEDULE:

- (A) Utility Panel UP-171
208/120 V, 3 Phase, 4 wire (NEMA 4X)
Size: 914 H x 610 W x 152 D. (PB-8A)
- (A1) 15 KVA Transformer, 3 Phase, 4 wire
480V - 208/120 V, 60 Hz, (NEMA 4X)
Size: 762 H x 584 W x 419 D
- (A2) Enclosed molded case circuit breaker, (NEMA 4X)
Size: 506 H x 225 W x 237 D
- (B) Controller Cabinet #TOS-22WA
Size: 1625 H x 615 W x 768 D
- (C) Telephone Terminal Box #TEL-22W (PB-7C)
Size: 762 H x 508 W x 203 D
- (D) TOS splice cabinet #TOS-22WS with Fiber Splice Closure #FSC-22W inside (Refer to TOS sheet E-972)
Size: 1400 H x 980 W x 660 D
- (E) PB-2B for TOS/COM, mounted on panel rack
Size: 762 H x 610 W x 203 D
- (F) SCADA Communication Terminal Box #COM-22W (PB-7B)
Size: 762 H x 762 W x 203 D
- (G) 600 V, Wireway (NEMA 4X)
Size: 203 H x 203 W

REQUEST FOR INFORMATION NOT ADDRESSED IN THIS CCO REMAIN IN FORCE				
△	03/08/10	MEP INTEGRATION	SYC	FW 110
MARK	DATE	DESCRIPTIONS	BY	CH'D CCO#
REVISIONS				


CONTRACT CHANGE ORDER NO. _____
 SHEET _____ OF _____

DETAILS
BRIDGE STRUCTURES GIRDER WESTBOUND
OAKLAND APPROACH STRUCTURES-SERVICE PLATFORM #22W
 SCALE AS NOTED

E-658

THIS PLAN ACCURATE FOR ELECTRICAL WORK ONLY.

ALL DIMENSIONS ARE IN METERS UNLESS OTHERWISE SHOWN

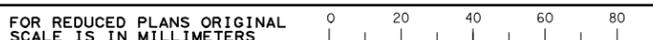

DGN FILE => 04-0120f1_E-658.dgn
 USERNAME => ilorico

CU 04251

EA 0120F1

DATE PLOTTED => 06-MAY-2010
 TIME PLOTTED => 18:08
 LAST REVISION 00-00-00