





DIST	COUNTY	ROUTE	KILOMETER TOTAL PROJECT	POST TOTAL PROJECT	SHEET No	TOTAL SHEETS
04	SF, Ala	80	12.2/14.3	0.0/4.0	407a	1204
REGISTERED ELECTRICAL ENGINEER SYN YEE CHIN No. 18186 Exp. 09/30/2011 STATE OF CALIFORNIA					03/08/10 DATE	
05-06-2010 PLANS APPROVAL DATE						
PB AMERICAS, Inc. A Parsons Brinckerhoff Company 303 Second St., Suite 700N San Francisco, CA 94107-1317						
The State of California or its officers or agents shall not be responsible for the accuracy or completeness of electronic copies of this plan sheet.						
Caltrans now has a web site! To get to the web site, go to http://www.dot.ca.gov						

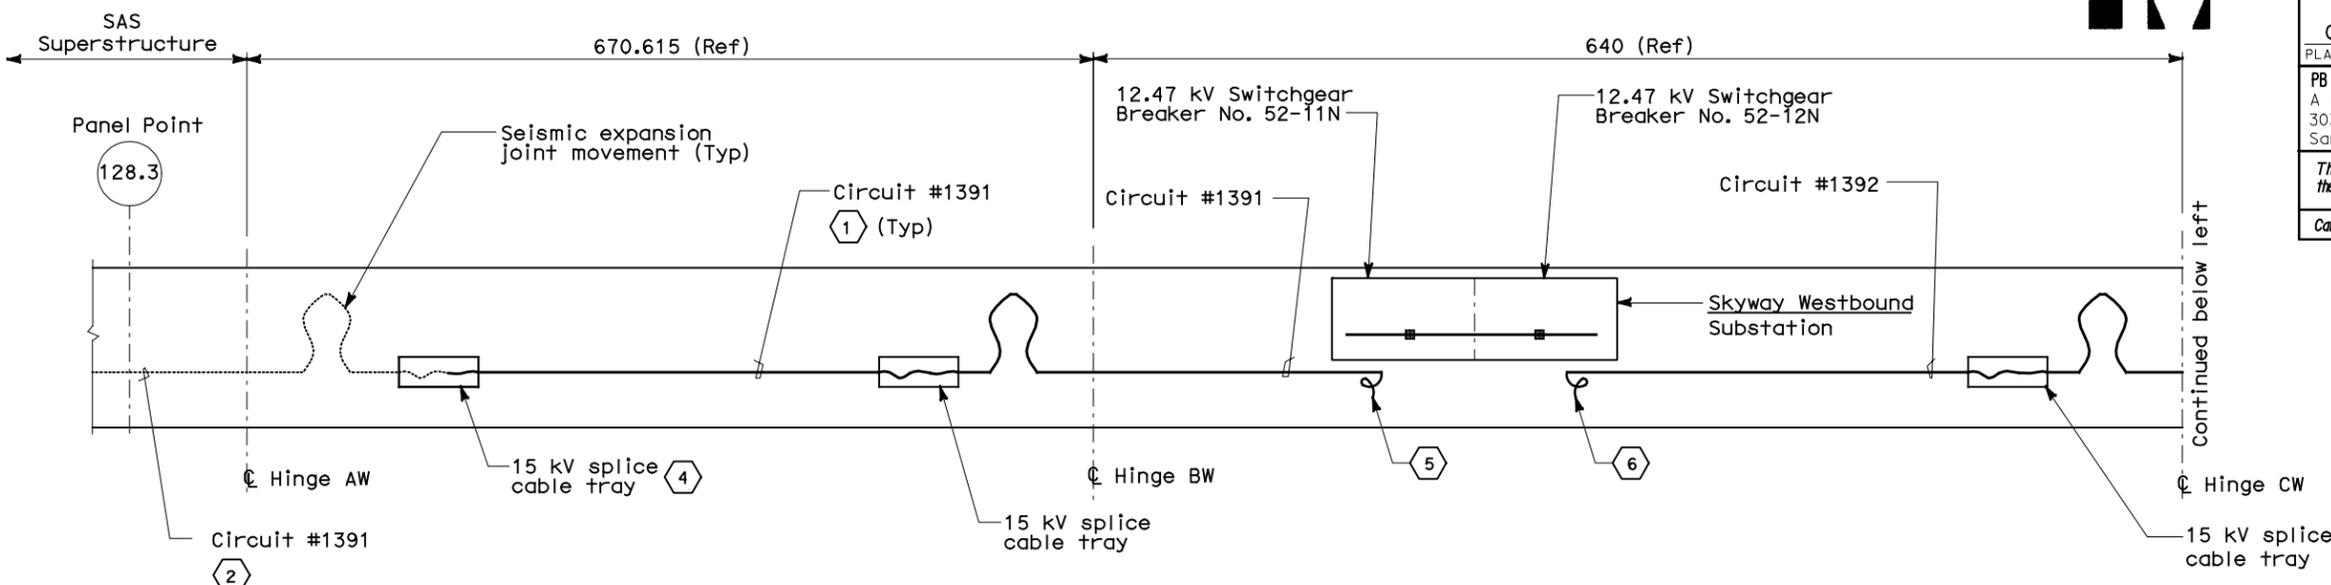

SKYWAY STRUCTURES

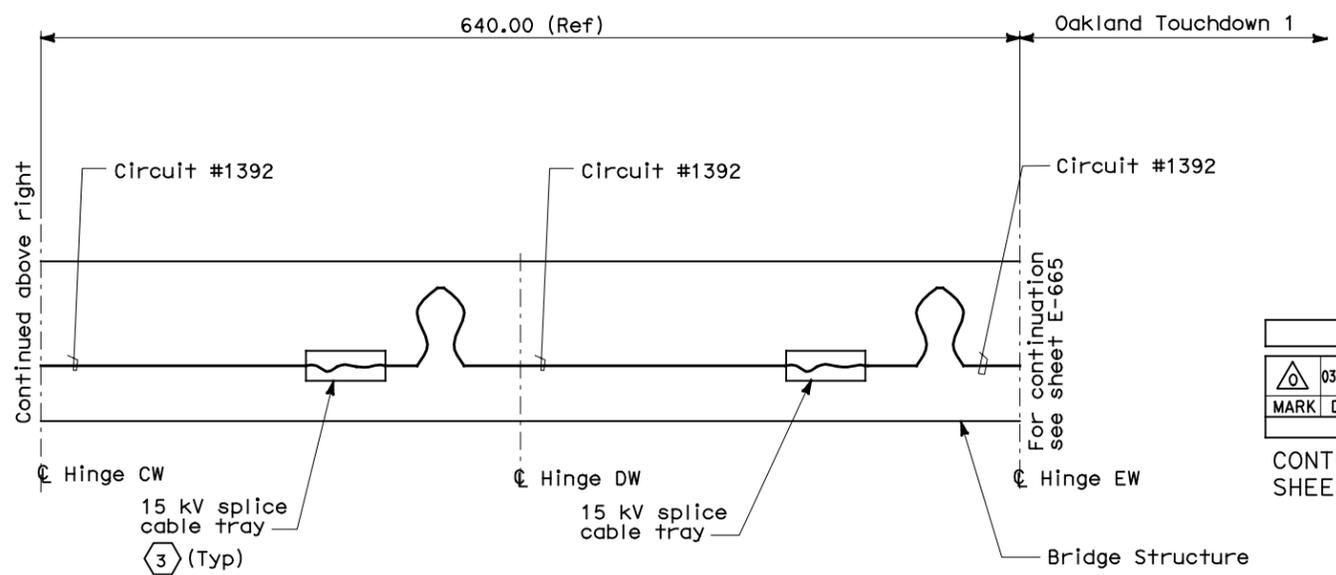

SKYWAY STRUCTURES

SHEET NOTES:

- 1 Contractor to furnish and install the cables. The 15 kV cable tray and conduits was installed under Skyway Structures contract.
- 2 Cables to be installed by others.
- 3 Contractor to splice the 15 kV cables in the 15 kV splice cable tray.
- 4 Contractor to splice 15 kV cables for tie-in with 15 kV cables from SAS Superstructure.
- 5 Contractor to coil 25 m cable length for future terminations to 12.47 kV switchgear. See sheet E-644.
- 6 Contractor to coil 45 m cable length for future terminations to 12.47 kV switchgear. See sheet E-644.

REQUEST FOR INFORMATION NOT ADDRESSED IN THIS CCO REMAIN IN FORCE						
△	03/08/10	MEP INTEGRATION	SYC	FW	110	
MARK	DATE	DESCRIPTIONS	BY	CH'D	CCO#	
REVISIONS						


CONTRACT CHANGE ORDER NO. _____
SHEET _____ OF _____

DETAILS
BRIDGE STRUCTURES GIRDER WESTBOUND
SKYWAY STRUCTURES WB-15 KV RISER DIAGRAM
NO SCALE

E-664

THIS PLAN ACCURATE FOR ELECTRICAL WORK ONLY.

ALL DIMENSIONS ARE IN METERS UNLESS OTHERWISE SHOWN

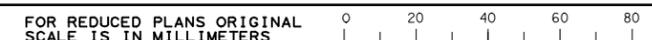

DGN FILE => 04-0120f1_E-664.dgn
USERNAME => llorico

CU 04251

EA 0120F1

DATE PLOTTED => 06-MAY-2010
TIME PLOTTED => 18:09
LAST REVISION
00-00-00

STATE OF CALIFORNIA - DEPARTMENT OF TRANSPORTATION
 DESIGN OVERSIGHT
 BEHZAD GOLEMOHAMMADI
 CALCULATED/DESIGNED BY
 CHECKED BY
 DATE REVISOR BY
 DATE REVISOR BY
 DATE REVISOR BY