


STATE OF CALIFORNIA - DEPARTMENT OF TRANSPORTATION
Caltrans

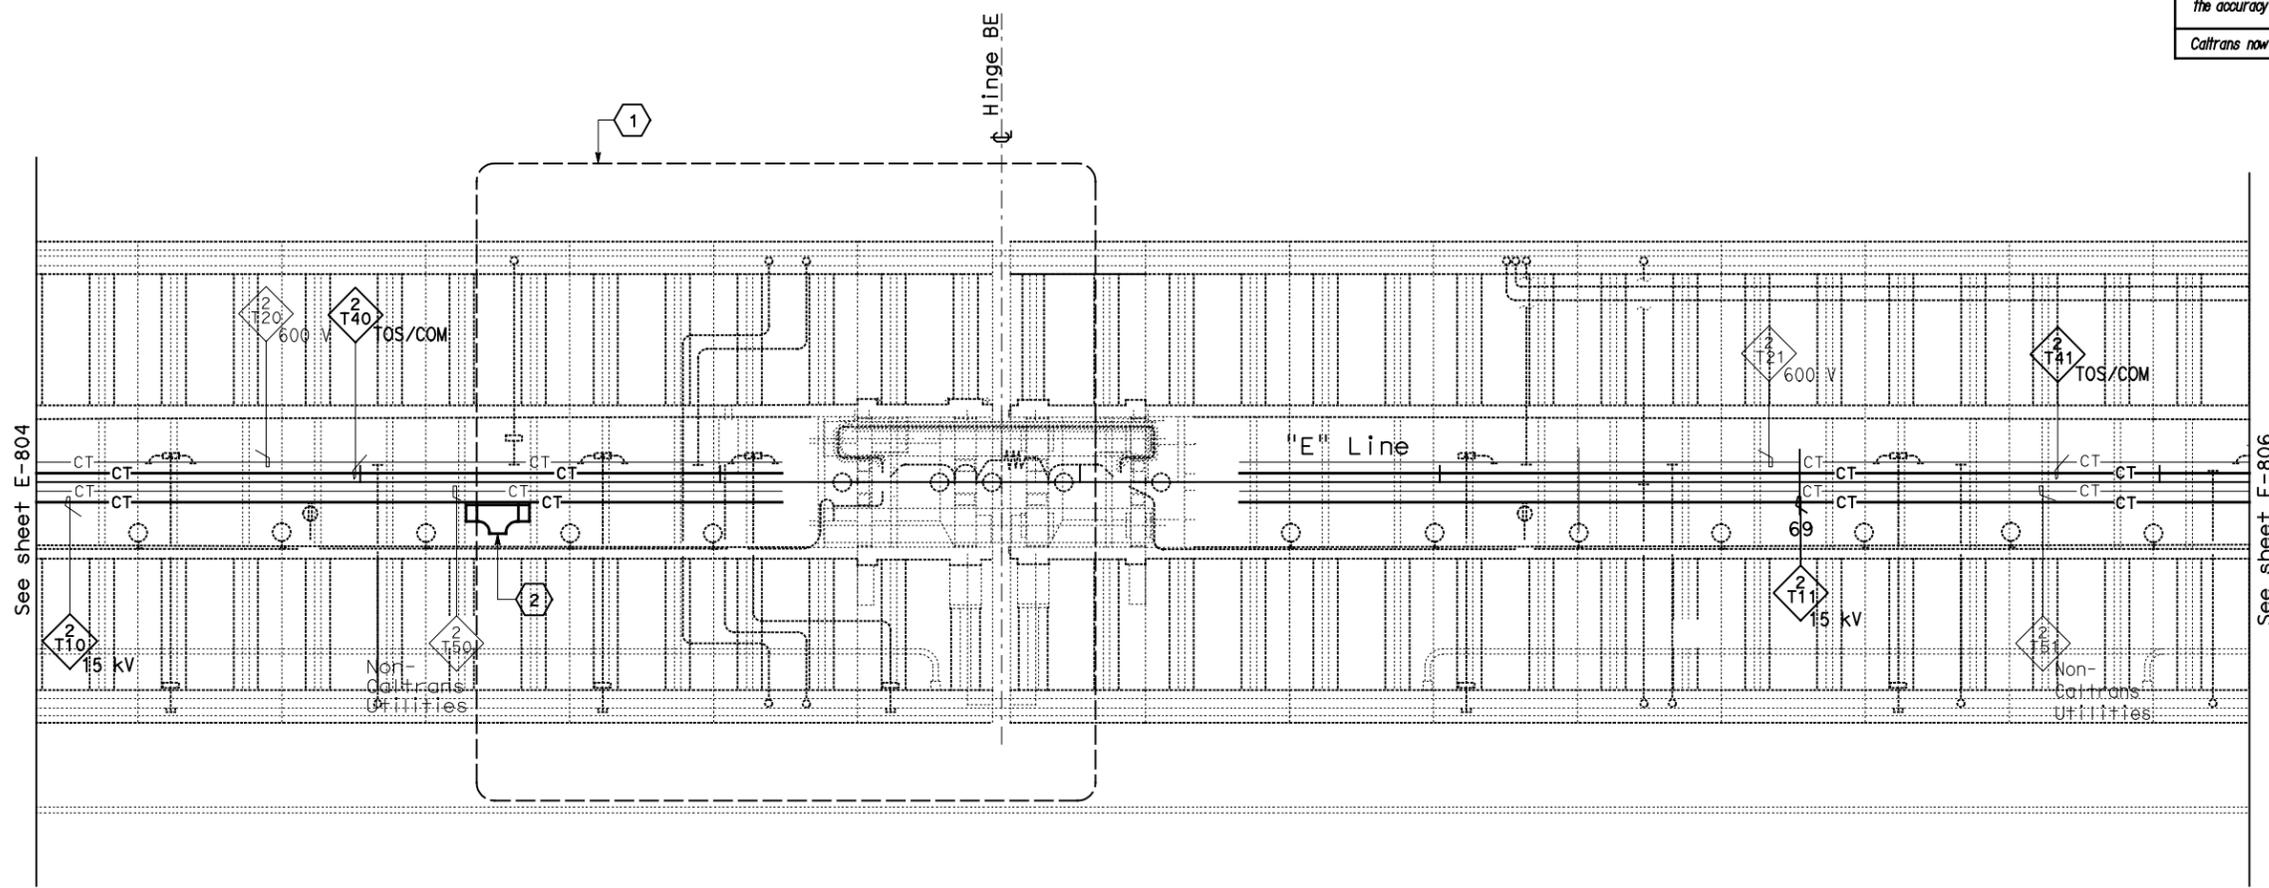

CONDUIT AND CABLE TRAY PLAN

NOTES:

1. This plan sheet is a record drawing from Skyway Structures contract. The Contractor shall verify the existing installation. See sheet EE-86 of Skyway Structures Contract No. 04-012024.
2. The installed components shall not be limited to the ones listed below, but shall be a complete installation. For details, see Bridge Structures Girder Eastbound, typical Details sheets.
 - Furnish and install 15 kV cables into existing cable tray shown on this drawing. Refer to riser diagram on E-837.
 - Furnish and install TOS fiber optic cables into existing cable tray shown on this drawing. Refer to riser diagram on E-983.
 - Inspect for system ground continuity. See sheets E-839 and E-840.
3. All cable trays shown on this drawing are existing. Bold ones are to be used for pulling cable.

SHEET NOTES:

- 1 For Hinge BE area details, see sheet E-823A.
- 2 Furnish and install splice cable tray as shown on sheet E-836, plan detail 1.

REQUEST FOR INFORMATION NOT ADDRESSED IN THIS CCO REMAIN IN FORCE					
△	03/08/10	MEP INTEGRATION	SYC	FW	110
MARK	DATE	DESCRIPTIONS	BY	CH'D	CCO#
REVISIONS					

CONTRACT CHANGE ORDER NO. _____
 SHEET _____ OF _____


**BRIDGE STRUCTURES GIRDER EASTBOUND
 SKYWAY STRUCTURES**

SCALE: 1:200

E-805

THIS PLAN ACCURATE FOR ELECTRICAL WORK ONLY.

ALL DIMENSIONS ARE IN METERS UNLESS OTHERWISE SHOWN

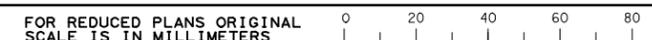

DGN FILE => 04-0120f1_E-805.dgn
 USERNAME => ilorico

CU 04251

EA 0120F1

DIST	COUNTY	ROUTE	KILOMETER TOTAL PROJECT	POST PROJECT	SHEET No	TOTAL SHEETS
04	SF, Ala	80	12.2/14.3	0.0/4.0	407a	1204
					08S06	

Syn Yee Chin 03/08/10
 REGISTERED ELECTRICAL ENGINEER DATE

05-06-2010
 PLANS APPROVAL DATE

PB AMERICAS, Inc.
 A Parsons Brinckerhoff Company
 303 Second St., Suite 700N
 San Francisco, CA 94107-1317

The State of California or its officers or agents shall not be responsible for the accuracy or completeness of electronic copies of this plan sheet.

Caltrans now has a web site! To get to the web site, go to <http://www.dot.ca.gov>

REGISTERED PROFESSIONAL ENGINEER
 SYN YEE CHIN
 No. 18186
 Exp. 09/30/2011
 ELECTRICAL
 STATE OF CALIFORNIA

DATE PLOTTED => 25-MAY-2010
 TIME PLOTTED => 11:18
 LAST REVISION 00-00-00