


STATE OF CALIFORNIA - DEPARTMENT OF TRANSPORTATION
Caltrans
 DESIGN OVERSIGHT
 BEHZAD GOLEMOHAMMADI
 CALCULATED/DESIGNED BY
 CHECKED BY
 DATE 01/10
 REVISED BY
 DATE REVISED

DIST	COUNTY	ROUTE	KILOMETER TOTAL PROJECT	POST PROJECT	SHEET No	TOTAL SHEETS
04	SF, Alameda	80	12.2/14.3	0.0/4.0	407a	1204
REGISTERED ELECTRICAL ENGINEER SYN YEE CHIN 03/08/10 DATE					05-06-2010 PLANS APPROVAL DATE	
PB AMERICAS, Inc. A Parsons Brinckerhoff Company 303 Second St., Suite 700N San Francisco, CA 94107-1317						
The State of California or its officers or agents shall not be responsible for the accuracy or completeness of electronic copies of this plan sheet.						
Caltrans now has a web site! To get to the web site, go to http://www.dot.ca.gov						

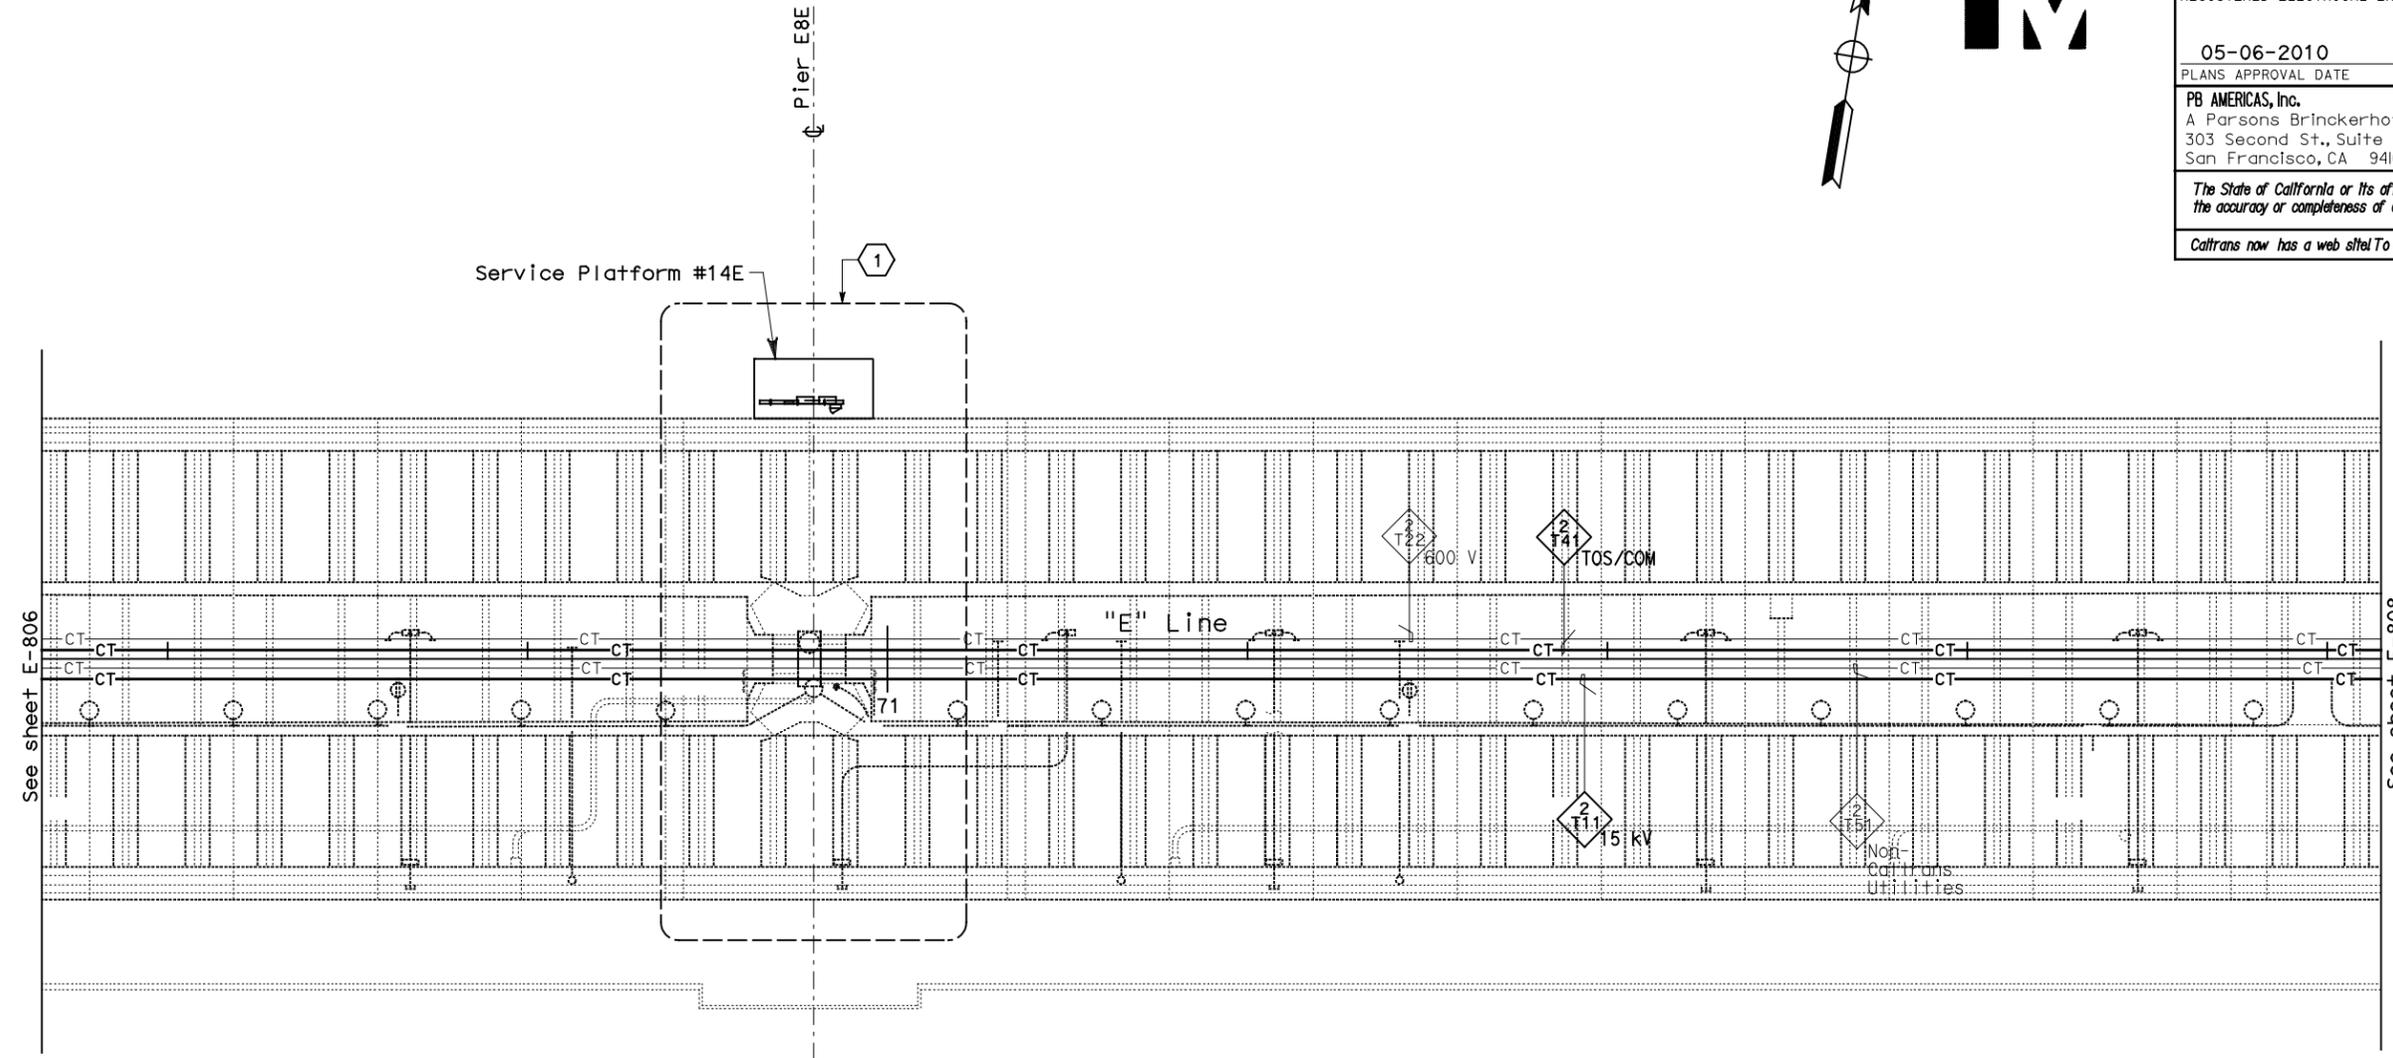

CONDUIT AND CABLE TRAY PLAN

NOTES:

- This plan sheet is a record drawing from Skyway Structures contract. The Contractor shall verify the existing installation. See sheet EE-88 of Skyway Structures Contract No. 04-012024.
- The installed components shall not be limited to the ones listed below, but shall be a complete installation. For details, see Bridge Structures Girder Eastbound, typical Details sheets.
 - Furnish and install 15 kV cables into existing cable tray shown on this drawing. Refer to riser diagram on E-837.
 - Furnish and install TOS fiber optic cables into existing cable tray shown on this drawing. Refer to riser diagram on E-983.
 - Inspect for system ground continuity. See sheets E-839 and E-840.
- All cable trays shown on this drawing are existing. Bold ones are to be used for pulling cable.

SHEET NOTES:

- ① For Service Platform #14E details, see sheet E-827.

REQUEST FOR INFORMATION NOT ADDRESSED IN THIS CCO REMAIN IN FORCE					
△	03/08/10	MEP INTEGRATION	SYC	FW	110
MARK	DATE	DESCRIPTIONS	BY	CH'D	CCO#
REVISIONS					


CONTRACT CHANGE ORDER NO. _____
 SHEET _____ OF _____

**BRIDGE STRUCTURES GIRDER EASTBOUND
 SKYWAY STRUCTURES**
 SCALE: 1:200

E-807

THIS PLAN ACCURATE FOR ELECTRICAL WORK ONLY.

ALL DIMENSIONS ARE IN METERS UNLESS OTHERWISE SHOWN

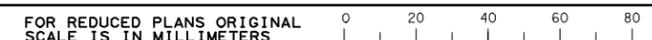

DGN FILE => 04-0120f1_E-807.dgn
 USERNAME => ilorico

CU 04251

EA 0120F1

DATE PLOTTED => 25-MAY-2010
 TIME PLOTTED => 11:18
 LAST REVISION 00-00-00