




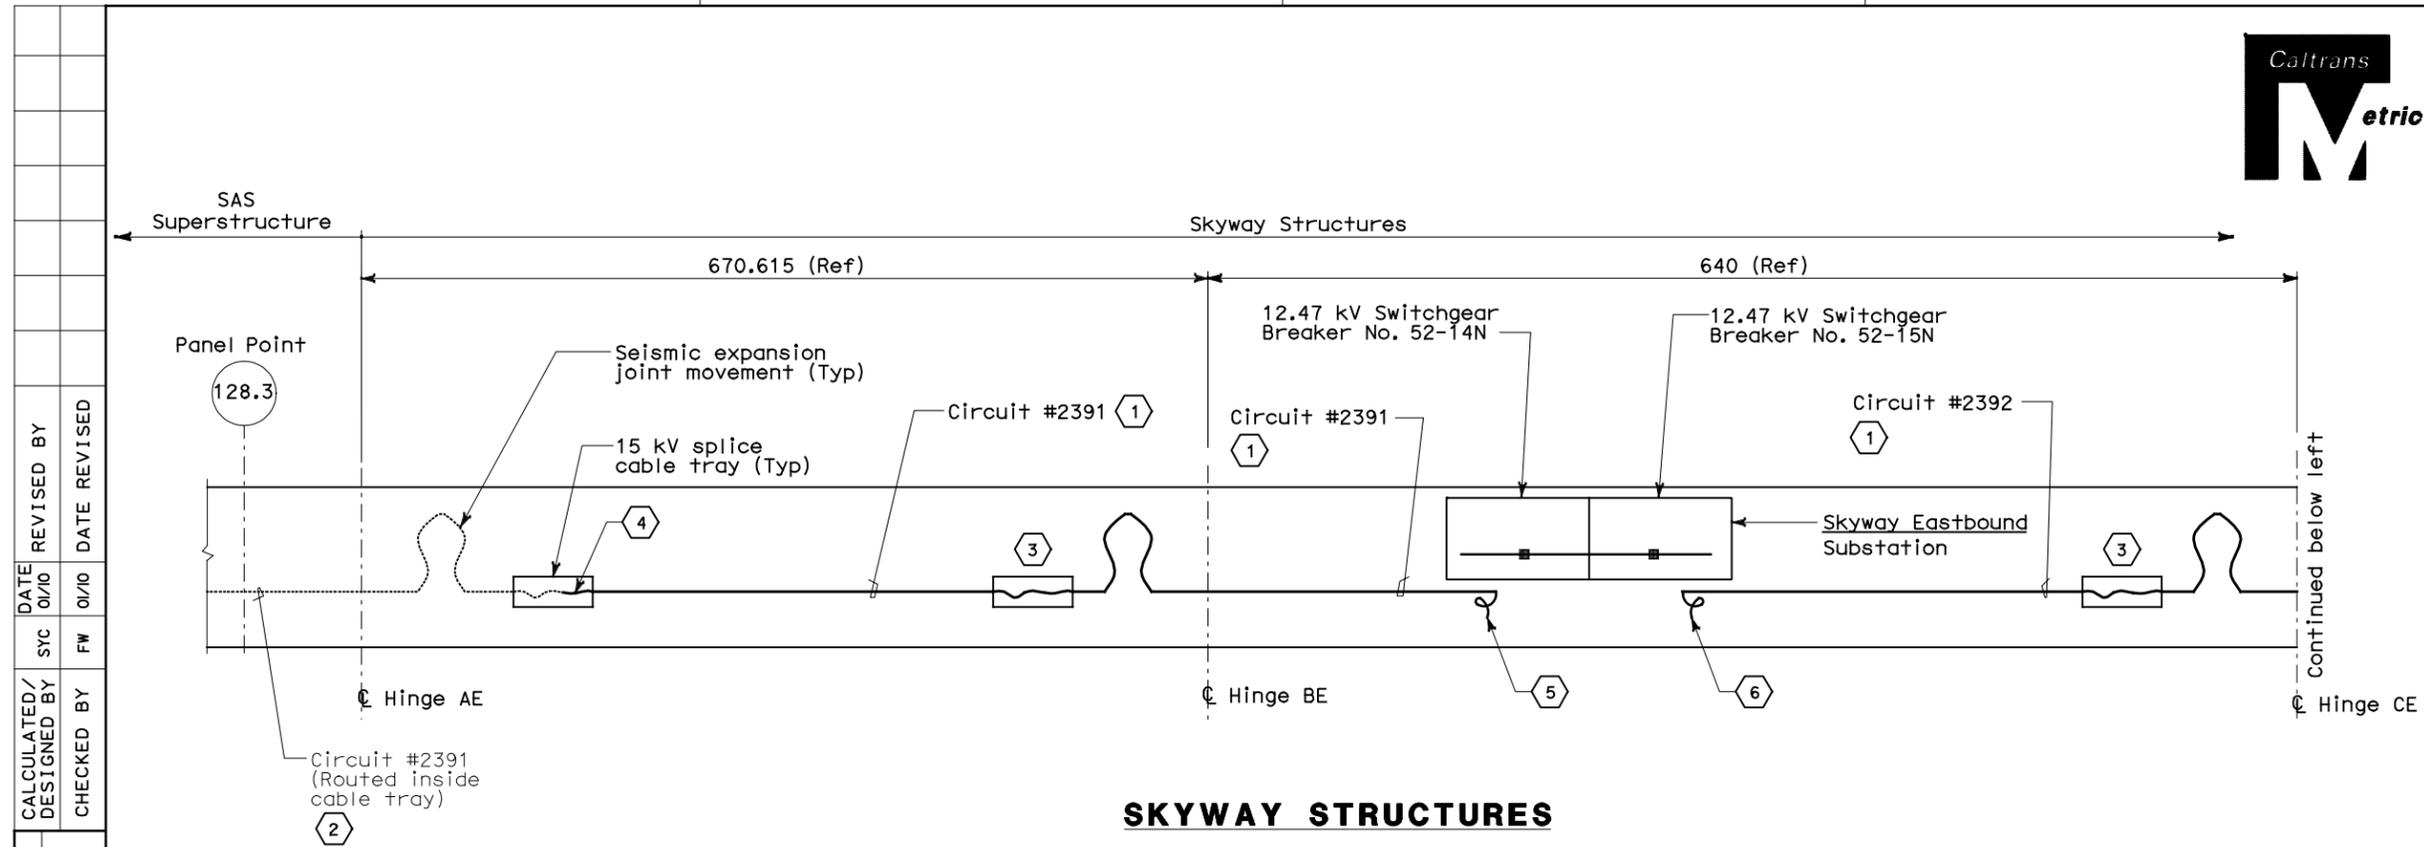

DIST	COUNTY	ROUTE	KILOMETER POST TOTAL PROJECT	SHEET No	TOTAL SHEETS
04	SF, Alameda	80	12.2/14.3 0.0/4.0	407a 08S42	1204
REGISTERED ELECTRICAL ENGINEER			DATE	03/08/10	
SYN YEE CHIN			05-06-2010		
PLANS APPROVAL DATE					
PB AMERICAS, Inc. A Parsons Brinckerhoff Company 303 Second St., Suite 700N San Francisco, CA 94107-1317					
The State of California or its officers or agents shall not be responsible for the accuracy or completeness of electronic copies of this plan sheet.					
Caltrans now has a web site! To get to the web site, go to http://www.dot.ca.gov					

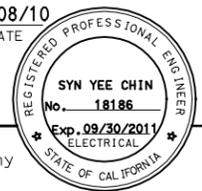

SKYWAY STRUCTURES

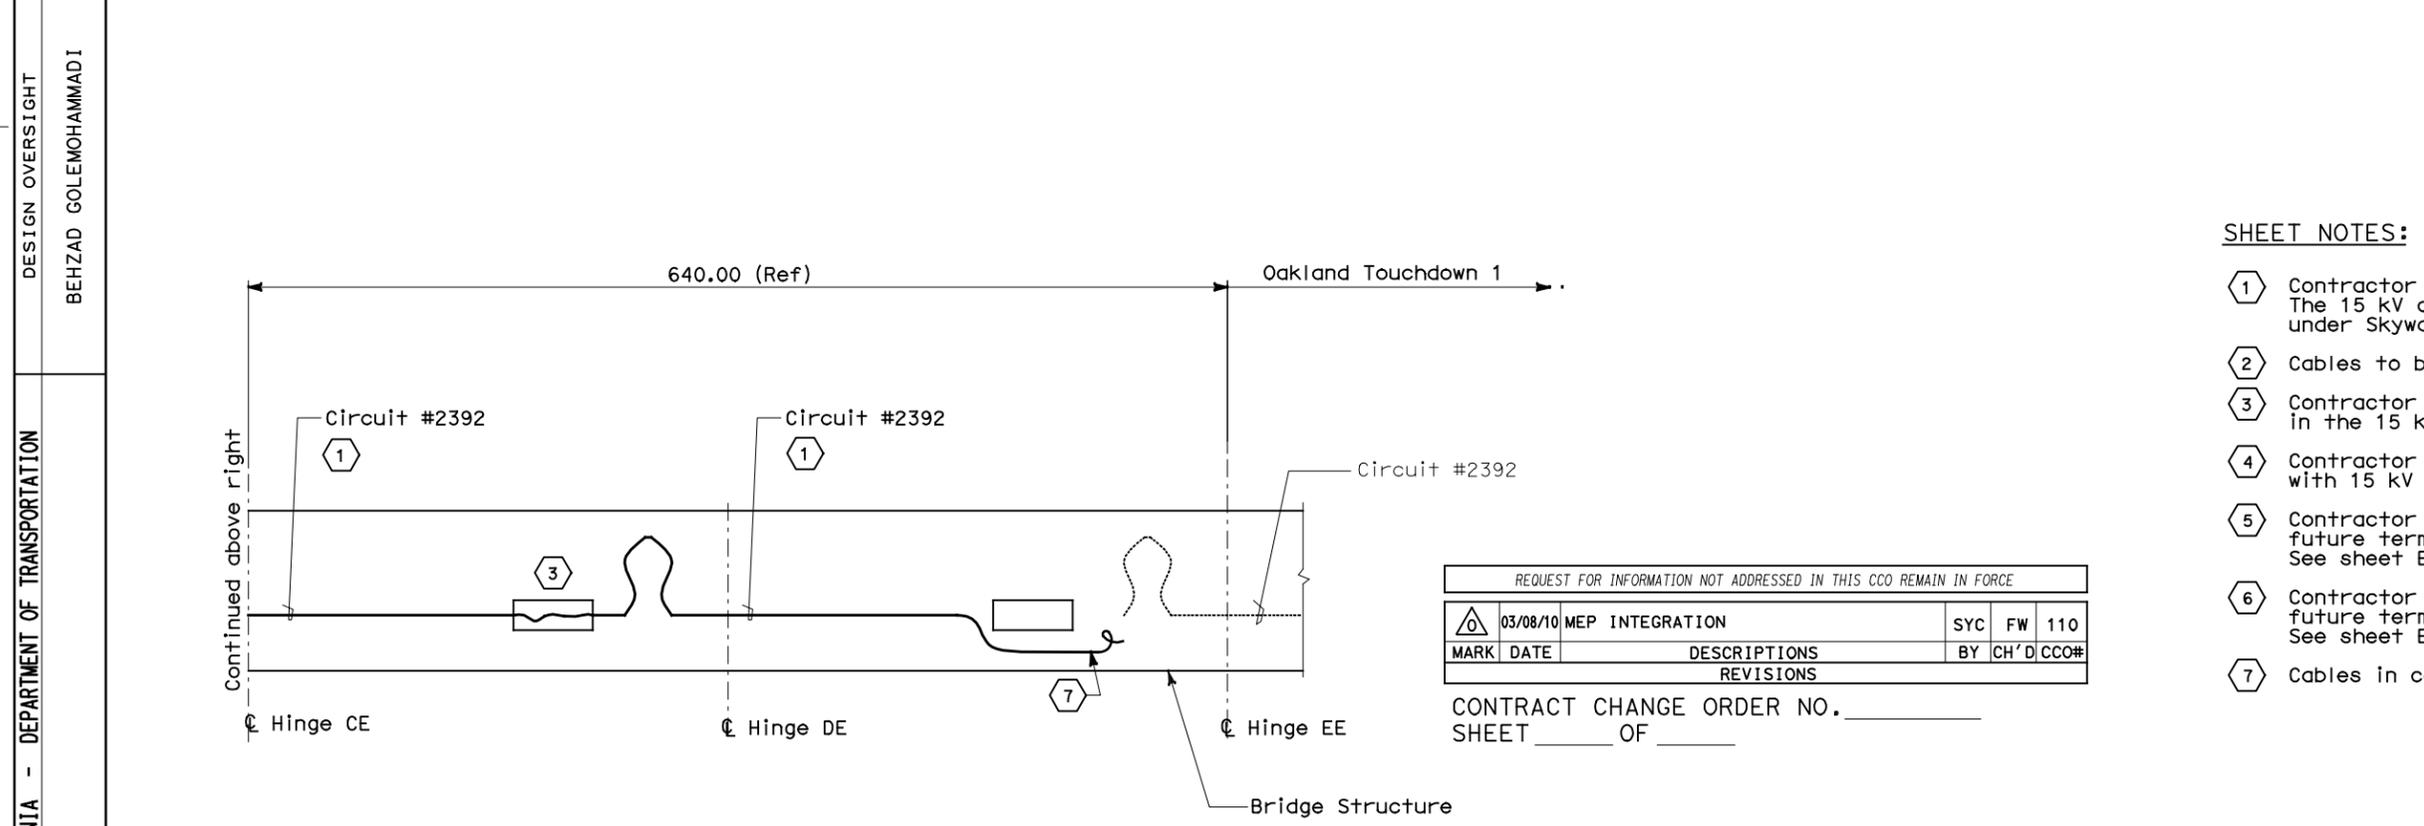

SKYWAY STRUCTURES

SHEET NOTES:

- ① Contractor to furnish and install the cables. The 15 kV cable tray and conduits was installed under Skyway Structures contract.
- ② Cables to be installed by others.
- ③ Contractor to splice the 15 kV cables in the 15 kV splice cable tray.
- ④ Contractor to splice 15 kV cables for tie-in with 15 kV cables from SAS Superstructure.
- ⑤ Contractor to coil 25 m cable length for future terminations to 12.47 kV switchgear. See sheet E-826.
- ⑥ Contractor to coil 45 m cable length for future terminations to 12.47 kV switchgear. See sheet E-826.
- ⑦ Cables in cable tray for splicing by others.

REQUEST FOR INFORMATION NOT ADDRESSED IN THIS CCO REMAIN IN FORCE					
△	03/08/10	MEP INTEGRATION	SYC	FW	110
MARK	DATE	DESCRIPTIONS	BY	CH'D	CCO#
REVISIONS					

CONTRACT CHANGE ORDER NO. _____
SHEET _____ OF _____

DETAILS
BRIDGE STRUCTURES GIRDER EASTBOUND
SKYWAY STRUCTURES EB-15 KV RISER DIAGRAM
NO SCALE

E-837

STATE OF CALIFORNIA - DEPARTMENT OF TRANSPORTATION
Caltrans


DESIGNED BY: BEHZAD GOLEMOHAMMADI
CHECKED BY: _____
DATE DESIGNED: _____
DATE CHECKED: _____

DESIGN OVERSIGHT: BEHZAD GOLEMOHAMMADI

REVISIONS: _____
DATE: _____
BY: _____

THIS PLAN ACCURATE FOR ELECTRICAL WORK ONLY.

ALL DIMENSIONS ARE IN METERS UNLESS OTHERWISE SHOWN

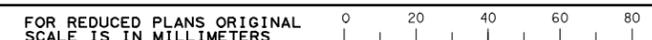

DGN FILE => 04-0120f1_E-837.dgn
USERNAME => ilorico

CU 04251

EA 0120F1

DATE PLOTTED => 06-MAY-2010
TIME PLOTTED => 18:27
LAST REVISION: 00-00-00