





DIST	COUNTY	ROUTE	KILOMETER TOTAL PROJECT	POST PROJECT	SHEET No	TOTAL SHEETS
04	SF, Alameda	80	12.2/14.3	0.0/4.0	407a	1204
Syn Yee Chin REGISTERED ELECTRICAL ENGINEER					DATE	
05-06-2010 PLANS APPROVAL DATE						
PB AMERICAS, Inc. A Parsons Brinckerhoff Company 303 Second St., Suite 700N San Francisco, CA 94107-1317						
The State of California or its officers or agents shall not be responsible for the accuracy or completeness of electronic copies of this plan sheet.						
Caltrans now has a web site! To get to the web site, go to <a href="http://www.dot.ca.gov">http://www.dot.ca.gov</a>						

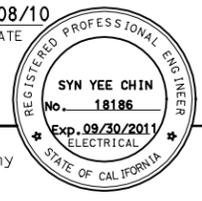

- NOTES:**
- This plan sheet is a record drawing of the Skyway Structures Remote Terminal Unit No. 12W. The Contractor shall verify the existing installation. See sheet EE-349 from the Skyway Structures, contract No. 04-012024.
  - References:  
Refer to Sheet E-905.

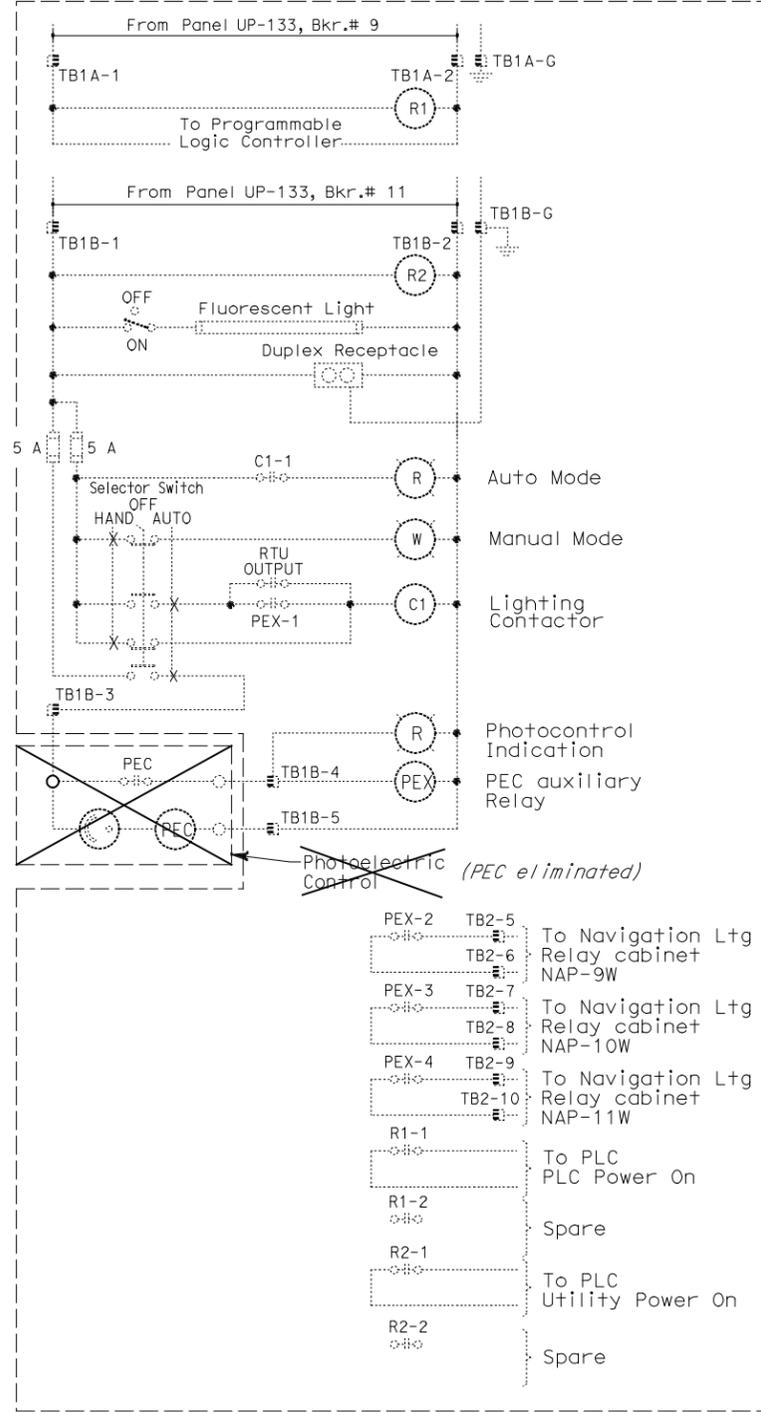

REQUEST FOR INFORMATION NOT ADDRESSED IN THIS CCO REMAIN IN FORCE


MARK	DATE	DESCRIPTIONS	BY	CH'D	CCO#
△	03/08/10	MEP INTEGRATION	JE	FW	110
REVISIONS					

CONTRACT CHANGE ORDER NO. \_\_\_\_\_  
 SHEET \_\_\_\_\_ OF \_\_\_\_\_

**DETAILS**  
**SCADA REMOTE TERMINAL UNIT SYSTEM**  
**RTU #12W ELEMENTARY DIAGRAM**  
 NO SCALE

**E-906A**

THIS PLAN ACCURATE FOR ELECTRICAL WORK ONLY.

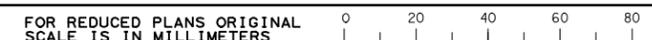

DGN FILE => 04-0120f1\_E-906A.dgn  
 USERNAME => llorico

CU 04251

EA 0120F1

DATE PLOTTED => 25-MAY-2010  
 TIME PLOTTED => 15:09  
 LAST REVISION  
 00-00-00