

| | | | | | | |
|------|-------------|-------|-------------------------|------------|----------|--------------|
| DIST | COUNTY | ROUTE | KILOMETER TOTAL PROJECT | POST TOTAL | SHEET No | TOTAL SHEETS |
| 04 | SF, Alameda | 80 | 13.2 / 13.9 | 193502 | 1204 | |

10/28/10
 REGISTERED ELECTRICAL ENGINEER DATE

SYN YEE CHIN
 No. 18186
 Exp. 09/30/2011
 ELECTRICAL
 STATE OF CALIFORNIA

PLANS APPROVAL DATE _____

PB AMERICAS, Inc.
 A Parsons Brinckerhoff Company
 303 Second St., Suite 700N
 San Francisco, CA 94107-1317


The State of California or its officers or agents shall not be responsible for the accuracy or completeness of electronic copies of this plan sheet.

Caltrans now has a web site. To get to the web site, go to <http://www.dot.ca.gov>

| | | |
|---------|------|----------|
| REVISOR | DATE | REVISION |
| | | |
| | | |
| | | |

| | |
|------------------|----------------------|
| DESIGN OVERSIGHT | BEHZAD GOLEMOHAMMADI |
| CHECKED BY | |
| DESIGNED BY | |
| DATE | |
| REVISOR | |
| DATE | |
| REVISION | |

| | |
|--|--|
| STATE OF CALIFORNIA - DEPARTMENT OF TRANSPORTATION | |
| | |
| | |
| | |
| | |

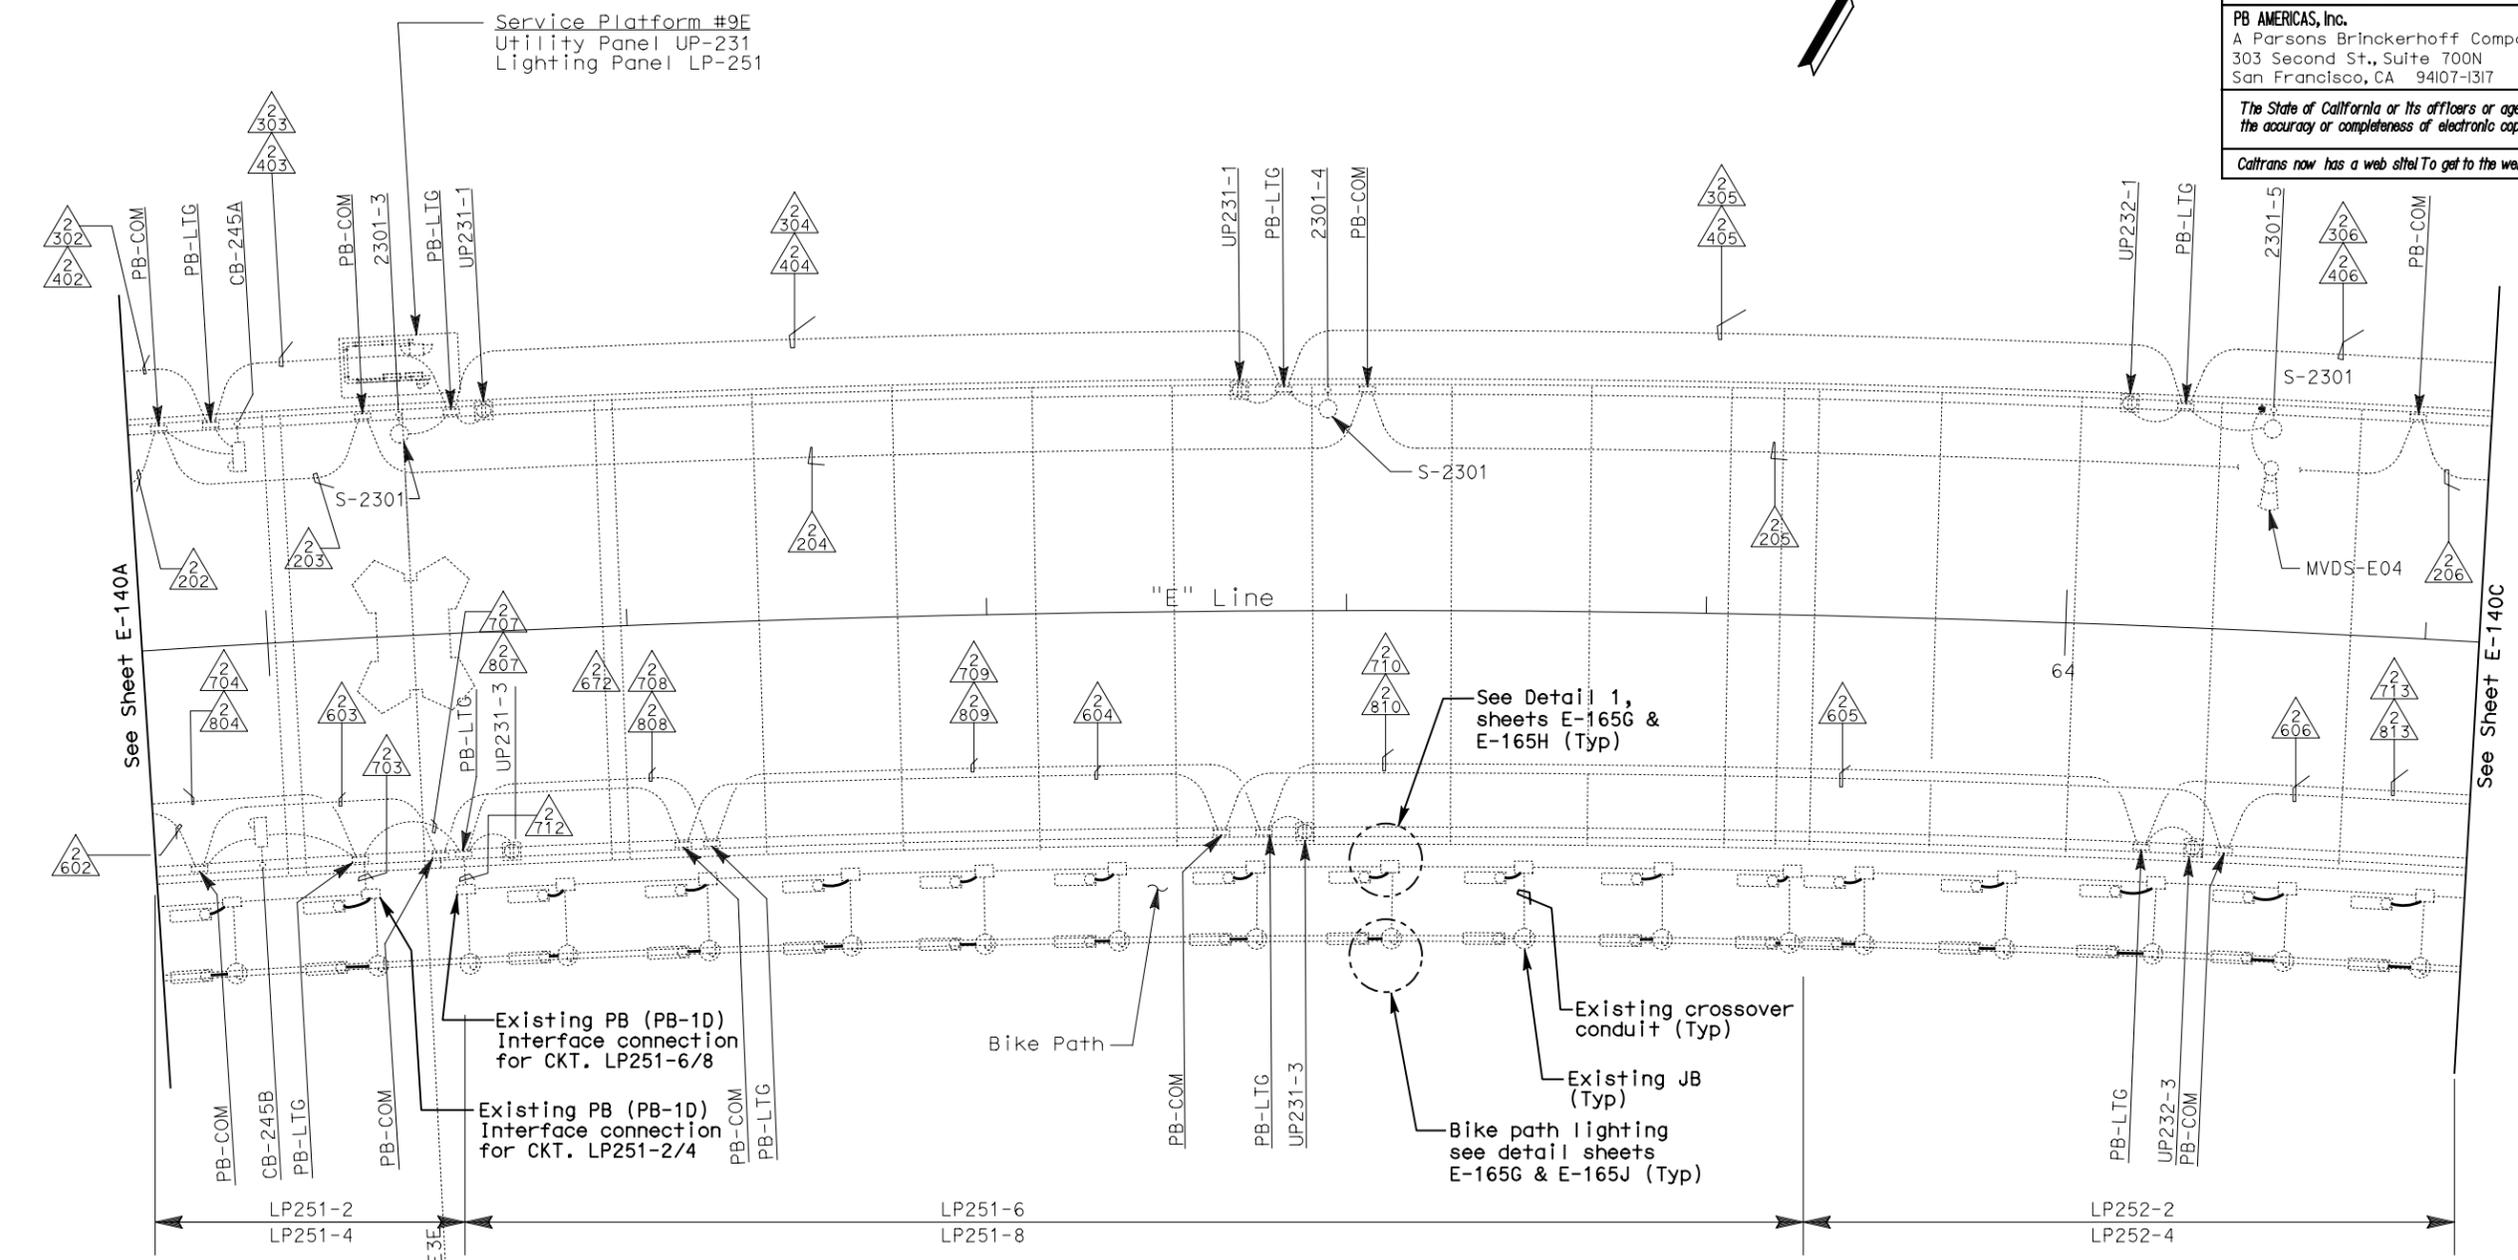

CONDUIT PLAN

NOTES:

- This plan sheet is a record drawing from Skyway structure. Existing condition shown is diagrammatic and may not completely reflect the actual as-built condition. Contractor to verify as-built prior to commencing the required modification. See Sheet EE-42 from Skyway Structures, contract No. 04-012024.
- Unless shown in bold, everything else shown was part of Skyway Contract.

REQUEST FOR INFORMATION NOT ADDRESSED IN THIS CCO REMAIN IN FORCE

| | | | | |
|-----------|--|--------------|----|------|
| 05/06/11 | MEP INTEGRATION REV. & UPGRADES TO SYSTEMS | TW | RG | 163 |
| MARK | DATE | DESCRIPTIONS | BY | CH'D |
| REVISIONS | | | | |

CONTRACT CHANGE ORDER NO. _____
 SHEET _____ OF _____

SKYWAY ROADWAY LEVEL EASTBOUND LIGHTING AND ELECTRICAL SYSTEMS

SCALE: 1:200

E-140B

THIS PLAN ACCURATE FOR ELECTRICAL WORK ONLY.

ALL DIMENSIONS ARE IN METERS UNLESS OTHERWISE SHOWN



DGN FILE => 04-0120f1_0193502.dgn
 USERNAME => llorico

CU 04251

EA 0120F1

DATE PLOTTED => 10-MAY-2011
 TIME PLOTTED => 16:42
 LAST REVISION 00-00-00