

REQUEST FOR INFORMATION NOT ADDRESSED IN THIS CCO REMAIN IN FORCE

05/06/11	MEP INTEGRATION REV. & UPGRADES TO SYSTEMS	TW	RG	163	
MARK	DATE	DESCRIPTIONS	BY	CH'D	CCO#
		REVISIONS			

CONTRACT CHANGE ORDER NO. _____
 SHEET _____ OF _____



DIST	COUNTY	ROUTE	KILOMETER TOTAL PROJECT	POST 13.2 / 13.9	SHEET No 193S05	TOTAL SHEETS 1204
04	SF, Alameda	80	13.2 / 13.9	193S05	1204	


REGISTERED ELECTRICAL ENGINEER
 SYN YEE CHIN
 No. 18186
 Exp. 09/30/2011
 STATE OF CALIFORNIA

PLANS APPROVAL DATE 10/28/10

PB AMERICAS, Inc.
 A Parsons Brinckerhoff Company
 303 Second St., Suite 700N
 San Francisco, CA 94107-1317

The State of California or its officers or agents shall not be responsible for the accuracy or completeness of electronic copies of this plan sheet.

Caltrans now has a web site! To get to the web site, go to <http://www.dot.ca.gov>

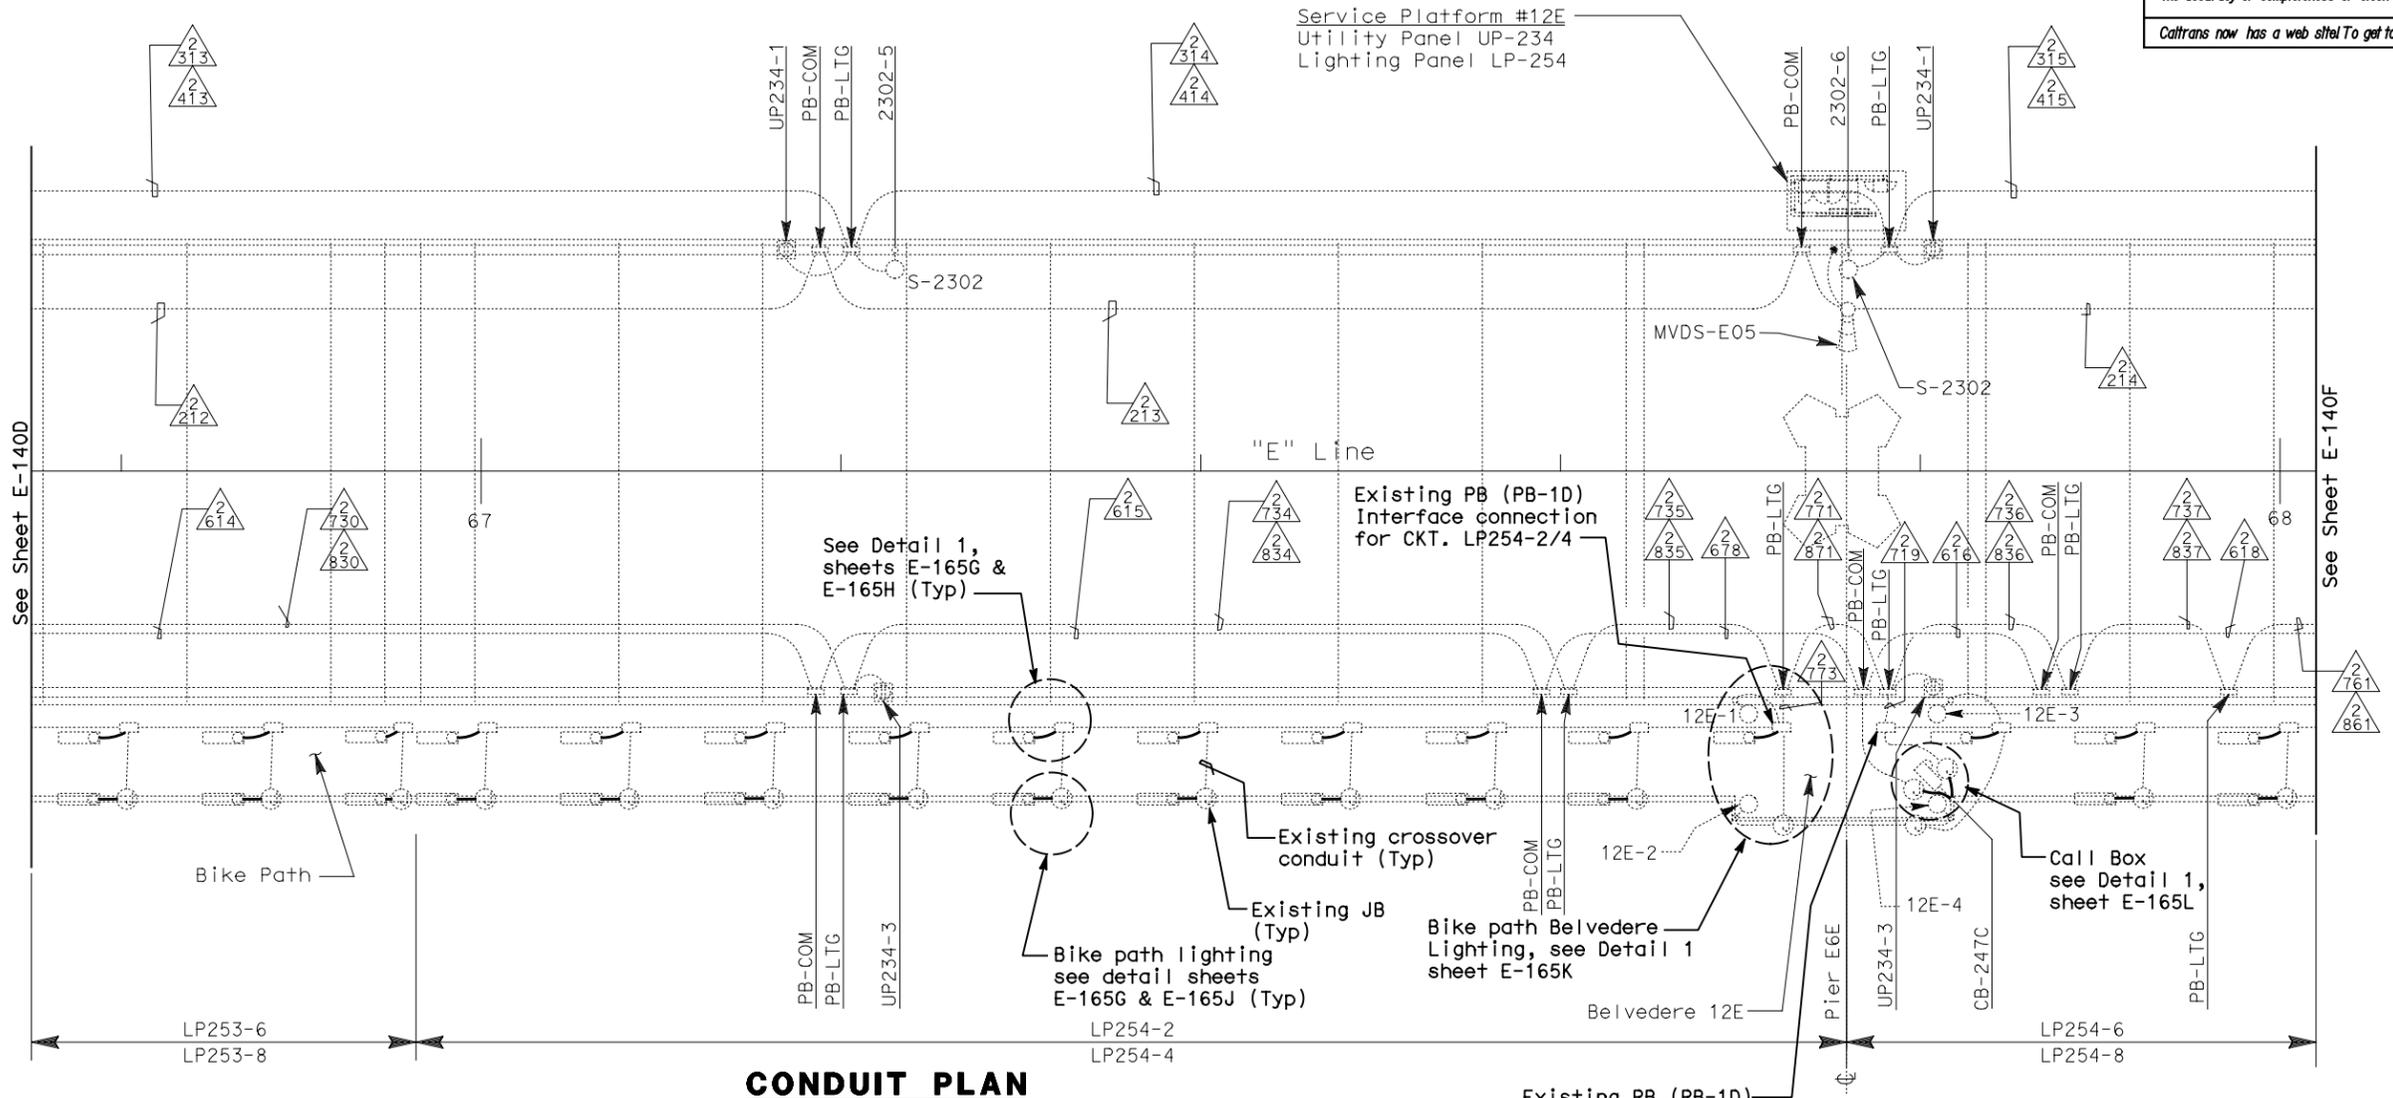

CONDUIT PLAN


NOTES:

1. This plan sheet is a record drawing from Skyway structure. Existing condition shown is diagrammatic and may not completely reflect the actual as-built condition. Contractor to verify as-built prior to commencing the required modification. See Sheet EE-45 from Skyway Structures, contract No. 04-012024.
2. Unless shown in bold, everything else shown was part of Skyway Contract.

SKYWAY ROADWAY LEVEL EASTBOUND LIGHTING AND ELECTRICAL SYSTEMS

SCALE: 1:200

THIS PLAN ACCURATE FOR ELECTRICAL WORK ONLY.

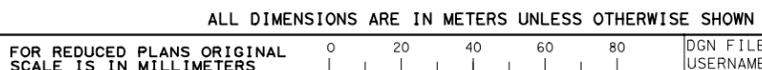

DGN FILE => 04-0120f1_0193S05.dgn
 USERNAME => llorico

CU 04251

EA 0120F1

E-140E

DATE PLOTTED => 10-MAY-2011
 TIME PLOTTED => 16:42
 LAST REVISION 00-00-00