

DESIGN OVERSIGHT	CALCULATED/DESIGNED BY	DATE	REVISOR	REVISION
BEHZAD GOLEMOHAMMADI		XX/XX/XX	XX	
	CHECKED BY	XX/XX/XX	XX	
				DATE REVISED

DIST	COUNTY	ROUTE	KILOMETER TOTAL PROJECT	POST TOTAL PROJECT	SHEET No	TOTAL SHEETS
04	SF, Alameda	80	13.2 / 13.9	193S17	1204	


REGISTERED ELECTRICAL ENGINEER
Syn Yee Chin 10/28/10
 No. 18186
 Exp. 09/30/2011
 STATE OF CALIFORNIA

PLANS APPROVAL DATE _____

PB AMERICAS, Inc.
 A Parsons Brinckerhoff Company
 303 Second St., Suite 700N
 San Francisco, CA 94107-1317

The State of California or its officers or agents shall not be responsible for the accuracy or completeness of electronic copies of this plan sheet.

Caltrans now has a web site! To get to the web site, go to <http://www.dot.ca.gov>

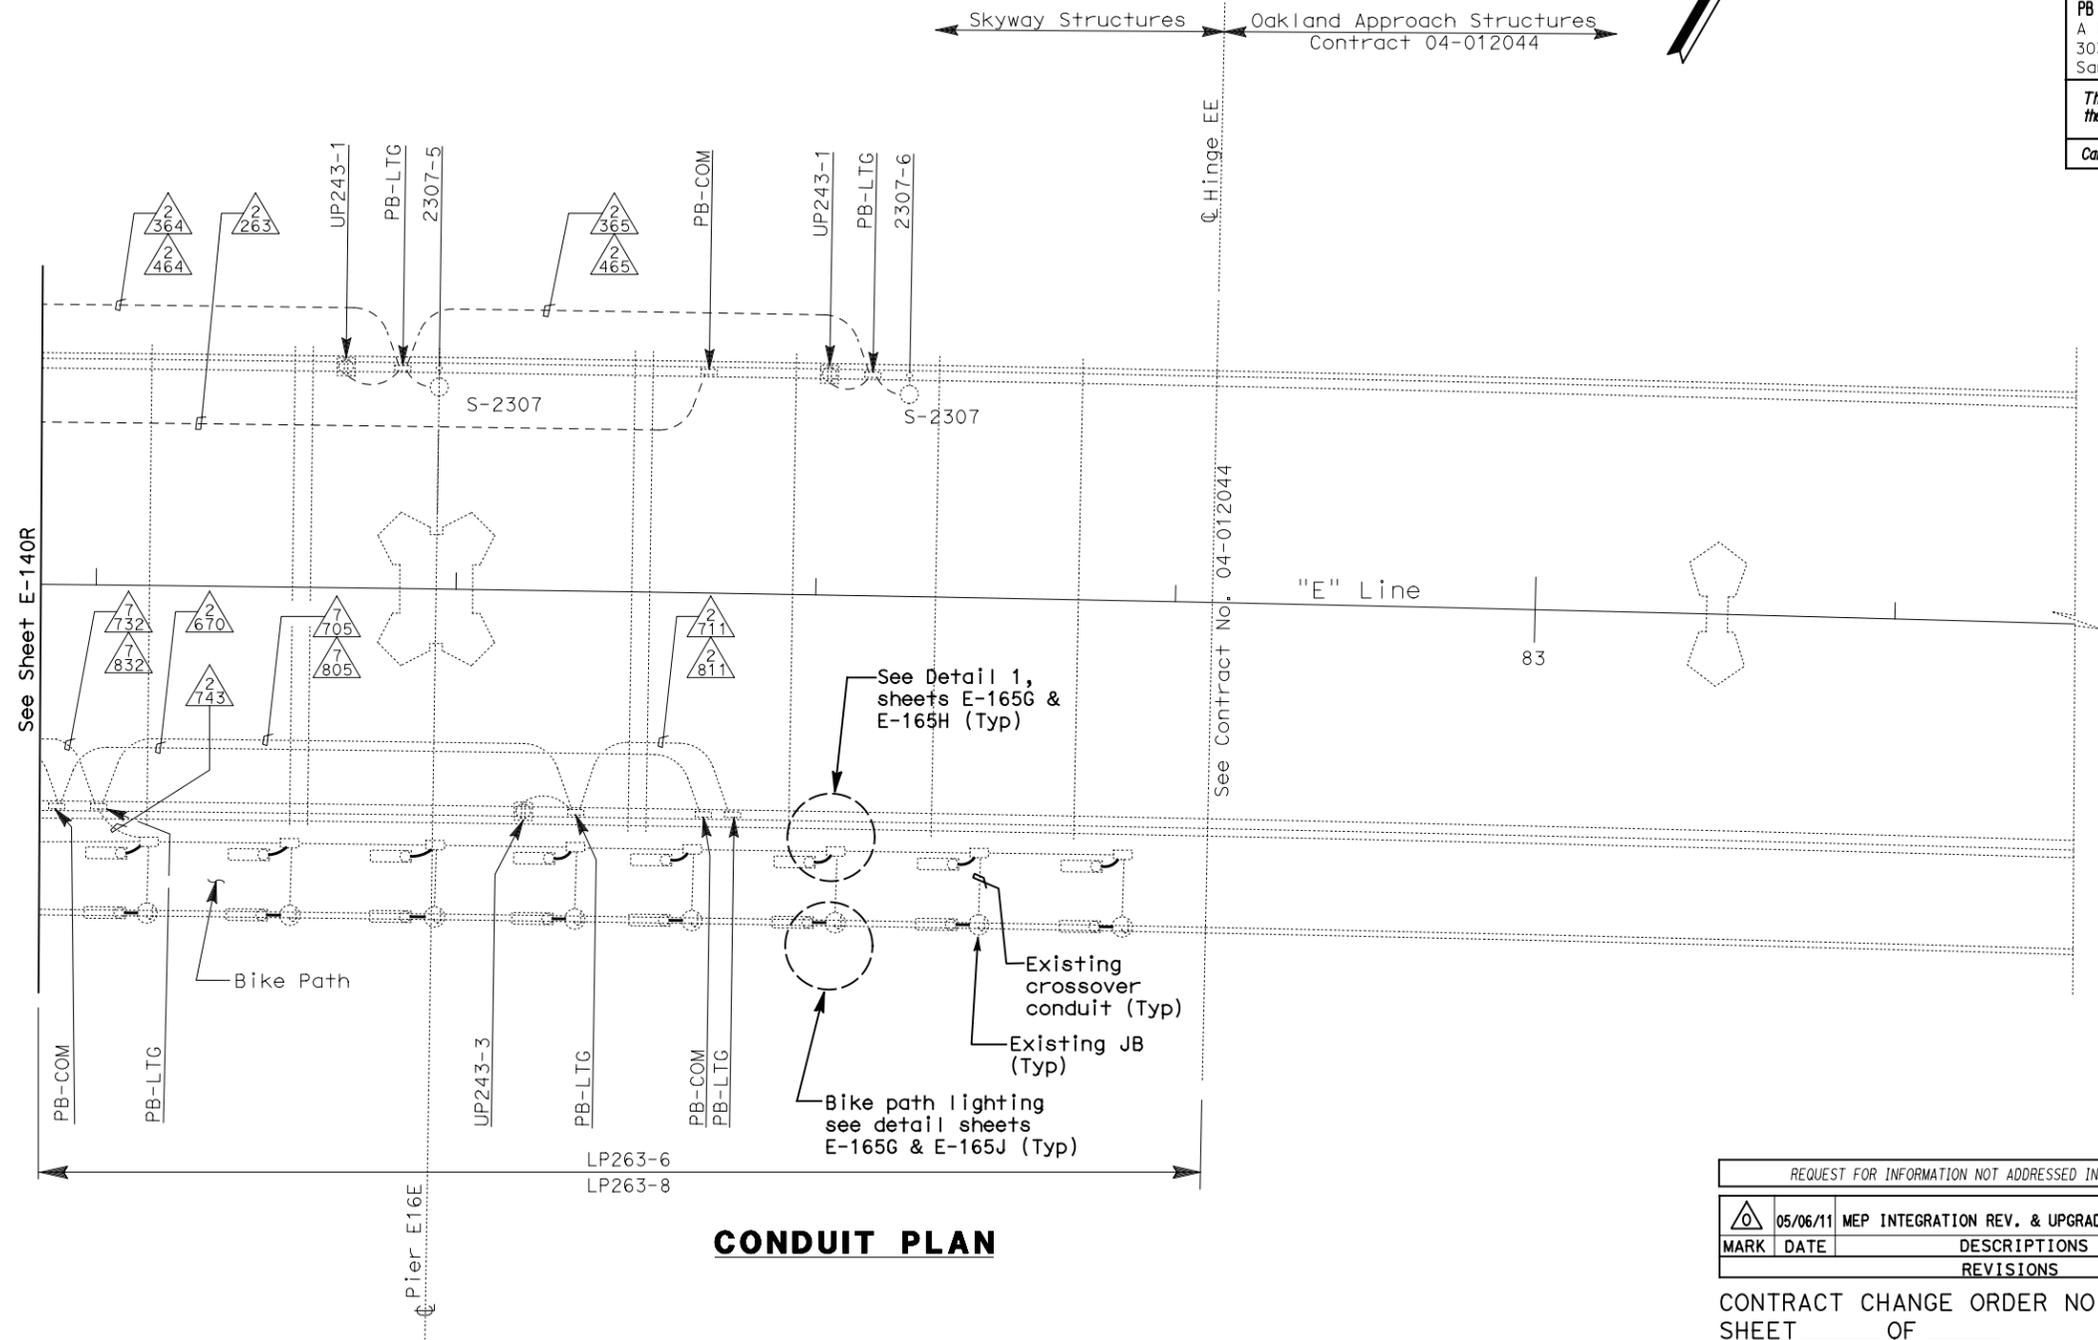

CONDUIT PLAN

REQUEST FOR INFORMATION NOT ADDRESSED IN THIS CCO REMAIN IN FORCE					
△	05/06/11	MEP INTEGRATION REV. & UPGRADES TO SYSTEMS	TW	RG	163
MARK	DATE	DESCRIPTIONS	BY	CH'D	CCO#
REVISIONS					

CONTRACT CHANGE ORDER NO. _____
 SHEET _____ OF _____

NOTES:

- This plan sheet is a record drawing from Skyway structure. Existing condition shown is diagrammatic and may not completely reflect the actual as-built condition. Contractor to verify as-built prior to commencing the required modification. See Sheet EE-57 from Skyway Structures, contract No. 04-012024.
- Unless shown in bold, everything else shown was part of Skyway Contract.

SKYWAY ROADWAY LEVEL EASTBOUND LIGHTING AND ELECTRICAL SYSTEMS

SCALE: 1:200

E-140S

THIS PLAN ACCURATE FOR ELECTRICAL WORK ONLY.

ALL DIMENSIONS ARE IN METERS UNLESS OTHERWISE SHOWN



DGN FILE => 04-0120f1_0193S17.dgn
 USERNAME => llorico

CU 04251

EA 0120F1

DATE PLOTTED => 10-MAY-2011
 TIME PLOTTED => 16:43
 LAST REVISION 00-00-00