




DIST	COUNTY	ROUTE	KILOMETER TOTAL PROJECT	POST TOTAL PROJECT	SHEET No	TOTAL SHEETS
04	SF,Ala	80	13.2 / 13.9	198S02	1204	
REGISTERED ELECTRICAL ENGINEER		DATE		10/28/10		
SYN YEE CHIN						
No. 18186						
Exp. 09/30/2011						
ELECTRICAL						
STATE OF CALIFORNIA						
PLANS APPROVAL DATE						
PB AMERICAS, Inc.						
A Parsons Brinckerhoff Company						
303 Second St., Suite 700N						
San Francisco, CA 94107-1317						
The State of California or its officers or agents shall not be responsible for the accuracy or completeness of electronic copies of this plan sheet.						
Caltrans now has a web site! To get to the web site, go to <a href="http://www.dot.ca.gov">http://www.dot.ca.gov</a>						

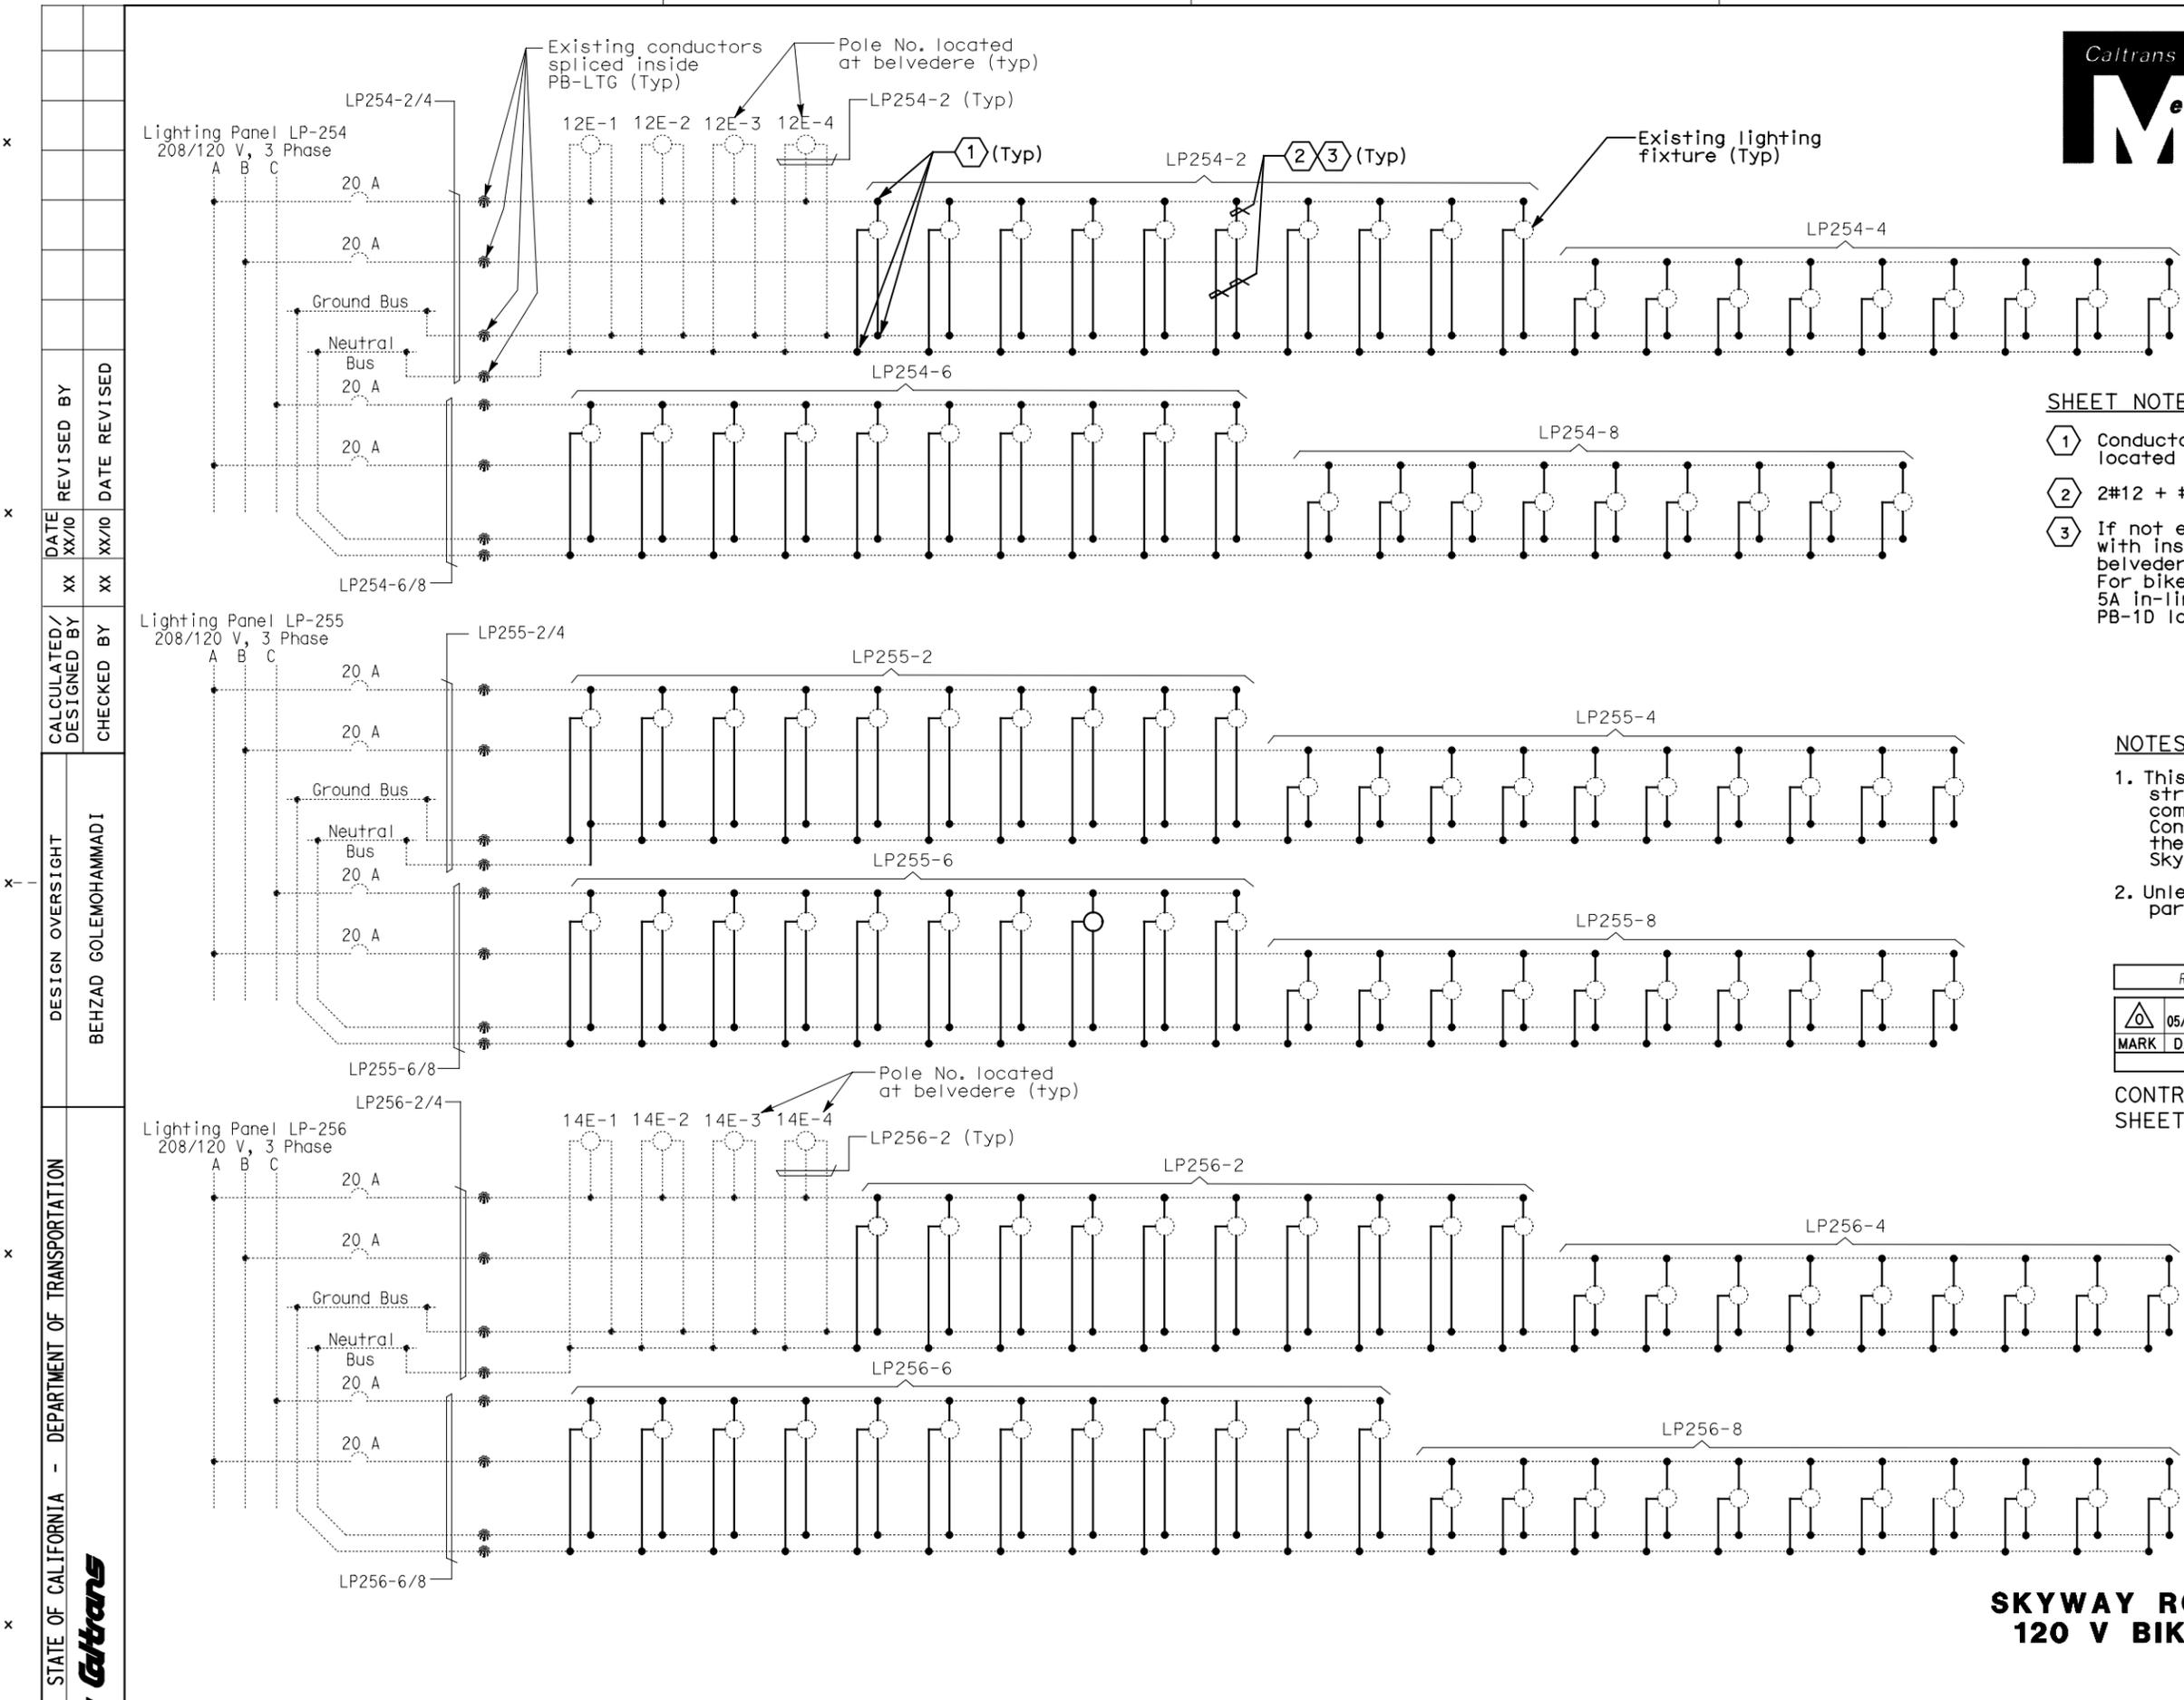

**SHEET NOTES:**


- ① Conductors spliced inside PB-LTG (PB-1D) located at north side of Bike Path.
- ② 2#12 + #12G, THWN. See Detail 1.
- ③ If not existing, install 5A in-line fuse in fuseholder with insulating boot per light fixture inside the belvedere light pole handhole for 14E-1 through 14E-4. For bike path lights (north/south hand railing) install 5A in-line fuses with water resistant fuseholder inside PB-1D located at north side of the bike path.

**NOTES:**

1. This sheet is a record drawing from Skyway structure. Existing condition shown may not completely reflect the actual as-built condition. Contractor to verify as-built prior to commencing the required modification. See Sheet EE-180 from Skyway Structures, contract No. 04-012024.
2. Unless shown in bold, everything else shown was part of Skyway Contract.

REQUEST FOR INFORMATION NOT ADDRESSED IN THIS CCO REMAIN IN FORCE					
△	05/06/11	MEP INTEGRATION REV. & UPGRADES TO SYSTEMS	TW	RG	163
MARK	DATE	DESCRIPTIONS	BY	CH'D	CCO#
		REVISIONS			

CONTRACT CHANGE ORDER NO. \_\_\_\_\_  
 SHEET \_\_\_\_\_ OF \_\_\_\_\_

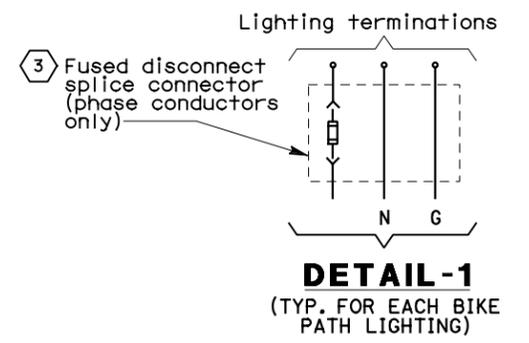

**SKYWAY ROADWAY LEVEL EASTBOUND  
 120 V BIKE PATH WIRING DIAGRAMS**

NO SCALE

**E-147B**

DESIGN OVERSIGHT  
 BEHZAD GOLEMOHAMMADI

STATE OF CALIFORNIA - DEPARTMENT OF TRANSPORTATION  
 Caltrans

THIS PLAN ACCURATE FOR ELECTRICAL WORK ONLY.

FOR REDUCED PLANS ORIGINAL SCALE IS IN MILLIMETERS

DGN FILE => 04-0120f1\_0198S02.dgn  
 USERNAME => ilorico

CU 04251

EA 0120F1

DATE PLOTTED => 10-MAY-2011  
 TIME PLOTTED => 16:43  
 LAST REVISION 00-00-00