


STATE OF CALIFORNIA - DEPARTMENT OF TRANSPORTATION  
**Caltrans**

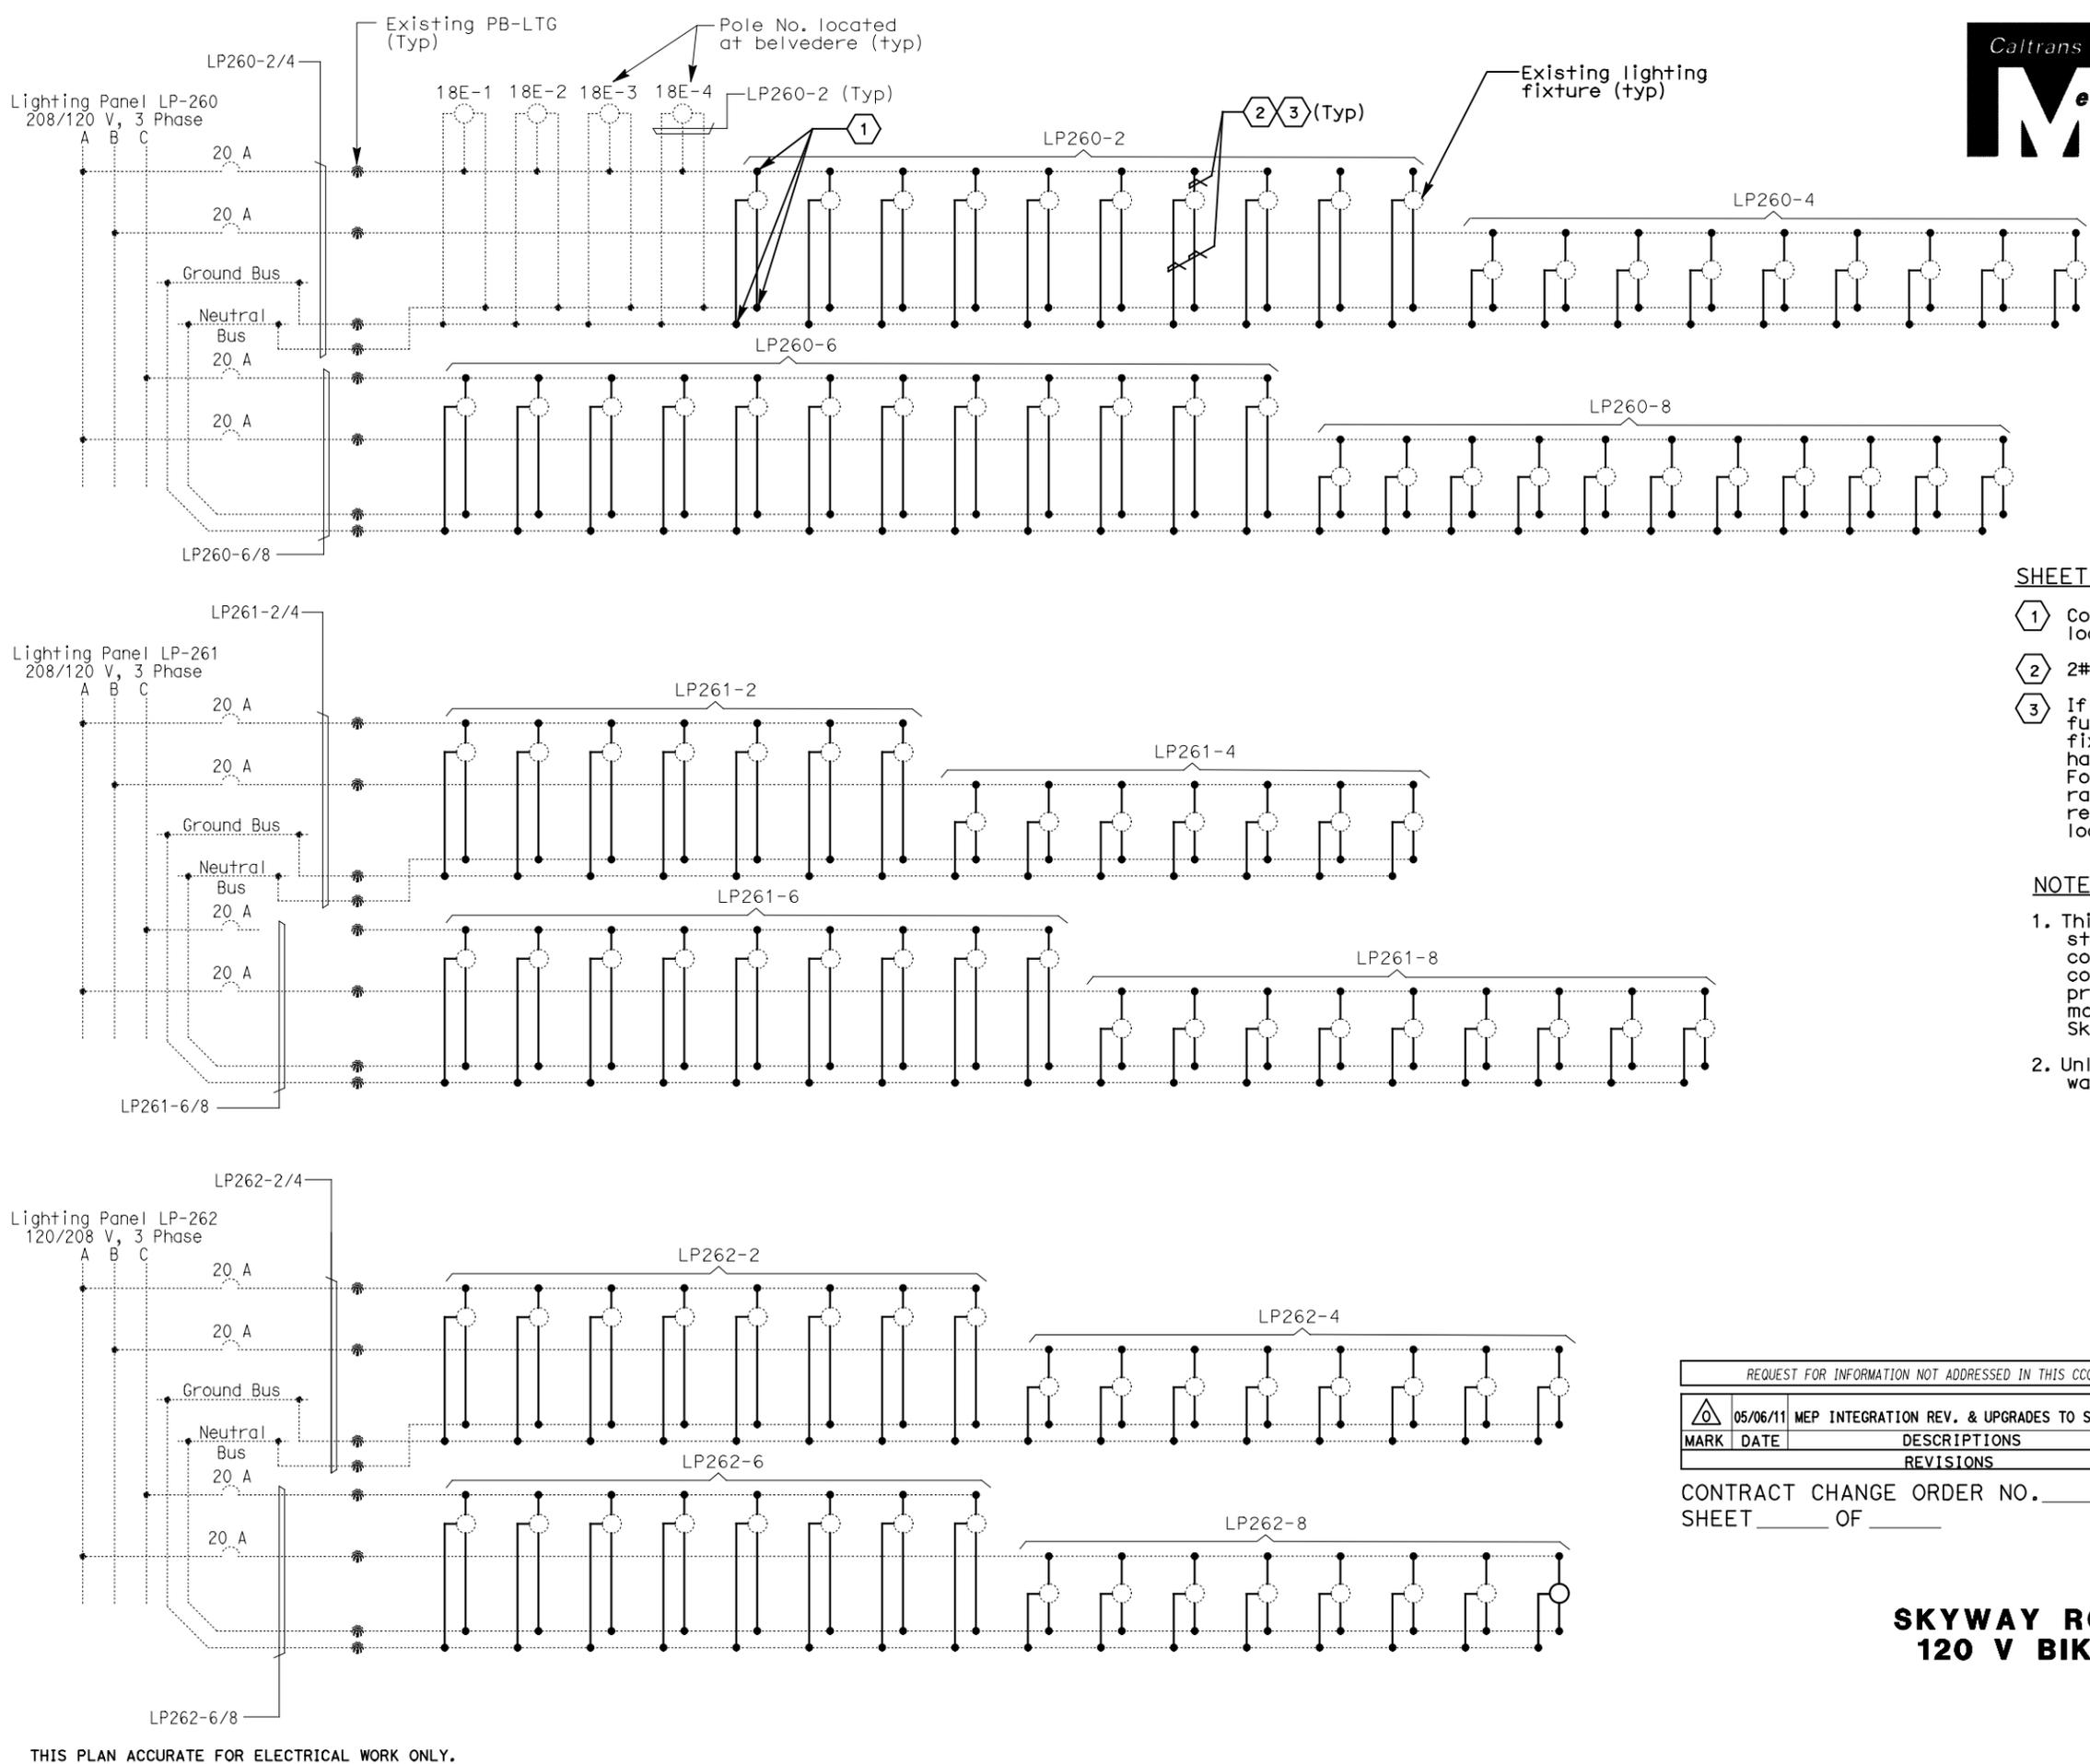

DIST	COUNTY	ROUTE	KILOMETER TOTAL PROJECT	POST TOTAL PROJECT	SHEET No	TOTAL SHEETS
04	SF,Ala	80	13.2 / 13.9	198S04	1204	

REGISTERED ELECTRICAL ENGINEER  
**Syn Yee Chin** 10/28/10  
 DATE

PLANS APPROVAL DATE

**PB AMERICAS, Inc.**  
 A Parsons Brinckerhoff Company  
 303 Second St., Suite 700N  
 San Francisco, CA 94107-1317

REGISTERED PROFESSIONAL ENGINEER  
**SYN YEE CHIN**  
 No. 18186  
 Exp. 09/30/2011  
 ELECTRICAL  
 STATE OF CALIFORNIA

*The State of California or its officers or agents shall not be responsible for the accuracy or completeness of electronic copies of this plan sheet.*


Caltrans now has a web site! To get to the web site, go to <http://www.dot.ca.gov>

**SHEET NOTES:**

- ① Conductors spliced inside PB-LTG (PB-1D) located at north side of Bike Path.
- ② 2#12 + #12G, THWN. See Detail 1.
- ③ If not existing, install 5A in-line fuse in fuseholder with insulating boot per light fixture inside the belvedere light pole handhole for 18E-1 through 18E-4. For bike path lights (north/south hand railing) install 5A in-line fuses with water resistant fuseholder inside PB-1D located at north side of the bike path.

**NOTES:**

1. This sheet is a record drawing from Skyway structure. Existing condition shown may not completely reflect the actual as-built condition. Contractor to verify as-built prior to commencing the required modification. See Sheet EE-182 from Skyway Structures, contract No. 04-012024.
2. Unless shown in bold, everything else shown was part of Skyway Contract.

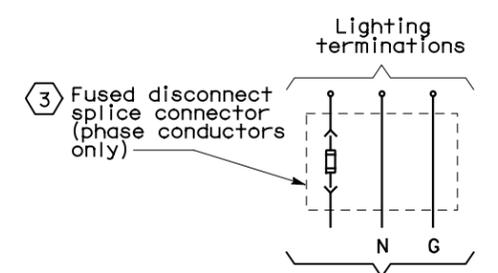

**DETAIL-1**  
 (TYP. FOR EACH BIKE PATH LIGHTING)

REQUEST FOR INFORMATION NOT ADDRESSED IN THIS CCO REMAIN IN FORCE					
△	05/06/11	MEP INTEGRATION REV. & UPGRADES TO SYSTEMS	TW	RG	163
MARK	DATE	DESCRIPTIONS	BY	CH'D	CCO#
		REVISIONS			

CONTRACT CHANGE ORDER NO. \_\_\_\_\_  
 SHEET \_\_\_\_\_ OF \_\_\_\_\_

**SKYWAY ROADWAY LEVEL EASTBOUND  
 120 V BIKE PATH WIRING DIAGRAMS**  
 NO SCALE

**E-147D**

THIS PLAN ACCURATE FOR ELECTRICAL WORK ONLY.

FOR REDUCED PLANS ORIGINAL SCALE IS IN MILLIMETERS

DGN FILE => 04-0120f1\_0198S04.dgn  
 USERNAME => ilorico

CU 04251

EA 0120F1

DATE PLOTTED => 10-MAY-2011  
 TIME PLOTTED => 16:43  
 00-00-00