

STATE OF CALIFORNIA - DEPARTMENT OF TRANSPORTATION
Caltrans

DESIGNED BY
 BEHZAD GOLEMOHAMMADI

CHECKED BY
 XX

DATE XX/XX/10

REVISOR
 XX

DATE XX/XX/10

DESIGN OVERSIGHT
 BEHZAD GOLEMOHAMMADI



DIST	COUNTY	ROUTE	KILOMETER TOTAL PROJECT	POST PROJECT	SHEET No	TOTAL SHEETS
04	SF, Alameda	80	13.2 / 13.9	198S05	1204	


REGISTERED ELECTRICAL ENGINEER
 SYN YEE CHIN
 No. 18186
 Exp. 09/30/2011
 STATE OF CALIFORNIA

PLANS APPROVAL DATE
 10/28/10

PB AMERICAS, Inc.
 A Parsons Brinckerhoff Company
 303 Second St., Suite 700N
 San Francisco, CA 94107-1317

The State of California or its officers or agents shall not be responsible for the accuracy or completeness of electronic copies of this plan sheet.

Caltrans now has a web site! To get to the web site, go to <http://www.dot.ca.gov>

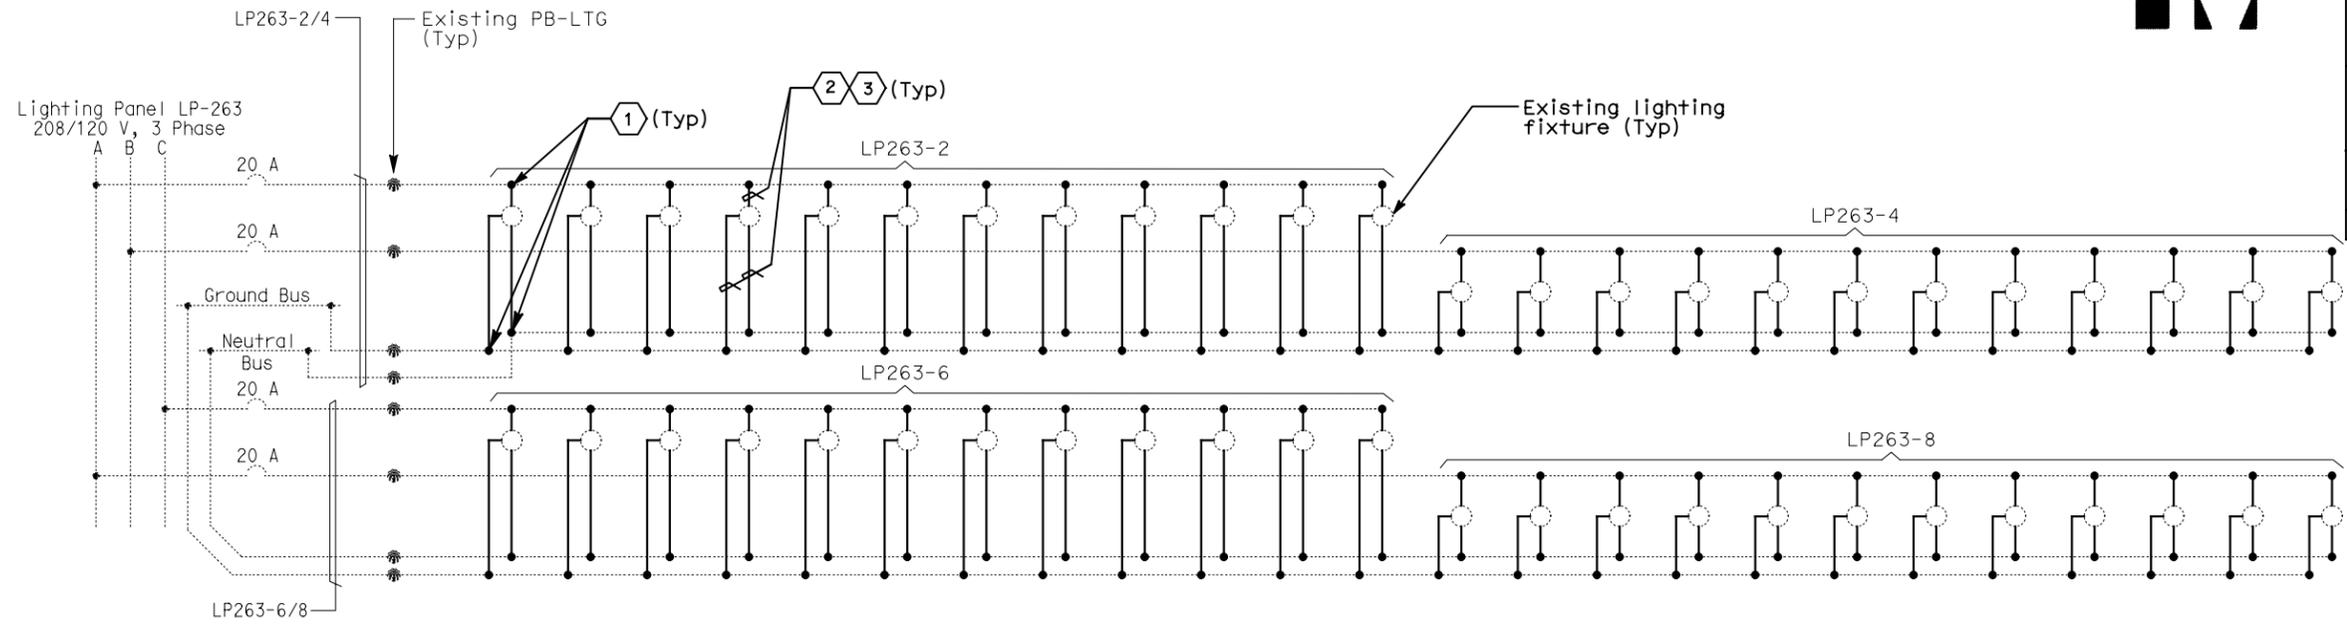


SHEET NOTES:

- 1 Conductors spliced inside PB-LTG (PB-1D) located at north side of Bike Path.
- 2 2#12 + #12G, THWN. See Detail 1.
- 3 For bike path lights (north/south hand railing) install 5A in-line fuses with water resistant fuseholder inside PB-1D located at north side of the bike path.

NOTES:

- 1. This sheet is a record drawing from Skyway structure. Existing condition shown may not completely reflect the actual as-built condition. Contractor to verify as-built prior to commencing the required modification. See Sheet EE-183 from Skyway Structures, contract No. 04-012024.
- 2. Unless shown in bold, everything else shown was part of Skyway Contract.

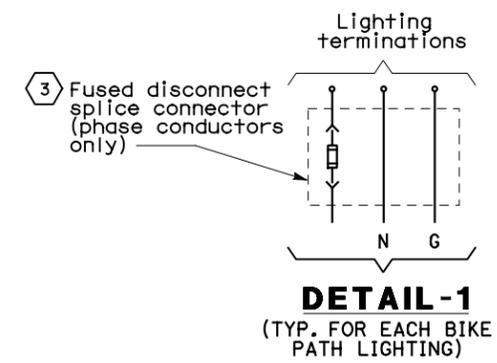

REQUEST FOR INFORMATION NOT ADDRESSED IN THIS CCO REMAIN IN FORCE					
MARK	DATE	DESCRIPTIONS	BY	CH'D	CCO#
0	05/06/11	MEP INTEGRATION REV. & UPGRADES TO SYSTEMS	TW	RG	163
REVISIONS					

CONTRACT CHANGE ORDER NO. _____
 SHEET _____ OF _____

**SKYWAY ROADWAY LEVEL EASTBOUND
 120 V BIKE PATH WIRING DIAGRAMS**
 NO SCALE

E-147E

THIS PLAN ACCURATE FOR ELECTRICAL WORK ONLY.

FOR REDUCED PLANS ORIGINAL SCALE IS IN MILLIMETERS
 0 20 40 60 80

DGN FILE =>04-0120f1_0198S05.dgn
 USERNAME =>llorico

CU 04251 EA 0120F1

DATE PLOTTED => 10-MAY-2011
 TIME PLOTTED => 16:43
 00-00-00