

DEPARTMENT OF TRANSPORTATION
 DIVISION OF ENGINEERING SERVICES
 Office of Structural Materials
 Quality Assurance and Source Inspection



Bay Area Branch
 690 Walnut Ave. St. 150
 Vallejo, CA 94592-1133
 (707) 649-5453
 (707) 649-5493

Contract #: 04-0120F4
 Cty: SF/ALA Rte: 80 PM: 13.2/13.9
 File #: 69.25B

QUALITY ASSURANCE -- NON-CONFORMANCE REPORT

Location: Changxing Island, Shanghai, P.R. China

Report No: NCR-000271

Prime Contractor: American Bridge/Fluor Enterprises, a JV

Date: 16-May-2009

Submitting Contractor: Zhenhua Port Machinery Company, Ltd (ZPMC), Changxing Island

NCR #: ZPMC-0245


Type of problem:

Welding	Concrete	Other	
Welding	Curing	Procedural	Bridge No: 34-0006
Joint fit-up	Coating	Other	Component: OBG Segment 1AAE
Procedural	Procedural	Description:	

Reference Description: Missed MT Indications by QC, Welds SEG2A-033 and 034

Description of Non-Conformance:

During Final Magnetic Particle Testing (MT) Inspection of OBG Segment 1AAE, Caltrans Quality Assurance (QA) Inspector performed tests on complete joint penetration welds SEG2A-033 and 034. Two linear indications were found on weld 033, a 45 mm crack and a 15 mm indication. One linear indication 15 mm in length was found on weld 034. Prior to QA MT, ZPMC Quality Control (QC) stated that 100% MT and Visual inspection had been performed on the above mentioned welds.

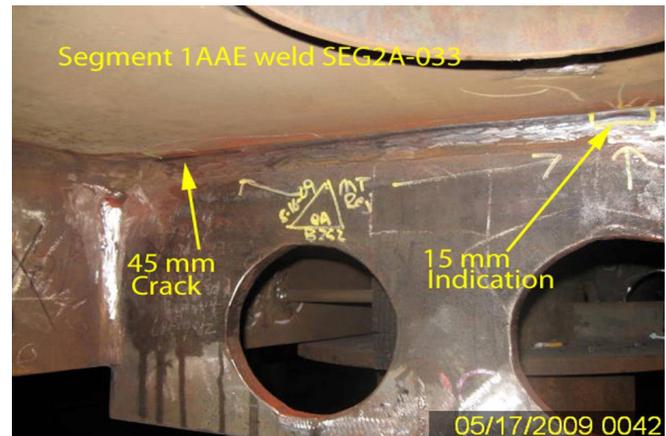

Applicable reference:

Special Provisions Section 8.3 – “Quality Control (QC) shall be the responsibility of the Contractor. As a minimum, the Contractor shall perform inspection and testing of each weld joint prior to welding, during welding, and after welding as specified in this section and to ensure that materials and workmanship conform to the requirements of the contract documents.”

AWS D1.5 (02) Section 6.26.2 – “Welds that are subject to MT in addition to visual inspection shall have no cracks”

QUALITY ASSURANCE -- NON-CONFORMANCE REPORT

(Continued Page 2 of 2)

Who discovered the problem: Larry Viars
Name of individual from Contractor notified: No ABF QC Present
Time and method of notification: NA
Name of Caltrans Engineer notified: Stanley Ku, Ching Chao
Time and method of notification: 05/17/09, 11:30, Email
QC Inspector's Name: Wang Lu
Was QC Inspector aware of the problem: Yes No
Contractor's proposal to correct the problem:

Comments:

This report is for the purpose of determining conformance with the contract documents and is not for the purpose of making repair or fit for purpose recommendations. Should you require recommendations concerning repairs or remedial efforts please contact Eric Tsang, +(86) 1500.042.2372, who represents the Office of Structural Materials for your project.

Inspected By:	Guest,Skylar	SMR
Reviewed By:	Wahbeh,Mazen	SMR



DEPARTMENT OF TRANSPORTATION - District 4 Toll Bridge
666 Feng Bin Road Room 708, Changxing Island
Shanghai 201913 PR China
Tel: 021-56856666 ext 207061 Fax:

NON-CONFORMANCE REPORT TRANSMITTAL

To: AMERICAN BRIDGE/FLUOR, A JV
375 BURMA ROAD
OAKLAND CA 95607

Date: 22-May-2009

Contract No: 04-0120F4
04-SF-80-13.2 / 13.9

Dear: Mr. Charles Kanapicki

Job Name: SAS Superstructure

Attention: Mr. Thomas Nilsson Project/Fabrication Manager

Document No: 05.03.06-000236

Subject: NCR No. ZPMC-0245

Reference Description: Missed MT Indications by QC, Welds SEG2A-033 and 034

The attached Non-Conformance Report describes an occurrence where the contractor did not comply with a requirement of the contract document as indicated below:

- Material or Workmanship not in conformance with contract documents.
- Quality Control (QC) not performed in conformance with contract documents.
- Recurring QC issue that constitutes a systematic problem in quality control.
- Non-Conformance Resolved.

Material Location: OBG **Lift:**

Remarks:

During Final Magnetic Particle Testing (MT) Inspection of OBG Segment 1AAE, Caltrans Quality Assurance (QA) Inspector performed tests on complete joint penetration welds SEG2A-033 and 034. Two linear indications were found on weld 033, a 45 mm crack and a 15 mm indication. One linear indication 15 mm in length was found on weld 034. Prior to QA MT, ZPMC Quality Control (QC) stated that 100% MT and Visual inspection had been performed on the above mentioned welds.

Action Required and/or Action Taken:

A response for the resolution of this issue is expected within 14 days.

Transmitted by: Stanley Ku Sr. Bridge Engineer

Attachments: ZPMC-0245

cc: Rick Morrow, Gary Pursell, Peter Siegenthaler, Brian Boal, Doug Coe, Jason Tom, Ching Chao

File: 05.03.06

NCR PROPOSED RESOLUTION

To: CALTRANS - SAS Superstructure
333 Burma Road
Oakland CA 94607

Attention: Pursell, Gary
Resident Engineer

Ref: 05.03.06-000236

Subject: NCR No. ZPMC-0245

Dated: 27-May-2009

Contract No.: 04-0120F4
04-SF-80-13.2 / 13.9

Job Name: SAS Superstructure

Document No.: ABF-NPR-000240 **Rev:** 00

Contractor's Proposed Resolution:

Reference Resolution: ZPMC has again been notified of missed NDT indications. ABF have recently transmitted a letter to ZPMC upper management to further elevate this issue within the ZPMC organization.

ZPMC has again been notified of missed NDT indications. ABF have recently transmitted a letter to ZPMC upper management to further elevate this issue within the ZPMC organization. ZPMC will submit weld repair and inspection documents at a later date.

Submitted by:

Attachment(s): ABF-NPR-000240R00

Caltrans' comments:

Status: AAP

Date: 04-Jun-2009

The response is acceptable, but the Non-Conformance is not closed.

Please provide documentation of the weld repairs that were performed and that the repairs were acceptable. The Department will review the Contractor's proposal to close Non-Conformance ZPMC-0245 at that time.

Submitted by: Wright, Doug

Date: 04-Jun-2009

Attachment(s): NPR CT Comments

NCR PROPOSED RESOLUTION

To: CALTRANS - SAS Superstructure
333 Burma Road
Oakland CA 94607

Attention: Pursell, Gary
Resident Engineer

Ref: 05.03.06-000236

Subject: NCR No. ZPMC-0245

Dated: 13-Jul-2009

Contract No.: 04-0120F4
04-SF-80-13.2 / 13.9

Job Name: SAS Superstructure

Document No.: ABF-NPR-000240 Rev: 01

Contractor's Proposed Resolution:

Reference Resolution: ZPMC has responded to the NCR and has attached the necessary documents for closure. ZPMC requests closure of this NCR.

ZPMC has responded to the NCR and has attached the necessary documents for closure. ZPMC requests closure of this NCR.

Submitted by:

Attachment(s): ABF-NPR-000240R01;

Caltrans' comments:

Status: AAP

Date: 15-Jul-2009

The response is acceptable, but the Non-Conformance is not closed. The attached documentation did not include all of the welds listed in the Non-Conformance.

Please provide the inspection documentation of all of the welds listed in the Non-Conformance. The Department will review the Contractor's proposal to close Non-Conformance ZPMC-0245 at that time.

Submitted by: Wright, Doug

Date: 15-Jul-2009

Attachment(s):



No. B-368

LETTER OF RESPONSE

TO: American Bridge/Flour

DATE: 2009-6-11

REGARDING: NCR-00270/271(ZPMC-0244/245)

With this letter of response, ZPMC requests closure for Caltrans NCR-00270/271(ZPMC-0244/245). According with the NPR response from the caltrans, we provide the documentation of the weld repairs the were performed and that the repairs were acceptable.

So base on the above explanation and attached documentations, ZPMC applies to close the caltrans's report NCR-00270/271(ZPMC-0244/245).

Please reference attached documentation for acceptance and closure the NCR-00270/271(ZPMC-0244/245).

ATTACHMENT:

NCR-00270/271(ZPMC-0244/245)

The critical welding repair report

The final NDT inspection reports

Zhuoshuangbao

2009. 6. 11



关键焊
Critical Welding

ZPMC-0244

CWR

final UT/MT

项目名称 Project Name:	美国海湾大桥 SFOBB	部件图号 Drawing No.:	
合同号 Contract No.:	04-0120F4	部件名称 Item Name:	1AAW
项目编号 Project No.:	ZP06-787	NDT 报告编号 NDT Report No.:	B787-MT-11112

焊缝缺陷描述:

Description of Welding Discontinuity:

吊耳去除后母材上发现有10处横向裂纹。1、L=10mm; 2、L=8mm; 3、L=12mm; 4、L=14mm; 5、L=6mm; 6、L=6mm; 7、L=8mm; 8、L=12mm; 9、L=10mm; 10、L=14mm;

Ten transverse cracks were found by use of MT in material after removing lifting.


1、L=10mm; 2、L=8mm; 3、L=12mm; 4、L=14mm; 5、L=6mm; 6、L=6mm; 7、L=8mm; 8、L=12mm; 9、L=10mm; 10、L=14mm;

检验员 (Inspector): Sun Gongchao

日期 (Date): 2009-05-23

焊缝返修位置示意图:

Draft of Welding Discontinuity:

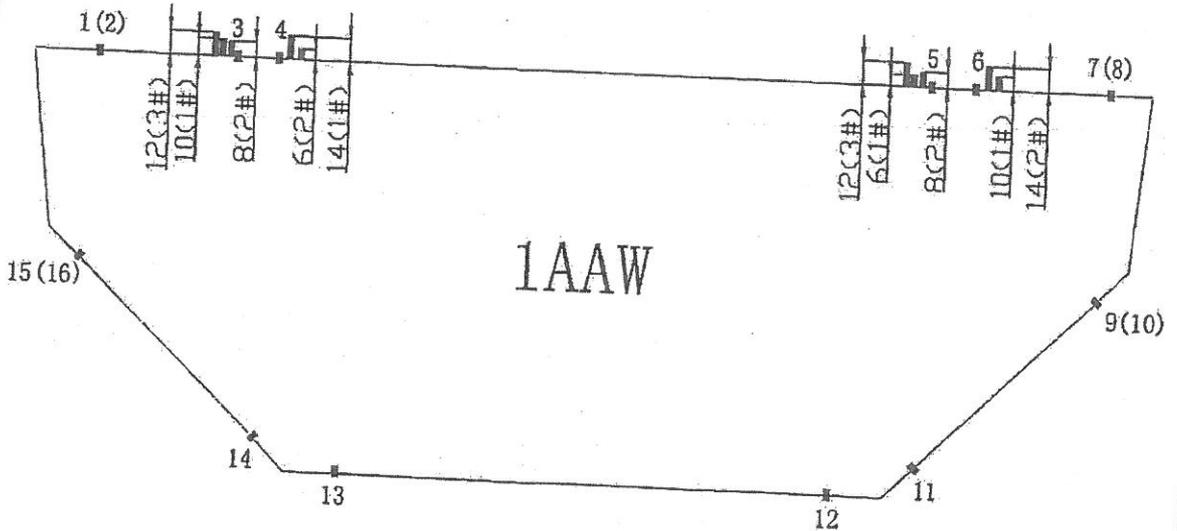

This document is APPROVED
State of California
DEPARTMENT OF TRANSPORTATION
Pursuant to Section 5-1.02 of the
Standard Specifications

Initial: fw Date: 5/25/09

产生原因:

Cause:

- 1. 在装配吊耳时, 产生点焊裂纹, 去除吊耳后, 裂纹延伸至母材.
- 2. 由于焊后应力集中或未能控制好预热温度导致裂纹出现

- 1. The tack crack was caused during assembly lifting, and cracks extended to base metal after removing lifting.
- 2. Welding contraction stresses and insufficient preheat and post heat control caused the crack.

车间负责人 (Foreman):

Li Zhigang

日期 (Date):

09.05.23

处理意见

Disposition :

- 1. 采用打磨的方式去除裂纹;
 - 2. 准备一个正确的接头型式, 具体参照相应的返修WPS;
 - 3. VT和MT检测确认返修区域没有裂纹;
 - 4. 根据批准的返修焊接工艺规程
 - 5. 预热温度应不小于100℃,
 - 6. 预热范围在修补区域周围不应小于150mm;
 - 7. 将修补区域打磨与母材或相邻焊缝平齐;
 - 8. 对修补区域做VT与MT检测.
- 1. Remove the crack by means of grinding.
 - 2. Prepare excavation according to the approved repair WPS.
 - 3. Verify with VT and MT repair areas are crack free.
 - 4. Preheat and weld according to the approved repair WPS.
 - 5. Preheat prior to welding to a minimum temperature of 100°C
 - 6. The preheat area shall be a minimum of 150mm in all directions around the repair area.
 - 7. Grind the repaired area flush with base metal or the adjacent weld.
 - 8. Perform VT and MT of the repair areas.

This document is APPROVED
 State of California
 DEPARTMENT OF TRANSPORTATION
 Pursuant to Section 5-1.02 of the
 Standard Specifications
 Initial: *FW* Date: 5/25/09

工艺:

Technical Engineer: *Nin Tiefaf*

审核:

Approved By:

Wang Chenbin

日期:

Date: 09.05.23

for Chenbin



关键焊缝返修报告

版本
Rev. No.:

Critical Welding Repair Report (CWR)

0

项目名称 Project Name:	美国海湾大桥 SFOBB	部件图号 Drawing No.:	SEG001	报告编号 Report No.:	B-CWR540
合同号 Contract No.:	04-0120F4	部件名称 Item Name:	1AAW	NDT 报告编号 NDT Report No.:	B787-MT-11112
项目编号 Project No.:	ZP06-787				

纠正措施:**Corrective Action to Prevent Re-occurrence:**

- 加强装配和焊接时监控和控制, 减少点焊裂纹;
 - 在焊后严格控制其后热程序, 避免裂纹现象发生。
- Enhance supervision and controlling during assembly and welding to reduce tack welding cracks.
 - Enhance supervision during the post heating operation to avoid cracks.

车间负责人 (Foreman): *Li zhigang* 日期 (Date): *09.25.23*

参照的 WPS 编号 Repair WPS No.:	WPS-345-SMAW-1 G(1F)-Repair WPS-345-FCAW-1 G(1F)-Repair-1	工艺员 Technologist:	<i>Niu Tiefeng</i> <i>09.25.23</i>
返修 (碳刨) 前预热温度 Preheat Temperature Before Gouging:	<i>110°C</i>	返修的缺陷 Description of Discontinuity:	<i>cracks</i>
焊前处理检查 Inspection Before Welding:	<i>Acc</i>	焊前预热温度 Preheat Temperature Before Welding:	<i>124°C</i>
最大碳刨深度 Max. Depth of Gouge:	<i>75mm</i>	碳刨总长 Total Length of Gouge:	<i>130mm</i>
焊工 Welder:	<i>062708</i>	焊接类型 Welding Type:	<i>7caw</i>
焊接电流 Current:	<i>287</i>	焊接电压 Voltage:	<i>29.5</i>
		焊接位置 Position:	<i>2F</i>
		焊接速度 Speed:	<i>4.29</i>

**返修后检查
Inspection After Repair:**

外观检查 VT Result:	<i>Acc</i>	检验员 Inspector:	<i>chenxi</i>	日期 Date:	<i>2009.05.29</i>
NDT 复检 NDT Result:	<i>Acc</i>	探伤员 NDT Person:	<i>Sun Yong chun</i>	日期 Date:	<i>09.25.29</i>

见证:
Witness/Review:备注:
Remark:

#R787-QCP-900

This document is APPROVED
State of California
DEPARTMENT OF TRANSPORTATION
Pursuant to Section 5-1.02 of the
Standard Specifications
Initial *fw* Date: *5/29/09*



REPORT OF MAGNETIC PARTICLE EXAMINATION

磁粉检测报告

REPORT NO. 报告编号 B787-MT-11112R1 DATE日期 2009.05.29 PAGE OF页码 1/1 Revision No: 0

PROJECT NO. 工程编号: ZP06-787 CONTRACTOR: 用户: CALTRANS

DRAWING NO. 图号: SEG001 1AAW CALTRANS CONTRACT NO.: 加州工程编号 04-0120F4

REFERENCING CODE 参考规范编码 AWS D1.5-2002 ACCEPTANCE STANDARD 接受标准 AWS D1.5-2002 PROCEDURE NO. 程序编号 ZPQC-MT-01 CALIBRATION DUE DATE 仪器校正有效期 Dec. 28ST, 2009

EQUIPMENT 设备 MT YOKE MANUFACTURER 制造商 PARKER MODEL NO. 样式编号 B310S SERIAL NO. 连续编号 5395 5617 5620

MAGNETIZING METHOD 磁化方法 Continuous magnetic yoke 磁轭式连续法 CURRENT 电流 AC

PARTICLE TYPE 磁粉类型 Dry magnet powder 干磁粉 YOKE SPACING 磁轭间距 70~150mm

MATERIAL TO BE EXAMINED 检测材料 WELDING 焊接件 CASTING 铸件 FORGING 锻造 Material & thickness 母材, 厚度 A709M-345T2-X 30 mm

WELDING PROCESS 焊接方法 FCAW TYPE OF JOINT 焊缝类型 NA

WELD I.D. 焊缝编号	DISCONTINUITY不连续性			ACCEPT 接受	REJECT 拒收	REMARKS 备注
	INDICATION 指示	TYPE 类型	LENGTH IN mm 长度			
3	1R1			ACC.		
	2R1			ACC.		
	3R1			ACC.		
4	1R1			ACC.		
	2R1			ACC.		
5	1R1			ACC.		
	2R1			ACC.		
	3R1			ACC.		
6	1R1			ACC.		
	2R1			ACC.		

AFTER B-CWR540

BLANK

EXAMINED BY主探 Sun Gongchang REVIEWED BY 审核 Ding Acheng

LEVEL - II SIGN 签名 / DATE日期 09.5.29 LEVEL-II SIGN / DATE日期 09.5.29

质量经理 / QCM 用户CUSTOMER

签字 SIGN / 日期 DATE 签字 SIGN / 日期 DATE



关键焊缝返修报告
Critical Welding

版本
Rev. No.:

项目名称 Project Name:	美国海湾大桥 SFOBB	部件图号 Drawing No.:	
合同号 Contract No.:	04-0120F4	部件名称 Item Name:	
项目编号 Project No.:	ZP06-787		

ZPMC-0245

*CWR
final VT (MT)*

焊缝缺陷描述:

Description of Welding Discontinuity:

在对SEG2A-033检测时, 发现2处纵向裂纹, 1、L=60mm; 2、L=6mm.

Welder ID No. (焊工编号): 066912

Position:(位置): 2G


We found two longitudinal cracks in SEG2A-033.

检验员 (Inspector): *Sun Gongchang*
Sun Gongchang

日期 (Date): 2009-05-17

焊缝返修位示意图:

Draft of Welding Discontinuity:

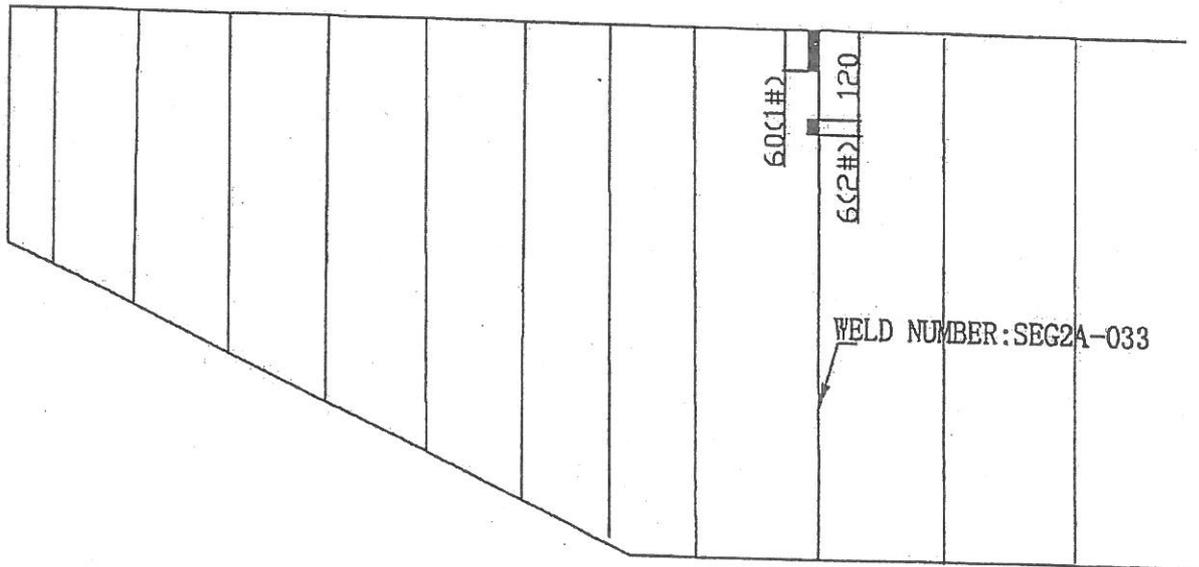

This document is APPROVED
State of California
DEPARTMENT OF TRANSPORTATION
Pursuant to Section 5-1.02 of the
Standard Specifications
Initial *AT* Date: *5/21/9*

产生原因:

Cause:

1. 火焰加热时, 水汽没有完全的去掉或者这个区域预热不够;
1. Moisture wasn't completely removed during drying operation (preheating) or the area wasn't preheated sufficiently.

车间负责人 (Foreman): *Lizhigang*

日期 (Date): *2009. 5. 19*

处理意见

Disposition:

1. 采用打磨的方式去除裂纹;
 2. 准备一个正确的接头型式, 具体参照相应的返修WPS;
 3. VT和MT检测确认返修区域没有裂纹;
 4. 根据批准的返修焊接工艺规程
 5. 预热温度应不小于100℃;
 6. 预热范围在修补区域周围不应小于150mm;
 7. 将修补区域打磨与母材或相邻焊缝平齐;
 8. 对修补区域做VT与MT检测。
1. Remove the crack by means of grinding.
 2. Prepare excavation according to the approved repair WPS.
 3. Verify with VT and MT repair areas are crack free.
 4. Preheat and weld according to the approved repair WPS.
 5. Preheat prior to welding to a minimum temperature of 100°C
 6. The preheat area shall be a minimum of 150mm in all directions around the repair area.
 7. Grind the repaired area flush with base metal or the adjacent weld.
 8. Perform VT and MT of the repair areas.

REVISION IS APPROVED
 State of California
 DEPARTMENT OF TRANSPORTATION
 Pursuant to Section 5-1.02 of the
 Standard Specifications
 Initial: *29* Date: *5/21/09*

工艺: *Niutiefang*
Technical Engineer: *2009. 5. 19*

审核: *lyybanhua*
Approved By: *for chenbin*

日期: *5.19*
Date:

		<h2 style="text-align: center;">关键焊缝返修报告</h2> <h3 style="text-align: center;">Critical Welding Repair Report (CWR)</h3>			版本 Rev. No.:	
					0	
项目名称 Project Name:	美国海湾大桥 SFOBB	部件图号 Drawing No.:	1AAE	报告编号 Report No.:	B-CWR533	
合同号 Contract No.:	04-0120F4	部件名称 Item Name:	SEG2A	NDT 报告编号 NDT Report No.:	B787-MT-10936	
项目编号 Project No.:	ZP06-787					
纠正措施: Corrective Action to Prevent Re-occurrence: 1. 返修前, QC确认有效的预热, 以将水汽全部去除。 1. QC shall verify sufficient preheat has been applied, to remove moisture, prior to welding.						
车间负责人 (Foreman): <i>Lizhigang</i>			日期 (Date): <i>2009.5.19</i>			
参照的WPS编号 Repair WPS No.:	WPS-345-SMAW-2 G(2F)-Repair WPS-345-FCAW-2 G(2F)-Repair-1		工艺员 Technologist:	<i>Niutiefeng</i> <i>5/19/09</i>		
返修(碳刨)前预热温度 Preheat Temperature Before Gouging:	<i>972</i>		返修的缺陷 Description of Discontinuity:	<i>crackler</i>		
焊前处理检查 Inspection Before Welding:	<i>Acc</i>		焊前预热温度 Preheat Temperature Before Welding:	<i>1162</i>		
最大碳刨深度 Max. Depth of Gouge:	<i>9mm</i>		碳刨总长 Total Length of Gouge:	<i>100mm</i>		
焊工 Welder:	<i>200569</i>	焊接类型 Welding Type:	<i>FCAW</i>	焊接位置 Position:	<i>2F</i>	
焊接电流 Current:	<i>290</i>	焊接电压 Voltage:	<i>30</i>	焊接速度 Speed:	<i>526</i>	
返修后检查 Inspection After Repair:						
外观检查 VT Result:	<i>Acc</i>	检验员 Inspector:	<i>chenxi</i>	日期 Date:	<i>2009.05.24.</i>	
NDT复检 NDT Result:	<i>Acc</i>	探伤员 NDT Person:	<i>Sungongchen</i>	日期 Date:	<i>09.05.24</i>	
见证: Witness/Review:						
备注: Remark:						

#R787-QCP-900

This document is APPROVED
 State of California
 DEPARTMENT OF TRANSPORTATION
 Pursuant to Section 5-1.02 of the
 Standard Specifications
 Initial *SR* Date: *5/21/09*

NCR PROPOSED RESOLUTION

To: CALTRANS - SAS Superstructure
333 Burma Road
Oakland CA 94607

Attention: Pursell, Gary
Resident Engineer

Ref: 05.03.06-000236

Subject: NCR No. ZPMC-0245

Dated: 15-Jul-2009

Contract No.: 04-0120F4
04-SF-80-13.2 / 13.9

Job Name: SAS Superstructure

Document No.: ABF-NPR-000240 Rev: 02

Contractor's Proposed Resolution:

Reference Resolution: ZPMC has responded to the NCR as stated in the attachment. ZPMC requests closure of this NCR.
ZPMC has responded to the NCR as stated in the attachment. ZPMC requests closure of this NCR.

Submitted by:

Attachment(s): ABF-NPR-000240R02;

Caltrans' comments:

Status: CLO

Date: 04-Aug-2009

The proposed resolution is acceptable. The inspection documents requested in Rev 1 have been provided. The Department concurs that Non-Conformance ZPMC-0245 is closed.

Submitted by: Wright, Doug

Date: 04-Aug-2009

Attachment(s):



No. B-395

LETTER OF RESPONSE

TO: American Bridge/Flour

DATE: 2009-7-14

REGARDING: NCR-00271 (ZPMC-0245)

With this letter of response, ZPMC requests closure for Caltrans **NCR-00271 (ZPMC-0245)**. As the comments of the NPR we provided the CWR and final MT inspection report to support the weld repairs that were performed and that the repairs were acceptable, But we should reminded here that the indication on the surface of SEG2A-034 was removed onsite by grinding and no necessary to prepared the weld repair report. By the way all final MT inspections had been completed by ZPMC and verified by CT.

So base on the above explanation and attached documentations, ZPMC applies to close the caltrans's report **NCR-00271 (ZPMC-0245)**.

Please reference attached documentation for acceptance and closure the **NCR-00271 (ZPMC-0245)**.

ATTACHMENT:

NCR-00271(ZPMC-0245)

ZPMC internal NCR

The critical welding repair report

The final MT inspection reports

Chao Anangbao

2009.7.14



Nonconformance Report

不符合项报告

Project Name: S.F.O.B.B 项目名称: 美国加州海湾大桥		NCR Number: NCR 编号: NCR-B-163 (ZPMC-0245)	
Item: Missed MT Indications by Quality Control 名称描述: MT 探伤漏检	Item Number: 件号: OBG 1AAE	Drawing: 图号: SEG2	
Location: OBG 1AAE 位置:		Date: 日期: 2009-06-03	

Description of Nonconformance:

During Final Magnetic Particle Testing(MT) Inspection of OBG Segment 1AAE, Caltrans Quality Assurance(QA) Inspector tests on complete joint penetration welds SEG2A-033 & 034. Two linear indications were found on weld 033, a 45mm crack and a 15mm indication. One linear indication 15mm in length was found on weld 034. Prior to QA MT, ZPMC QC stated that 100% MT and Visual inspection had been performed on the above mentioned welds.

加洲检验员在对 1AAE 箱体做 MT 检验时, 发现焊缝 SEG2A-033 上分别发现 45mm 和 15mm 的裂纹, 在焊缝 SEG2A-034 上发现 15mm 长的线性缺陷(裂纹)。之前, ZPMC 的检验员对这两条焊缝已经完成了 100% 的 VT 和 MT 并验收。

Work By: *Liliming* Prepared by: *Shen Xuejun* Reviewed by QCE: *陆建华*
 施工方: 09.06.29 准备: 2009.6.3 质量工程师批准:

Drawing Error Material Defect Fabrication Error Other
 图纸错误 材料缺陷 制作错误 其他原因 6/3/09

Disposition: Use as is Repair Reject
 处理措施: 回用 返修 拒收

Recommendation:

建议:

该部位重新检测返修

Re-inspection and repair.

Prepared by: *Liliming* Approved by QCA: _____
 准备: 09.06.29 质量经理批准

Reason for Nonconformance:

不符合原因:

裂纹没有检测到

Linear indication didn't find.

Prevention of Re-occurrence:

预防措施:

规范操作, 加强复检

Enhance re-inspection and perform according to procedure

Approved by/批准: Li Ziming of 06.29

Technical Justification for Use-As-Is/Repair:

回用或返修的技术依据:

Attachment

附件

Non-attachment

无附件

Reviewed /批准: _____

Verification:

Acceptable

Unacceptable

确认:

可接受

不可接受

Verified by QCI/质检确认: _____ Reviewed by QCA/质检主任审核: _____

#R787-QCP-1300



DEPARTMENT OF TRANSPORTATION - District 4 Toll Bridge
666 Feng Bin Road Room 708, Changxing Island
Shanghai 201913 PR China
Tel: 021-56856666 ext 207061 Fax:

NON-CONFORMANCE REPORT TRANSMITTAL

To: AMERICAN BRIDGE/FLUOR, A JV
375 BURMA ROAD
OAKLAND CA 95607

Date: 22-May-2009

Contract No: 04-0120F4
04-SF-80-13.2 / 13.9

Dear: Mr. Charles Kanapicki
Attention: Mr. Thomas Nilsson Project/Fabrication Manager

Job Name: SAS Superstructure
Document No: 05.03.06-000236

Subject: NCR No. ZPMC-0245

Reference Description: Missed MT Indications by QC, Welds SEG2A-033 and 034

The attached Non-Conformance Report describes an occurrence where the contractor did not comply with a requirement of the contract document as indicated below:

- Material or Workmanship not in conformance with contract documents.
- Quality Control (QC) not performed in conformance with contract documents.
- Recurring QC issue that constitutes a systematic problem in quality control.
- Non-Conformance Resolved.

Material Location: OBG

Lift:

Remarks:

During Final Magnetic Particle Testing (MT) Inspection of OBG Segment 1AAE, Caltrans Quality Assurance (QA) Inspector performed tests on complete joint penetration welds SEG2A-033 and 034. Two linear indications were found on weld 033, a 45 mm crack and a 15 mm indication. One linear indication 15 mm in length was found on weld 034. Prior to QA MT, ZPMC Quality Control (QC) stated that 100% MT and Visual inspection had been performed on the above mentioned welds.

Action Required and/or Action Taken:

A response for the resolution of this issue is expected within 14 days.

Transmitted by: Stanley Ku Sr. Bridge Engineer

Attachments: ZPMC-0245

cc: Rick Morrow, Gary Pursell, Peter Siegenthaler, Brian Boal, Doug Coe, Jason Tom, Ching Chao

File: 05.03.06

DEPARTMENT OF TRANSPORTATION
 DIVISION OF ENGINEERING SERVICES
 Office of Structural Materials
 Quality Assurance and Source Inspection

Bay Area Branch
 690 Walnut Ave. St. 150
 Vallejo, CA 94592-1133
 (707) 649-5453
 (707) 649-5493

Contract #: 04-0120F4

Cty: SF/ALA Rte: 80 PM: 13-2/13.9

File #: 69.25B

QUALITY ASSURANCE -- NON-CONFORMANCE REPORT

Location: Changxing Island, Shanghai, P.R. China

Report No: NCR-000271

Prime Contractor: American Bridge/Fluor Enterprises, a JV

Date: 16-May-2009

Submitting Contractor: Zhenhua Port Machinery Company, Ltd (ZPMC), Changxing Island

NCR #: ZPMC-0245

Type of problem:Welding Concrete Other Welding Curing Procedural

Bridge No: 34-0006

Joint fit-up Coating Other


Component: OBG Segment 1AAE

Procedural Procedural Description:

Reference Description: Missed MT Indications by QC, Welds SEG2A-033 and 034

Description of Non-Conformance:

During Final Magnetic Particle Testing (MT) Inspection of OBG Segment 1AAE, Caltrans Quality Assurance (QA) Inspector performed tests on complete joint penetration welds SEG2A-033 and 034. Two linear indications were found on weld 033, a 45 mm crack and a 15 mm indication. One linear indication 15 mm in length was found on weld 034. Prior to QA MT, ZPMC Quality Control (QC) stated that 100% MT and Visual inspection had been performed on the above mentioned welds.

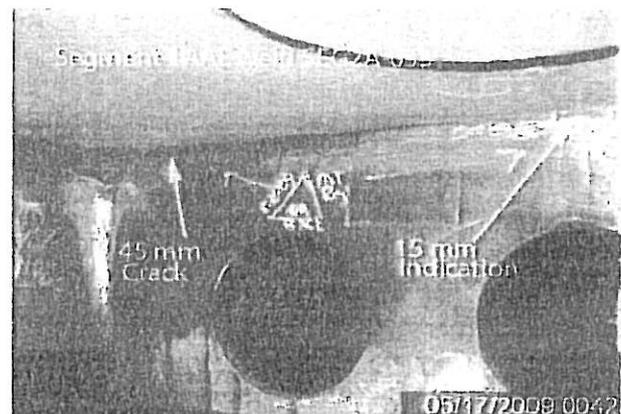**Applicable reference:**

Special Provisions Section 8.3 – “Quality Control (QC) shall be the responsibility of the Contractor. As a minimum, the Contractor shall perform inspection and testing of each weld joint prior to welding, during welding, and after welding as specified in this section and to ensure that materials and workmanship conform to the requirements of the contract documents.”

AWS D1.5 (02) Section 6.26.2 – “Welds that are subject to MT in addition to visual inspection shall have no cracks”

QUALITY ASSURANCE -- NON-CONFORMANCE REPORT

(Continued Page 2 of 2)

Who discovered the problem: Larry Viars
Name of individual from Contractor notified: No ABF QC Present
Time and method of notification: NA
Name of Caltrans Engineer notified: Stanley Ku, Ching Chao
Time and method of notification: 05/17/09, 11:30, Email
QC Inspector's Name: Wang Lu
Was QC Inspector aware of the problem: Yes No
Contractor's proposal to correct the problem:

Comments:

This report is for the purpose of determining conformance with the contract documents and is not for the purpose of making repair or fit for purpose recommendations. Should you require recommendations concerning repairs or remedial efforts please contact Eric Tsang, +(86) 1500.042.2372, who represents the Office of Structural Materials for your project.

Inspected By:	Guest, Skyler	SMR
Reviewed By:	Wahbeh, Mazen	SMR



关键焊缝返修报告
Critical Welding Repair Report (CWR)

版本
Rev. No.:

0

项目名称 Project Name:	美国海湾大桥 SFOBB	部件图号 Drawing No.:	1AAE	报告编号 Report No.:	B-CWR533
合同号 Contract No.:	04-0120F4	部件名称 Item Name:	SEG2A	NDT 报告编号 NDT Report No.:	B787-MT-10936
项目编号 Project No.:	ZP06-787				

焊缝缺陷描述:

Description of Welding Discontinuity:

在对SEG2A-033检测时, 发现2处纵向裂纹。1、L=60mm; 2、L=6mm.

Welder ID No. (焊工编号): 066912 Position:(位置): 2G


We found two longitudinal cracks in SEG2A-033.

检验员 (Inspector): Sun Gongchang

日期 (Date): 2009-05-17

焊缝返修位置示意图:

Draft of Welding Discontinuity:

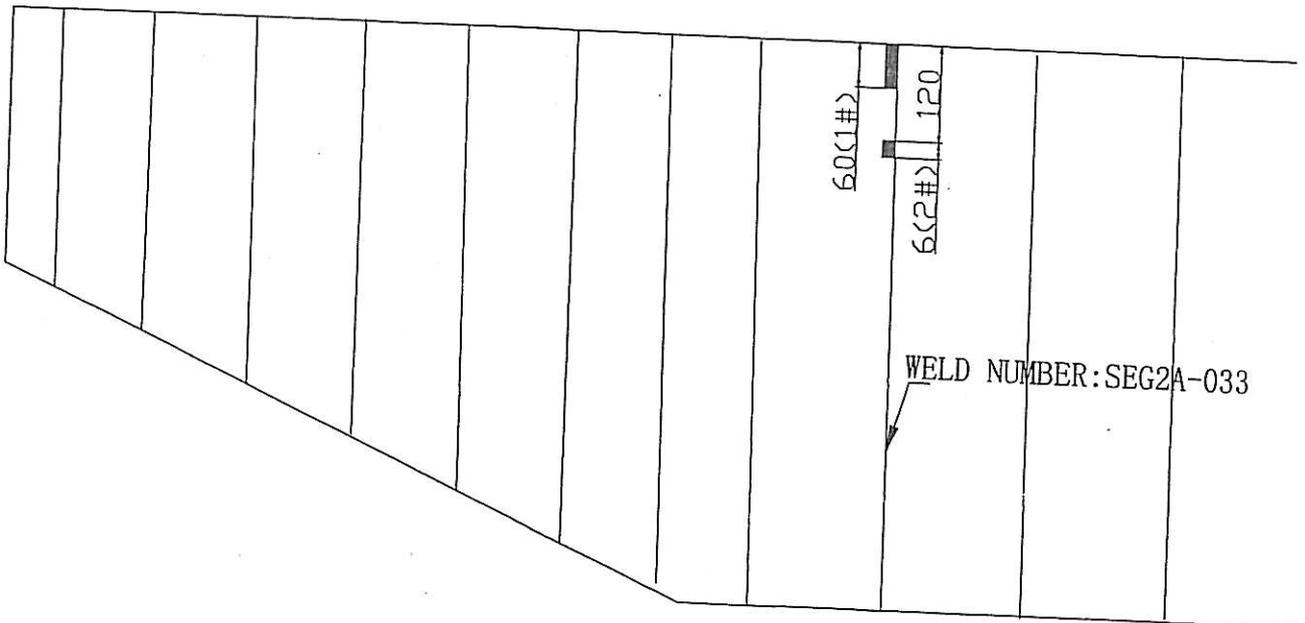

产生原因:

Cause:

1. 火焰加热时, 水汽没有完全的去掉或者这个区域预热不够;
1. Moisture wasn't completely removed during drying operation (preheating) or the area wasn't preheated sufficiently.

车间负责人 (Foreman): *Lizhigang*

日期 (Date): *2009. 5. 19*

处理意见

Disposition :

1. 采用打磨的方式去除裂纹;
 2. 准备一个正确的接头型式, 具体参照相应的返修WPS;
 3. VT和MT检测确认返修区域没有裂纹;
 4. 根据批准的返修焊接工艺规程
 5. 预热温度应不小于100℃,
 6. 预热范围在修补区域周围不应小于150mm;
 7. 将修补区域打磨与母材或相邻焊缝平齐;
 8. 对修补区域做VT与MT检测。
1. Remove the crack by means of grinding.
 2. Prepare excavation according to the approved repair WPS.
 3. Verify with VT and MT repair areas are crack free.
 4. Preheat and weld according to the approved repair WPS.
 5. Preheat prior to welding to a minimum temperature of 100°C
 6. The preheat area shall be a minimum of 150mm in all directions around the repair area.
 7. Grind the repaired area flush with base metal or the adjacent weld.
 8. Perform VT and MT of the repair areas.

工艺: *Niutiefang* *2009. 5. 19*
Technical Engineer:

审核: *Lujianhua*
Approved By: *for Cheubin*

日期: *5.19*
Date:



关键焊缝返修报告

Critical Welding Repair Report (CWR)

版本
Rev. No.:

0

项目名称 Project Name:	美国海湾大桥 SFOBB	部件图号 Drawing No.:	1AAE	报告编号 Report No.:	B-CWR533
合同号 Contract No.:	04-0120F4	部件名称 Item Name:	SEG2A	NDT 报告编号 NDT Report No.:	B787-MT-10936
项目编号 Project No.:	ZP06-787				

纠正措施:

Corrective Action to Prevent Re-occurrence:

1. 返修前, QC确认有效的预热, 以将水汽全部去除。

1. QC shall verify sufficient preheat has been applied, to remove moisture, prior to welding.

车间负责人 (Foreman):

Lizhigang

日期 (Date):

2009.5.19

参照的WPS编号 Repair WPS No.:	WPS-345-SMAW-2 G(2F)-Repair WPS-345-FCAW-2 G(2F)-Repair-1		工艺员 Technologist:	<i>Niutie feng</i> <i>5/19/09</i>	
返修(碳刨)前预热温度 Preheat Temperature Before Gouging:	<i>972</i>		返修的缺陷 Description of Discontinuity:	<i>crackler</i>	
焊前处理检查 Inspection Before Welding:	<i>Acc</i>		焊前预热温度 Preheat Temperature Before Welding:	<i>1162</i>	
最大碳刨深度 Max. Depth of Gouge:	<i>9mm</i>		碳刨总长 Total Length of Gouge:	<i>100mm</i>	
焊工 Welder:	<i>200569</i>	焊接类型 Welding Type:	<i>FCAW</i>	焊接位置 Position:	<i>2G</i>
焊接电流 Current:	<i>290</i>	焊接电压 Voltage:	<i>30</i>	焊接速度 Speed:	<i>526</i>
返修后检查 Inspection After Repair:					
外观检查 VT Result:	<i>Acc</i>	检验员 Inspector:	<i>chenxi</i>	日期 Date:	<i>2009.05.24.</i>
NDT复检 NDT Result:	<i>Acc</i>	探伤员 NDT Person:	<i>San Yong Chen</i>	日期 Date:	<i>09.05.24</i>
见证: Witness/Review:					
备注: Remark:					

#R787-QCP-900

This document is APPROVED
State of California
DEPARTMENT OF TRANSPORTATION
Pursuant to Section 5-1.02 of the
Standard Specifications
Initial *SH* Date: *5/21/09*



REPORT OF MAGNETIC PARTICLE EXAMINATION

磁粉检测报告

REPORT NO. 报告编号 B787-MT-10936		DATE日期 2009.05.17	PAGE OF页码 1/1	Revision No: 0
PROJECT NO. 工程编号: ZP06-787		CONTRACTOR: 用户: CALTRANS		
DRAWING NO. 图号: 1AAE SEG2A		CALTRANS CONTRACT NO.: 加州工程编号 04-0120F4		
REFERENCING CODE 参考规范编码 AWS D1.5-2002	ACCEPTANCE STANDARD 接受标准 AWS D1.5-2002	PROCEDURE NO. 程序编号 ZPQC-MT-01	CALIBRATION DUE DATE 仪器校正有效期 Dec. 28 ST , 2009	
EQUIPMENT 设备 MT YOKE	MANUFACTURER 制造商 PARKER	MODEL NO. 样式编号 B310S	SERIAL NO. 连续编号 5395 5617 5620	
MAGNETIZING METHOD 磁化方法	Continuous magnetic yoke 磁轭式连续法	CURRENT 电流	AC	
PARTICLE TYPE 磁粉类型	Dry magnet powder 干磁粉	YOKE SPACING 磁轭间距	70~150mm	
MATERIAL TO BE EXAMINED 检测材料	<input checked="" type="checkbox"/> WELDING 焊接件 <input type="checkbox"/> CASTING 铸件 <input type="checkbox"/> FORGING 锻造	Material & thickness 母材, 厚度	A709M-345 20/38mm	
WELDING PROCESS 焊接方法	SAW/FCAW	TYPE OF JOINT 焊缝类型	T-JOINT	

WELD I.D. 焊缝编号	DISCONTINUITY不连续性			ACCEPT 接受	REJECT 拒收	REMARKS 备注
	INDICATION 指示	TYPE 类型	LENGTH IN mm 长度			
SEG2A-032				ACC.		100%MT
SEG2A-033	1	CRACK	60		REJ.	100%MT
	2	CRACK	6		REJ.	100%MT
SEG2A-034				ACC.		100%MT
SEG2A-030				ACC.		100%MT
BLANK						

EXAMINED BY主探 <i>Sun Jangchang</i>	REVIEWED BY 审核 <i>Shang Shou Chen</i>
LEVEL-II SIGN 签名 / DATE日期 质量经理 / QCM <i>9.25.11</i>	LEVEL-II SIGN 1 / DATE日期 用户CUSTOMER <i>9.25.11</i>
签字 SIGN / 日期 DATE	签字 SIGN / 日期 DATE



REPORT OF MAGNETIC PARTICLE EXAMINATION

磁粉检测报告

REPORT NO. 报告编号 B787-MT-10936R1		DATE日期 2009.05.24		PAGE OF页码 1/1	Revision No: 0	
PROJECT NO. 工程编号: ZP06-787			CONTRACTOR: 用户: CALTRANS			
DRAWING NO. 图号: 1AAE SEG2A			CALTRANS CONTRACT NO.: 加州工程编号 04-0120F4			
REFERENCING CODE 参考规范编码 AWS D1.5-2002	ACCEPTANCE STANDARD 接受标准 AWS D1.5-2002	PROCEDURE NO. 程序编号 ZPQC-MT-01	CALIBRATION DUE DATE 仪器校正有效期 Dec. 28 ST , 2009			
EQUIPMENT 设备 MT YOKE	MANUFACTURER 制造商 PARKER	MODEL NO. 样式编号 B310S	SERIAL NO. 连续编号 5395 5617 5620			
MAGNETIZING METHOD 磁化方法	Continuous magnetic yoke 磁轭式连续法	CURRENT 电流	AC			
PARTICLE TYPE 磁粉类型	Dry magnet powder 干磁粉	YOKE SPACING 磁轭间距	70~150mm			
MATERIAL TO BE EXAMINED 检测材料	<input checked="" type="checkbox"/> WELDING 焊接件 <input type="checkbox"/> CASTING 铸件 <input type="checkbox"/> FORGING 锻造	Material & thickness 母材, 厚度	A709M-345 20/38mm			
WELDING PROCESS 焊接方法	FCAW	TYPE OF JOINT 焊缝类型	T-JOINT			
WELD I.D. 焊缝编号	DISCONTINUITY不连续性			ACCEPT 接受	REJECT 拒收	REMARKS 备注
	INDICATION 指示	TYPE 类型	LENGTH IN mm 长度			
SEG2A-033	1R1			ACC.		
	2R1			ACC.		
AFTER B-CWR533						
BLANK						
EXAMINED BY主探 Sun Gongchang <i>Sun Gongchang</i>			REVIEWED BY 审核 <i>Shang Shuchen</i>			
LEVEL - II SIGN 签名 / DATE日期 质量经理 / QCM <i>SJ, J.VV</i>			LEVEL-II SIGN / DATE日期 用户CUSTOMER <i>SJ, J.VV</i>			
签字 SIGN / 日期 DATE			签字 SIGN / 日期 DATE			

DEPARTMENT OF TRANSPORTATION

DIVISION OF ENGINEERING SERVICES

Office of Structural Materials

Quality Assurance and Source Inspection



Bay Area Branch
690 Walnut Ave. St. 150
Vallejo, CA 94592-1133
(707) 649-5453
(707) 649-5493

Contract #: 04-0120F4Cty: SF/ALA Rte: 80 PM: 13.2/13.9File #: xx.25A**QUALITY ASSURANCE -- NON-CONFORMANCE RESOLUTION****Location:** Changxing Island, Shanghai, P.R. China**Report No:** NCS-000228**Prime Contractor:** American Bridge/Fluor Enterprises, a JV**Date:** 29-Jul-2009**Submitting Contractor:** Zhenhua Port Machinery Company, Ltd (ZPMC), Changxing Island **NCR #:** ZPMC-0245**Type of problem:**

Welding	Concrete	Other	
Welding	Curing	Procedural	Bridge No: 34-0006
Joint fit-up	Coating	Other	Component:
Procedural	Procedural	Descriptor:	

Date the Non-Conformance Report was written: 16-May-2009**Description of Non-Conformance:**

During Final Magnetic Particle Testing (MT) Inspection of OBG Segment 1AAE, Caltrans Quality Assurance (QA) Inspector performed tests on complete joint penetration welds SEG2A-033 and 034. Two linear indications were found on weld 033, a 45 mm crack and a 15 mm indication. One linear indication 15 mm in length was found on weld 034. Prior to QA MT, ZPMC Quality Control (QC) stated that 100% MT and Visual inspection had been performed on the above mentioned welds.

Contractor's proposal to correct the problem:

Contractor shall perform proper repair and NDT to verify that the repair is acceptable.

Corrective action taken:

ABF provided NDT documentation to verify that the repair is acceptable.

Did corrective action require Engineer's approval? Yes No**If so, name of Engineer providing approval:****Date:****Is Engineer's approval attached?** Yes No**Comments:**

This report is for the purpose of determining conformance with the contract documents and is not for the purpose of making repair or fit for purpose recommendations. Should you require recommendations concerning repairs or remedial efforts please contact Mazen Wahbeh, +(86) 134.7247.7571, who represents the Office of Structural Materials for your project.

Inspected By: Lowry, Patrick

Quality Assurance Inspector

Reviewed By: Wahbeh, Mazen

QA Reviewer