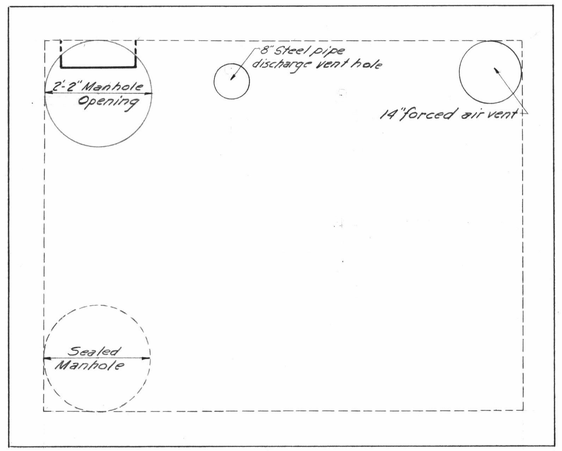

ROOF

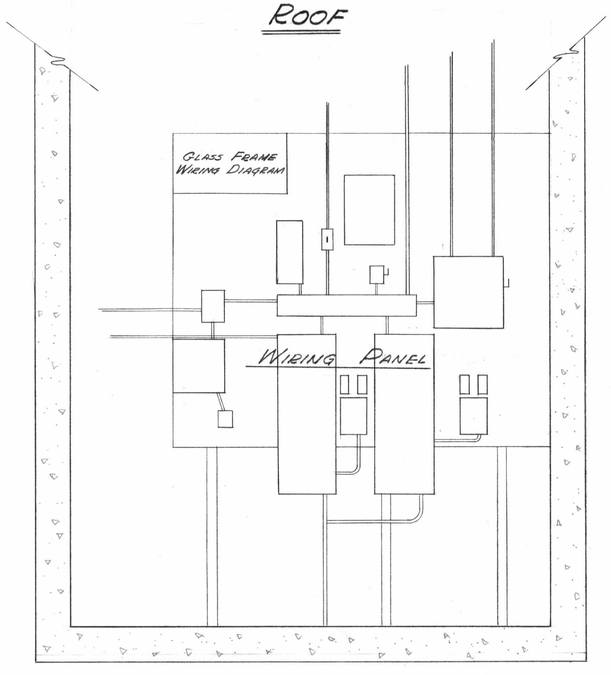

SECTION C-C

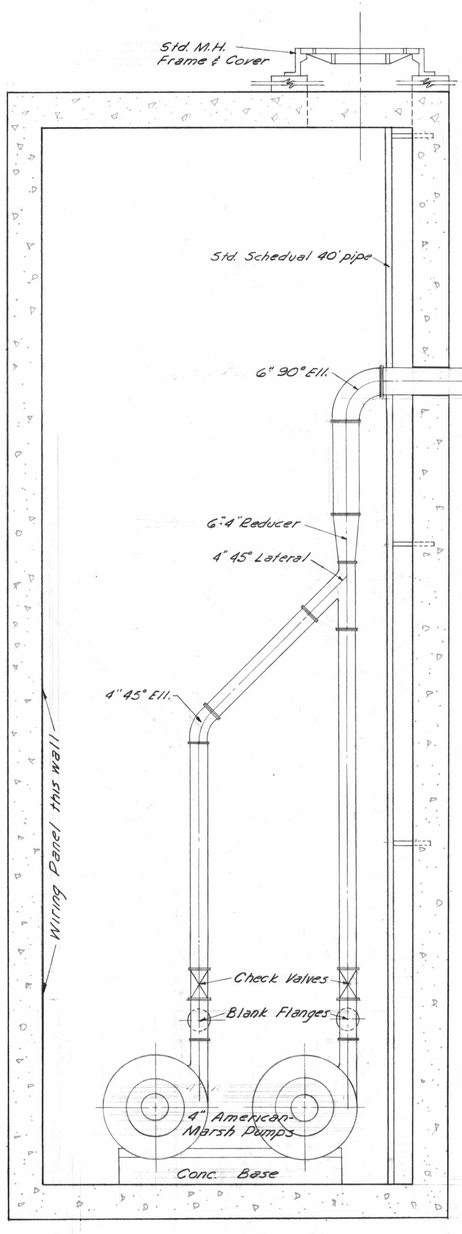

SECTION B-B

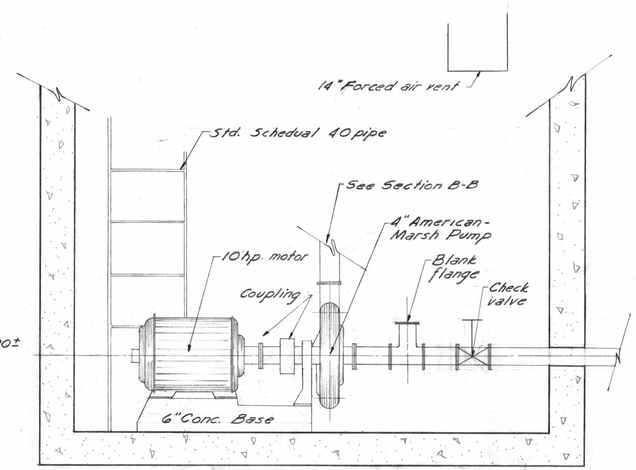

SECTION A-A

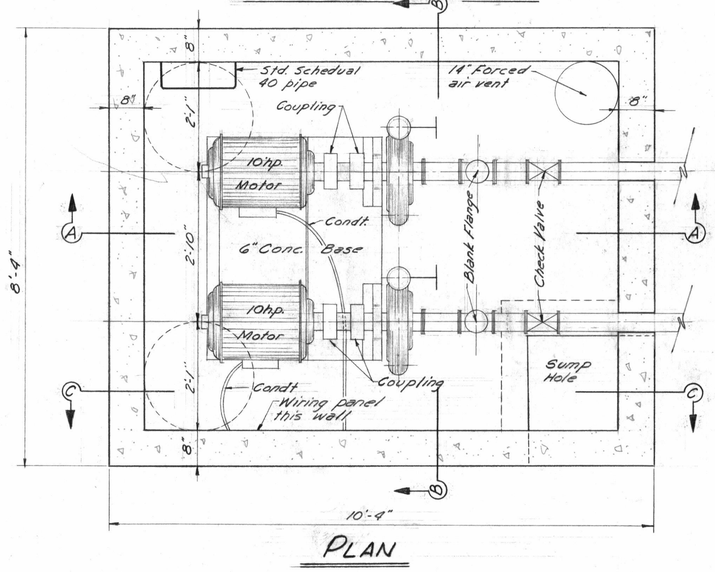

PLAN

NOTE: All dementions & locations taken from field notes

REVISION NO.	DESCRIPTION	DRAWN BY	CHECKED BY	APPROVED BY	DATE

CITY OF SAN MATEO — CALIFORNIA

38TH AVE. & EL CAMINO REAL PUMP STATION

SCALE 3/4"=1' | BOOK NO. | SURVEY BY | DRAWN BY Waugh CHK. BY | DATE 3-10-59

APPROVED

CITY ENGINEER — DATE

PLAN CASE	DRAWER	SHEET
3	7	5

Microfilmed 1966