DIST.	COUNTY	SECTION	SHEET No.	TOTAL SHEETS
II	Las	395	6	7

DATE APPROVED March 9, 1964

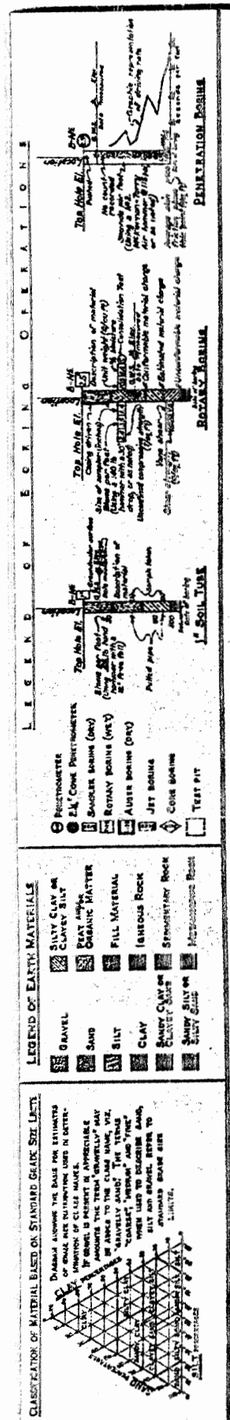

NOTE: Classification of earth material as shown on this sheet is based upon field inspection and is not to be construed to imply mechanical analysis.

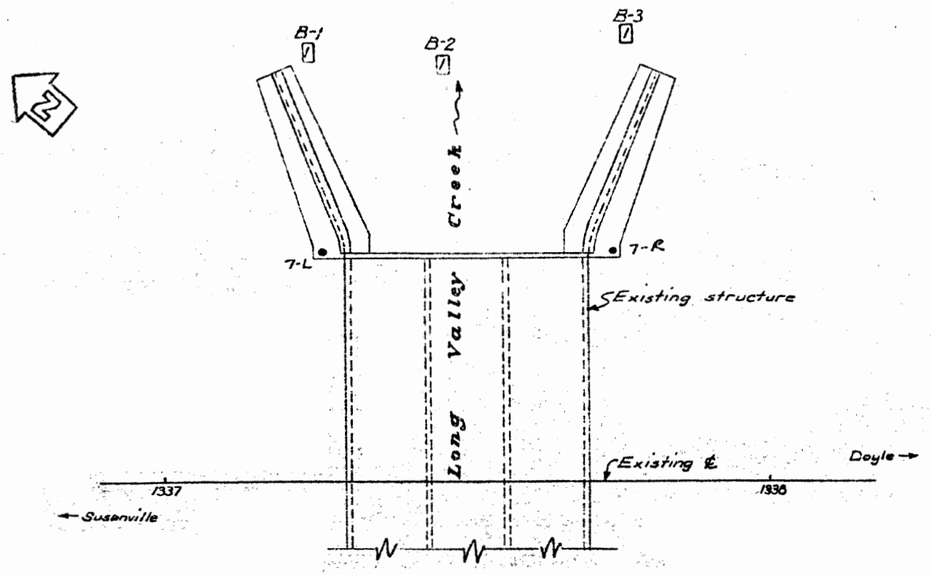

NOTE: Water surface in creek at Elev. 4137.4 6-27-67

OFFICE OF STRUCTURE FOUNDATIONS - ENGINEERING SERVICE CENTER					
As-Built Log of Test Borings sheet is considered an informational document only. As such, the State of California registration seal with signature, license number and registration certificate expiration date confirm that this is a true and accurate copy of the original document. It does not attest to the accuracy or validity of the information contained in the original document. This drawing is available and presented only for the convenience of any bidder, contractor or other interested party.					
DIST.	COUNTY	ROUTE	KILOMETER POST - TOTAL PROJECT	Sheet No.	Total Sheets
02	Las	395			
CERTIFIED ENGINEERING GEOLOGIST					
LONG VALLEY CREEK BRIDGE					
LOG OF TEST BORINGS 4 OF 4					
NOTE: A COPY OF THIS LOG OF TEST BORINGS IS AVAILABLE AT OFFICE OF STRUCTURE MAINTENANCE AND INVESTIGATIONS, SACRAMENTO, CALIFORNIA			CU: 02 EA: 36400K	BRIDGE No. 07-0056	

REGISTERED GEOLOGIST
Martha M. Merriam
No. 1957
Exp. 5-31-02
CERTIFIED ENGINEERING GEOLOGIST
STATE OF CALIFORNIA

Revisions made to this Log of Test Borings from the Original 1963 is the addition of the following table:

1. See the "As Built" plans dated June 23, 1971, for stationing. Sta. 1337+00 (English) = Sta. 407+51.76 (Metric).
2. The Division of Structure Design produced the data presented in the table below, based upon a direct conversion from English to Metric and referenced to the existing structure location. This table is presented on the "As-built" Log of Test Boring sheet for the convenience of any bidder, contractor, or other interested party.
3. Metric boring locations are as follows:

Boring	Station	Offset from C/L Route 395
B-1	407+59.4	21.6 m Lt.
B-2	407+65.8	20.7 m Lt.
B-3	407+75.2	22.2 m Lt.

SAMPLE

Pile Data Added
THIS SET OF PLANS HAS BEEN CORRECTED TO CORRESPOND TO THE "AS BUILT" PRINTS DATED 8/6/65, AS SUBMITTED BY RESIDENT ENGINEER J.W. Hufford
TRACINGS CORRECTED BY: WCH DATE: 9/3/64

AS BUILT PLANS
Contract No. 64-14022C094904
Date Completed
Document No. 20001003

STATE OF CALIFORNIA
DEPARTMENT OF PUBLIC WORKS
DIVISION OF HIGHWAYS

BRIDGE ACROSS
LONG VALLEY CREEK
WINGWALL AND BANK PROTECTION REPAIR

LOG OF TEST BORINGS

SCALE Horiz: 1"=12' Vert: 1"=10'	BRIDGE 7-56	FILE	DRAWING 0756-5

Disregard prints bearing earlier numbers → PREL. DRAWING No. PR-