FOR CONTRACT No.: 07-4T2304
PROJECT ID: 0700020017

INFORMATION HANDOUT

RECORD DRAWINGS

IRRIGATION PLANS
LOS ANGELES ROUTE 101 PM 6.3/8.3

ROUTE: 07-LA-101-6.3/8.3
PROJECT ID: 0700020017

DIST	COUNTY	ROUTE	POST MILES TOTAL PROJECT	SHEET NO.	TOTAL SHEETS
07	LA	101	6.3 / 8.3	1	26

STATE OF CALIFORNIA
BUSINESS AND TRANSPORTATION AGENCY
DEPARTMENT OF TRANSPORTATION

F-P101(81)

PROJECT PLANS FOR HIGHWAY PLANTING ON STATE HIGHWAY

IN LOS ANGELES COUNTY IN LOS ANGELES FROM SUNSET BOULEVARD TO 0.3 MILE NORTH OF PILGRIMAGE OVERCROSSING

To be supplemented by Standard Plans dated March, 1977

INDEX OF SHEETS

SHEET NO.	
1	TITLE SHEET & LOCATION MAP
2	PLANT LIST AND PLANT SPECIFICATIONS
3-10	PLANTING PLANS
11-18	IRRIGATION PLANS
19	GRADING DETAIL
20-24	MISCELLANEOUS DETAIL SHEETS
25-26	TRAFFIC CONTROL SYSTEM FOR LANE CLOSURES

APPLICABLE STANDARD SHEETS
A78-A.1
ES-2A
ES-8
ES-13

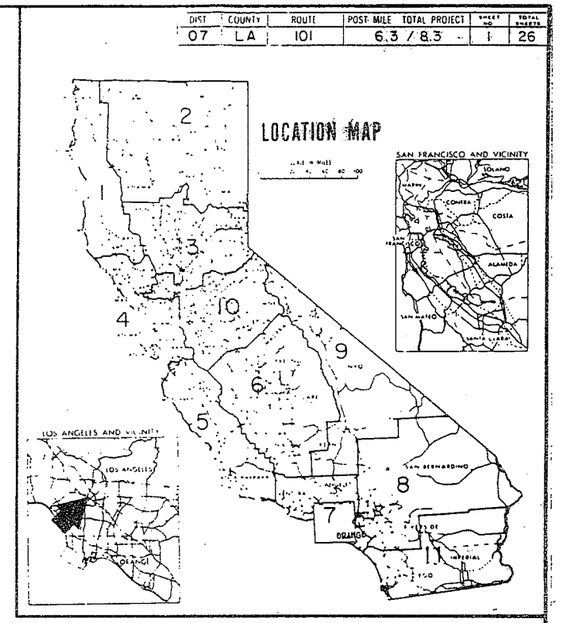

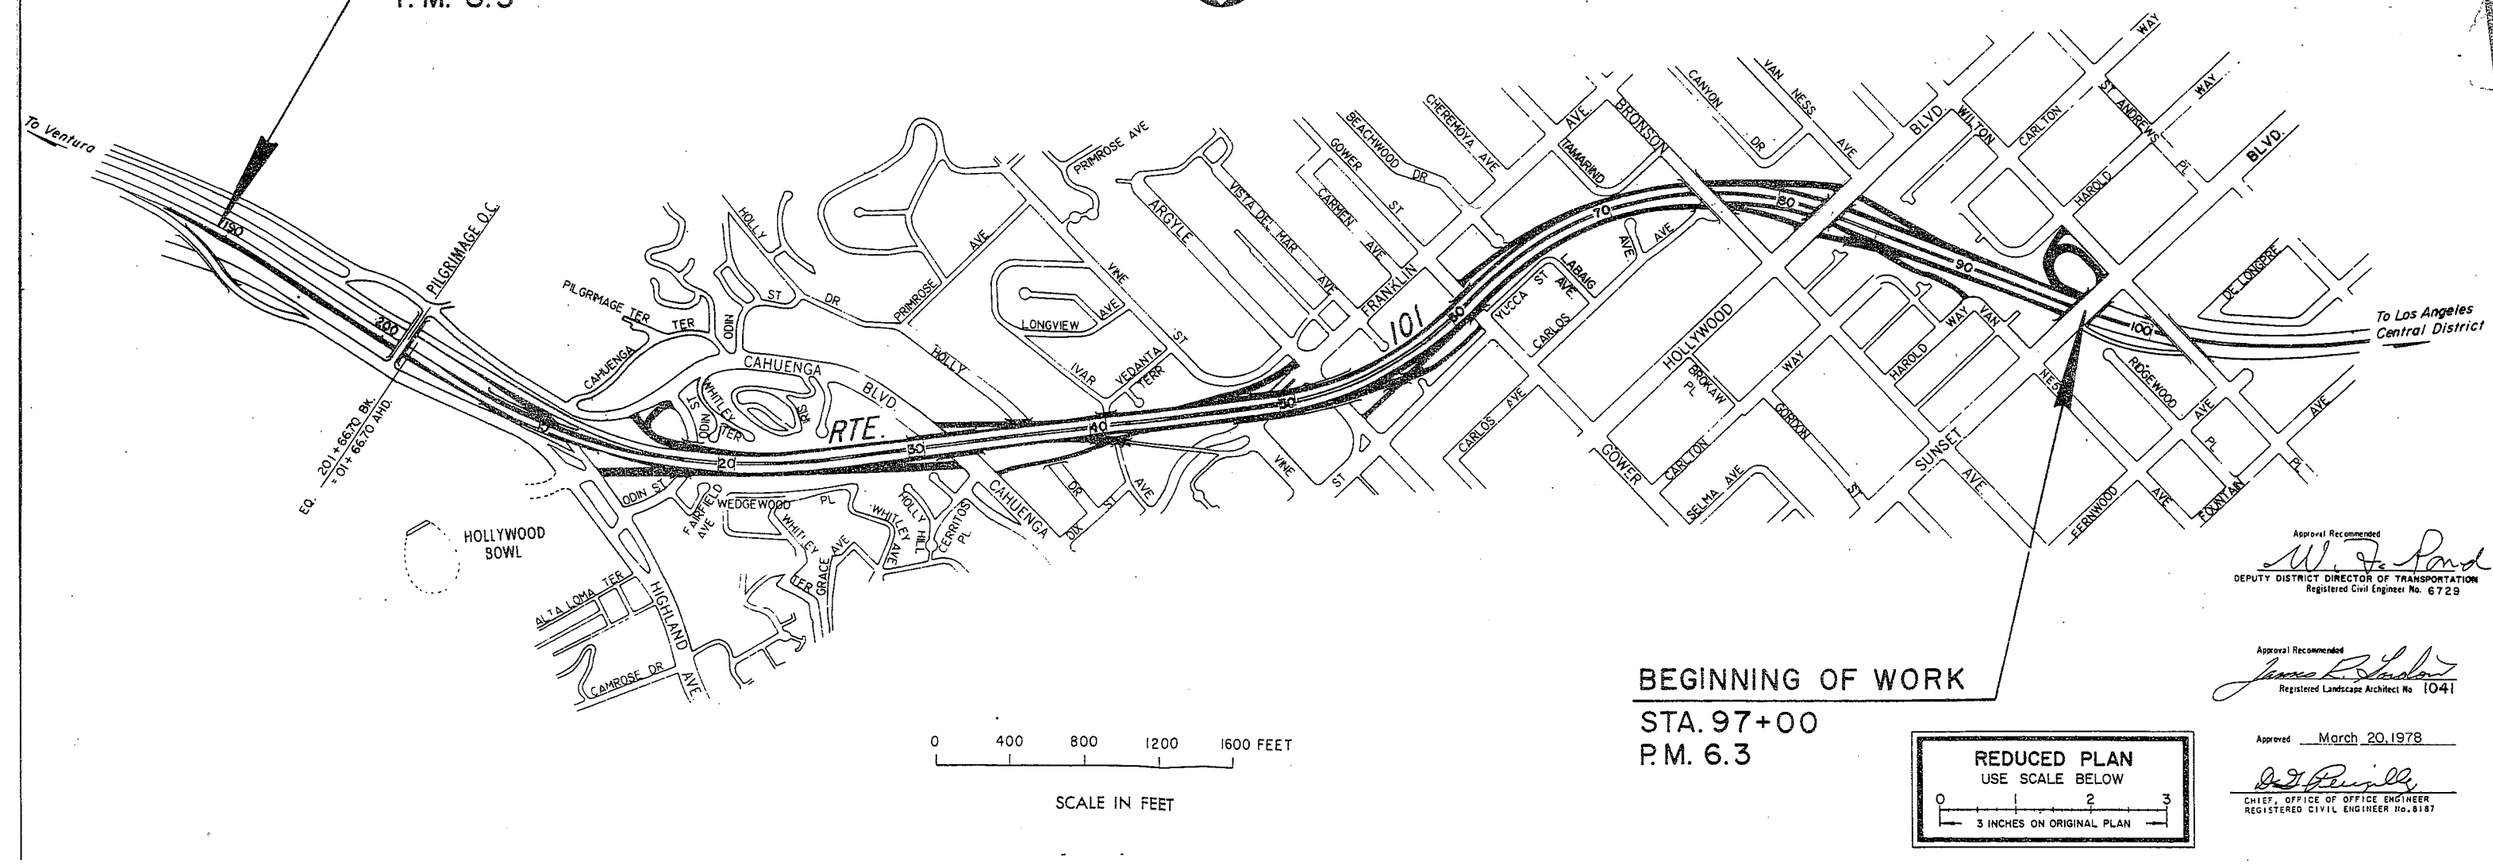

REDUCED PLAN
USE SCALE BELOW
0 2 3
3 INCHES ON ORIGINAL PLAN

Approval Recommended
DEPUTY DISTRICT DIRECTOR OF TRANSPORTATION
Registered Civil Engineer No. 6729

Approval Recommended
Registered Landscape Architect No. 1041

Approved March 20, 1978
CHIEF, OFFICE OF OFFICE ENGINEER
REGISTERED CIVIL ENGINEER No. 8187

DIST.	COUNTY	ROUTE	POST MILES—TOTAL PROJECT	SHEET NO.	TOTAL SHEETS
07	LA	101	6.3/8.3	11	26

LANDSCAPE ARCHITECT. [signature]
REGISTRATION NO. 1139
DATE APPROVED. March 20, 1978

IRRIGATION LEGEND

NEW	EXISTING: TO REMAIN	EXISTING: TO BE REMOVED OR ABANDONED	
			SUPPLY LINE (G.S.P.) BELOW GRADE UNLESS OTHERWISE NOTED.
			G.S.P. CROSSOVER IN CONDUIT
N.L.			NOZZLE LINE W/ TURNING UNION (N.L.)
			CUT AND CAP PIPE
			REMOVE EXIST. SPRINKLER CONNECTION (S.C.) AND INSTALL SPRINKLER TYPE A-3 (SEE SPRINKLER SCHEDULE)
			4' CHAIN LINK GATE (TYPE CL-6)

NEW	EXISTING: TO REMAIN	EXISTING: TO BE REMOVED OR ABANDONED	
			MANUAL CONTROL VALVE (M.C.V.)
			MASTER REMOTE CONTROL VALVE (M.R.C.V.)
			REMOVE EXIST. MANUAL CONTROL VALVE AND INSTALL ELECTRIC REMOTE CONTROL VALVE (R.C.V.)
			PRESSURE REDUCING VALVE (P.R.V.)
			GATE VALVE (G.V.)
			QUICK COUPLING VALVE
			ELECTRIC REMOTE CONTROL VALVE (R.C.V.)
			GARDEN VALVE
			WATER METER
			REDUCED PRESSURE BACKFLOW PREVENTER (R.P.B.P.)
			REMOVE EXIST. BACKFLOW PREVENTER AND INSTALL REDUCED PRESSURE BACKFLOW PREVENTER (R.P.B.P.)
			EXIST. POWER SOURCE (POLE #_____)
			ELECTRIC AUTOMATIC CONTROLLER (E.A.C.)
			CONTROL AND NEUTRAL CONDUCTORS (24 V.)
			ELECTRICAL CONDUIT AND WIRES (120 V.) (REQUIRED PULL BOX NOT SHOWN)
			SUPPLY LINE (P.V.C.)
			SPRINKLER CONNECTION
			SPRINKLER HEAD
			E.A.C. SERVICE PEDESTAL
			C-2 HEAD AT EACH PLANT WITH P.V.C. PIPE

R.C.V. CODE:
1"-A-3 → STATION ON CONTROLLER
E.A.C.
R.C.V. SIZE

FOR IRRIGATION NOTES SEE SHT. I/2

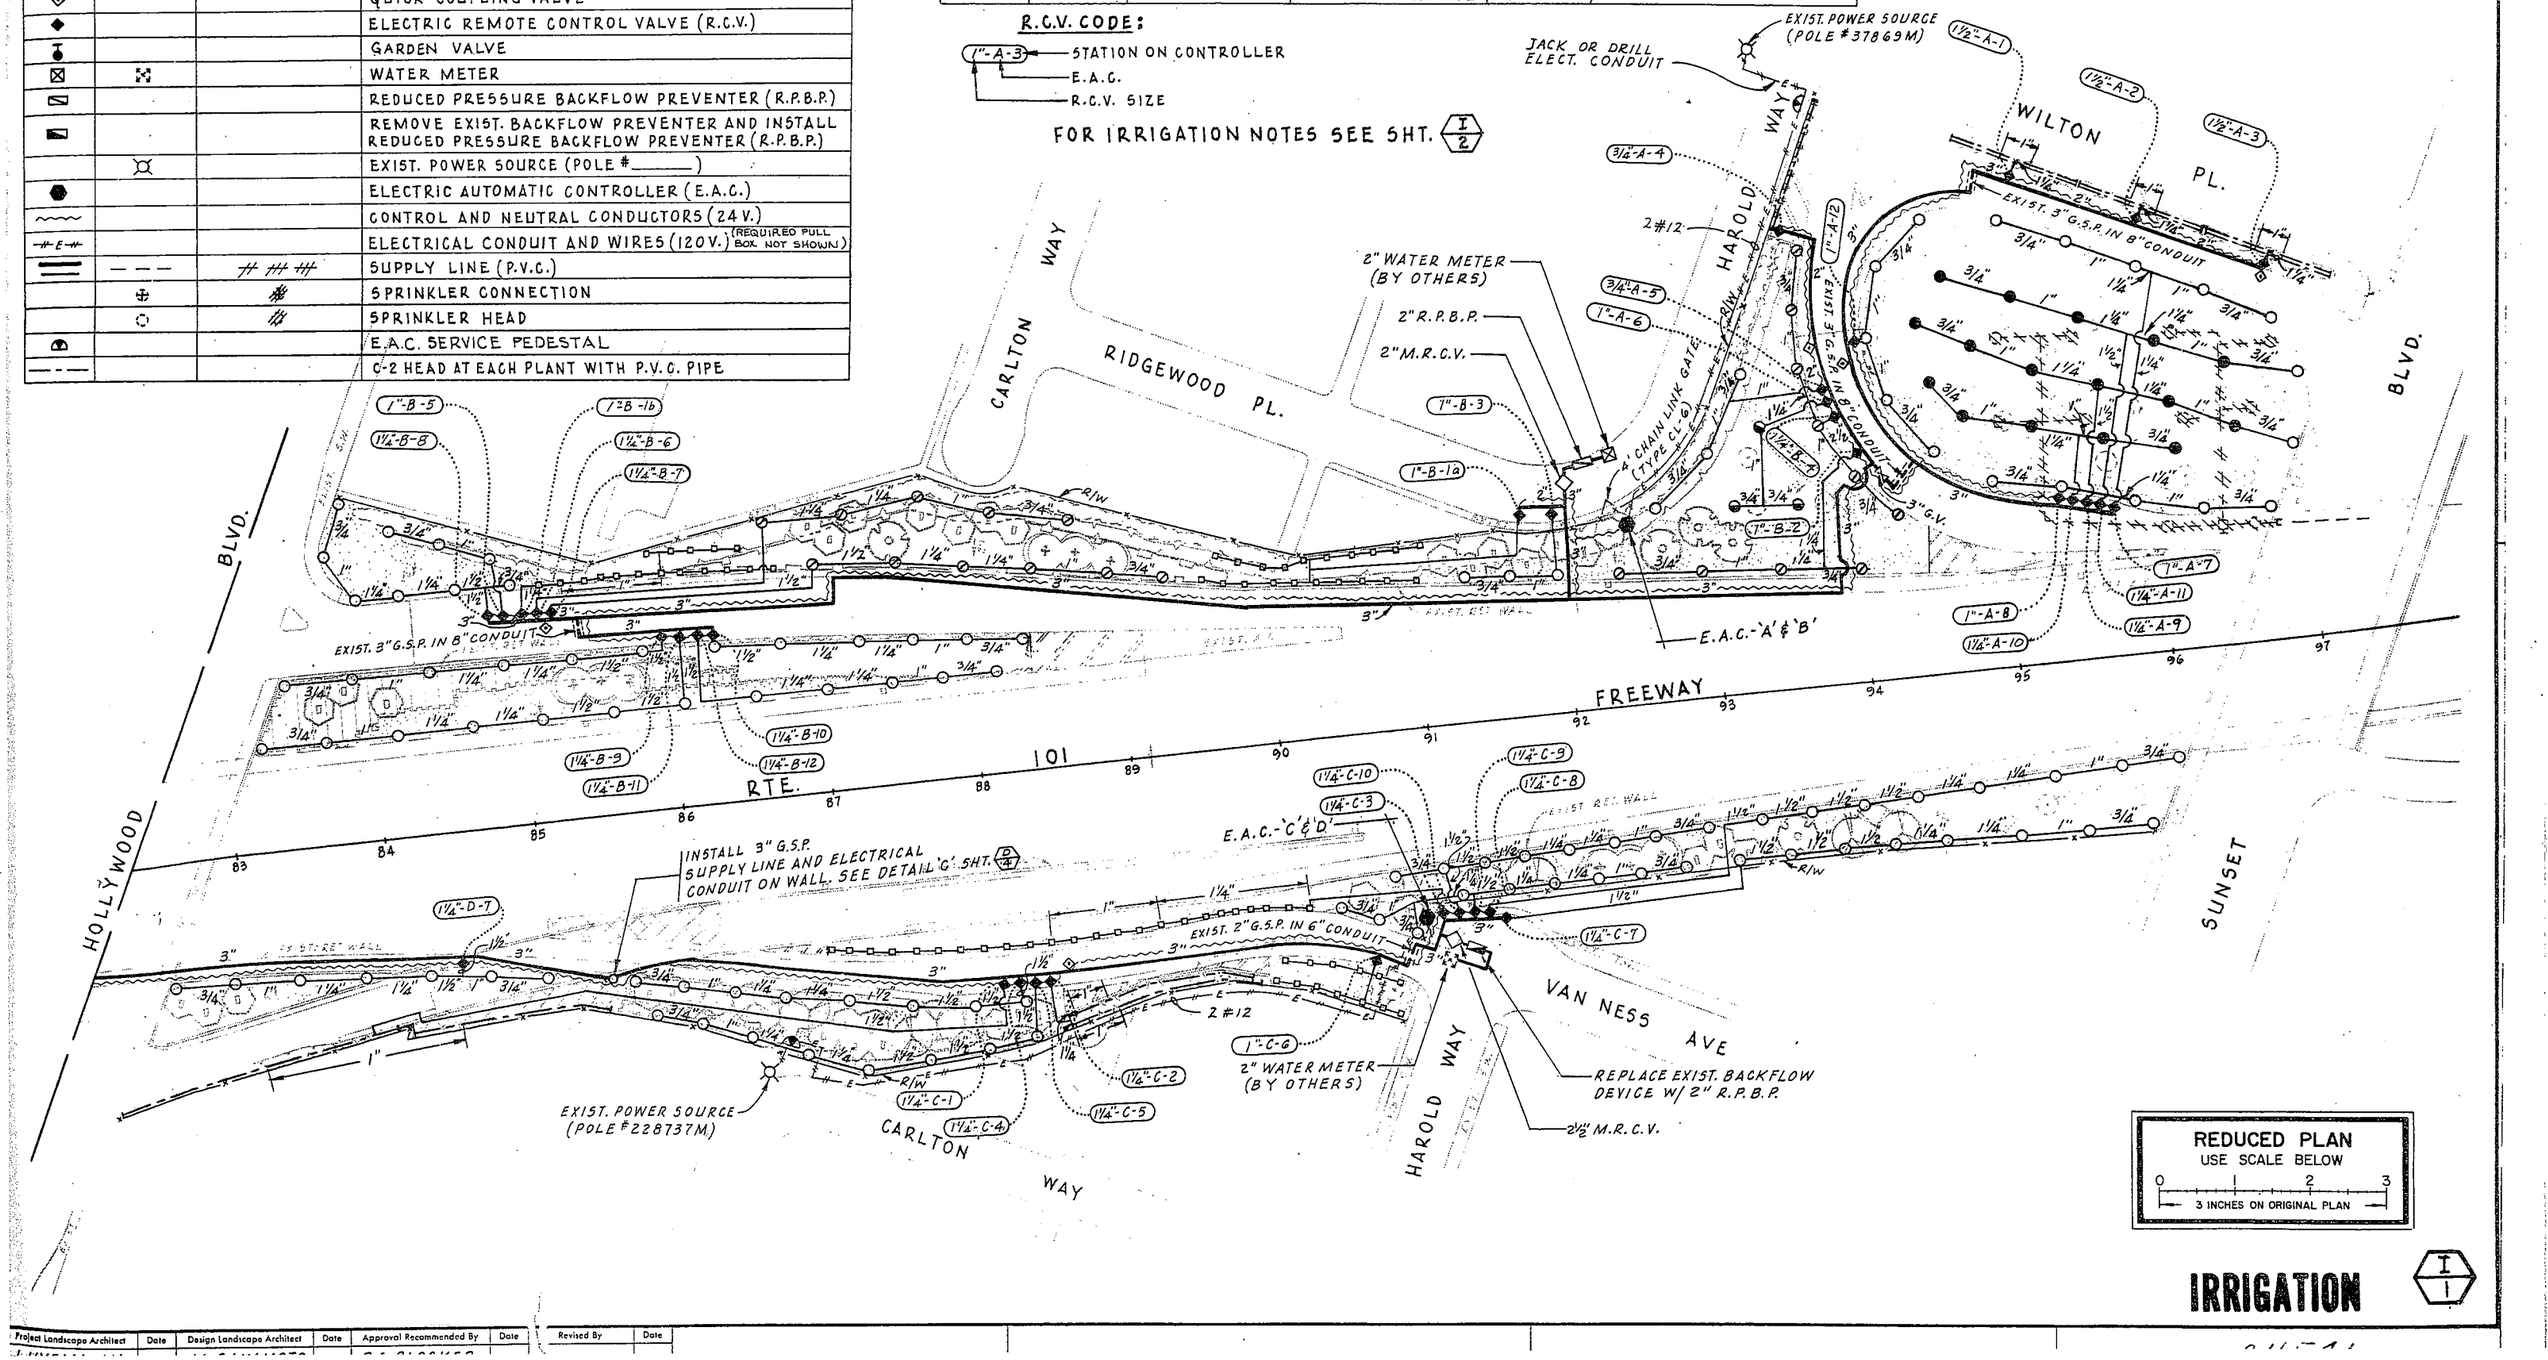

REDUCED PLAN
USE SCALE BELOW
0 2 3
3 INCHES ON ORIGINAL PLAN

IRRIGATION

I/1

Project Landscape Architect	Date	Design Landscape Architect	Date	Approval Recommended By	Date	Revised By	Date

DIST.	COUNTY	ROUTE	POST MILES—TOTAL PROJECT	SHEET NO	TOTAL SHEETS
07	LA	101	6.3/8.3	12	26

LANDSCAPE ARCHITECT Dave Oppenheimer

REGISTRATION NO. 1139

DATE APPROVED March 20, 1978

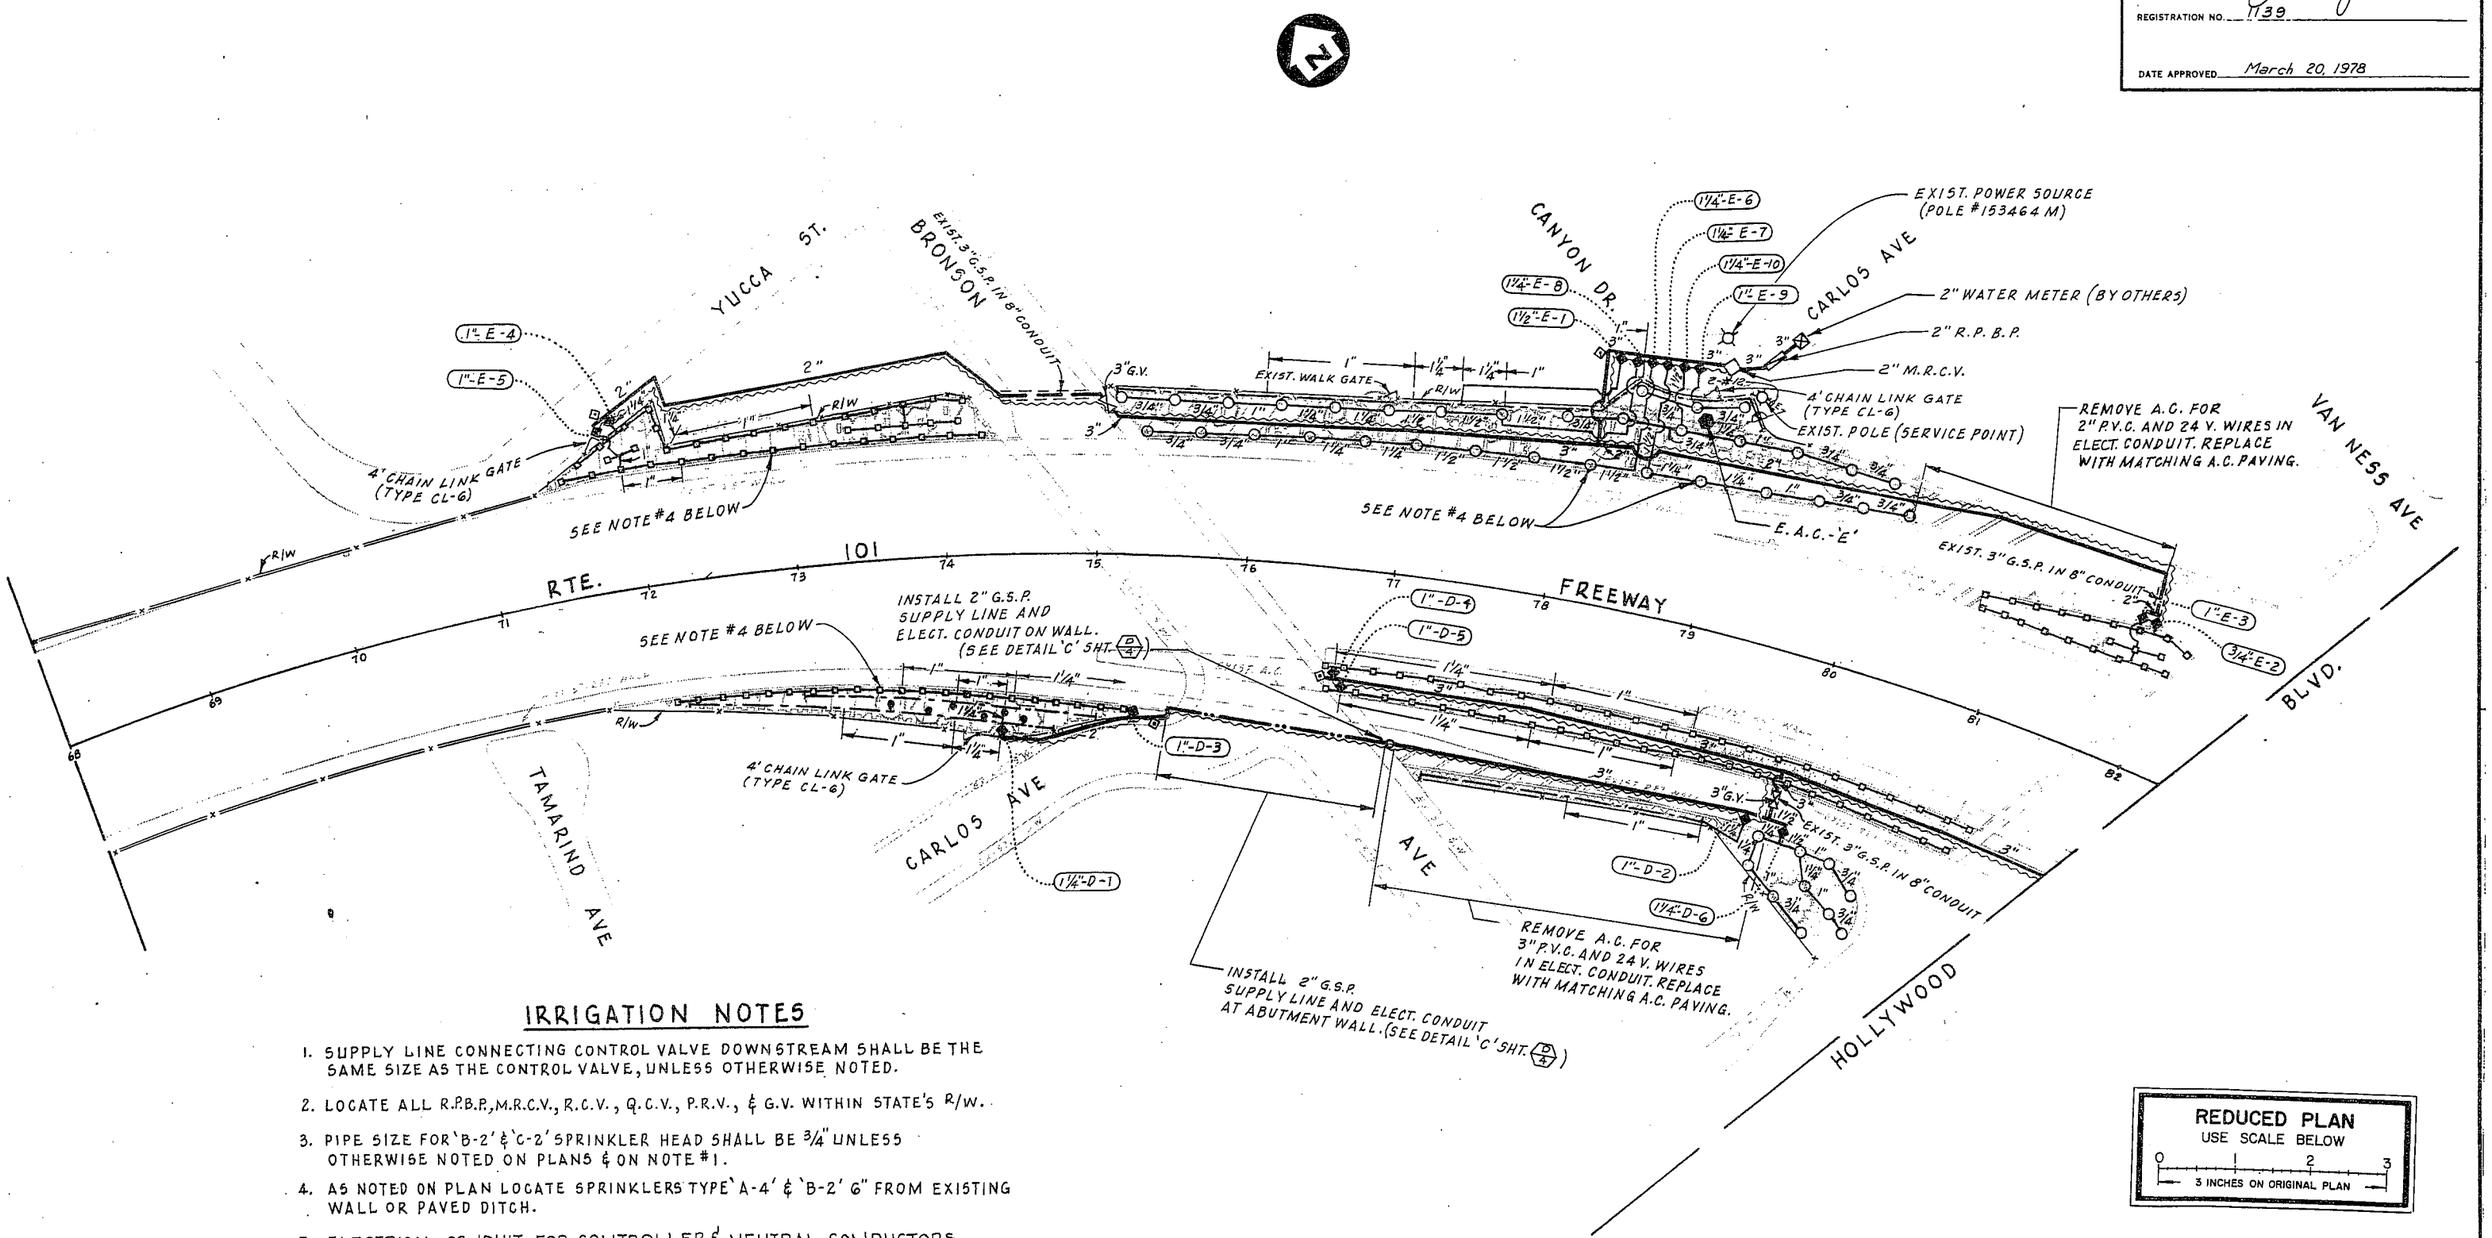

IRRIGATION NOTES

1. SUPPLY LINE CONNECTING CONTROL VALVE DOWNSTREAM SHALL BE THE SAME SIZE AS THE CONTROL VALVE, UNLESS OTHERWISE NOTED.
2. LOCATE ALL R.P.B.P., M.R.C.V., R.C.V., Q.C.V., P.R.V., & G.V. WITHIN STATE'S R/W.
3. PIPE SIZE FOR 'B-2' & 'C-2' SPRINKLER HEAD SHALL BE ¾" UNLESS OTHERWISE NOTED ON PLANS & ON NOTE #1.
4. AS NOTED ON PLAN LOCATE SPRINKLERS TYPE 'A-4' & 'B-2' 6" FROM EXISTING WALL OR PAVED DITCH.
5. ELECTRICAL CONDUIT FOR CONTROLLER & NEUTRAL CONDUCTORS SHALL TERMINATE IN A NO. 3½ PULL BOX.

REDUCED PLAN
USE SCALE BELOW
0 1 2 3
3 INCHES ON ORIGINAL PLAN

ect Landscape Architect	Date	Design Landscape Architect	Date	Approval Recommended By	e	Revised By	Date
							3-6-78

IRRIGATION I/2

211541

DIST.	COUNTY	ROUTE	POST MILES—TOTAL PROJECT	SHEET No.	TOTAL SHEETS
07	LA	101	6.3/8.3	13	26

LANDSCAPE ARCHITECT (signature)
REGISTRATION NO. 1139
DATE APPROVED March 20, 1978

REDUCED PLAN
USE SCALE BELOW
0 1 2 3
3 INCHES ON ORIGINAL PLAN

IRRIGATION I/3

Project Landscape Architect	Date	Design Landscape Architect	Date	Approval Recommended By	Date	Revised By	Date
							3-6-78

011541

DIST.	COUNTY	ROUTE	POST MILES—TOTAL PROJECT	SHEET No.	TOTAL SHEETS
07	LA	101	6.3/8.3	14	26

LANDSCAPE ARCHITECT [signature]

REGISTRATION NO. 1139

DATE APPROVED March 20 1978

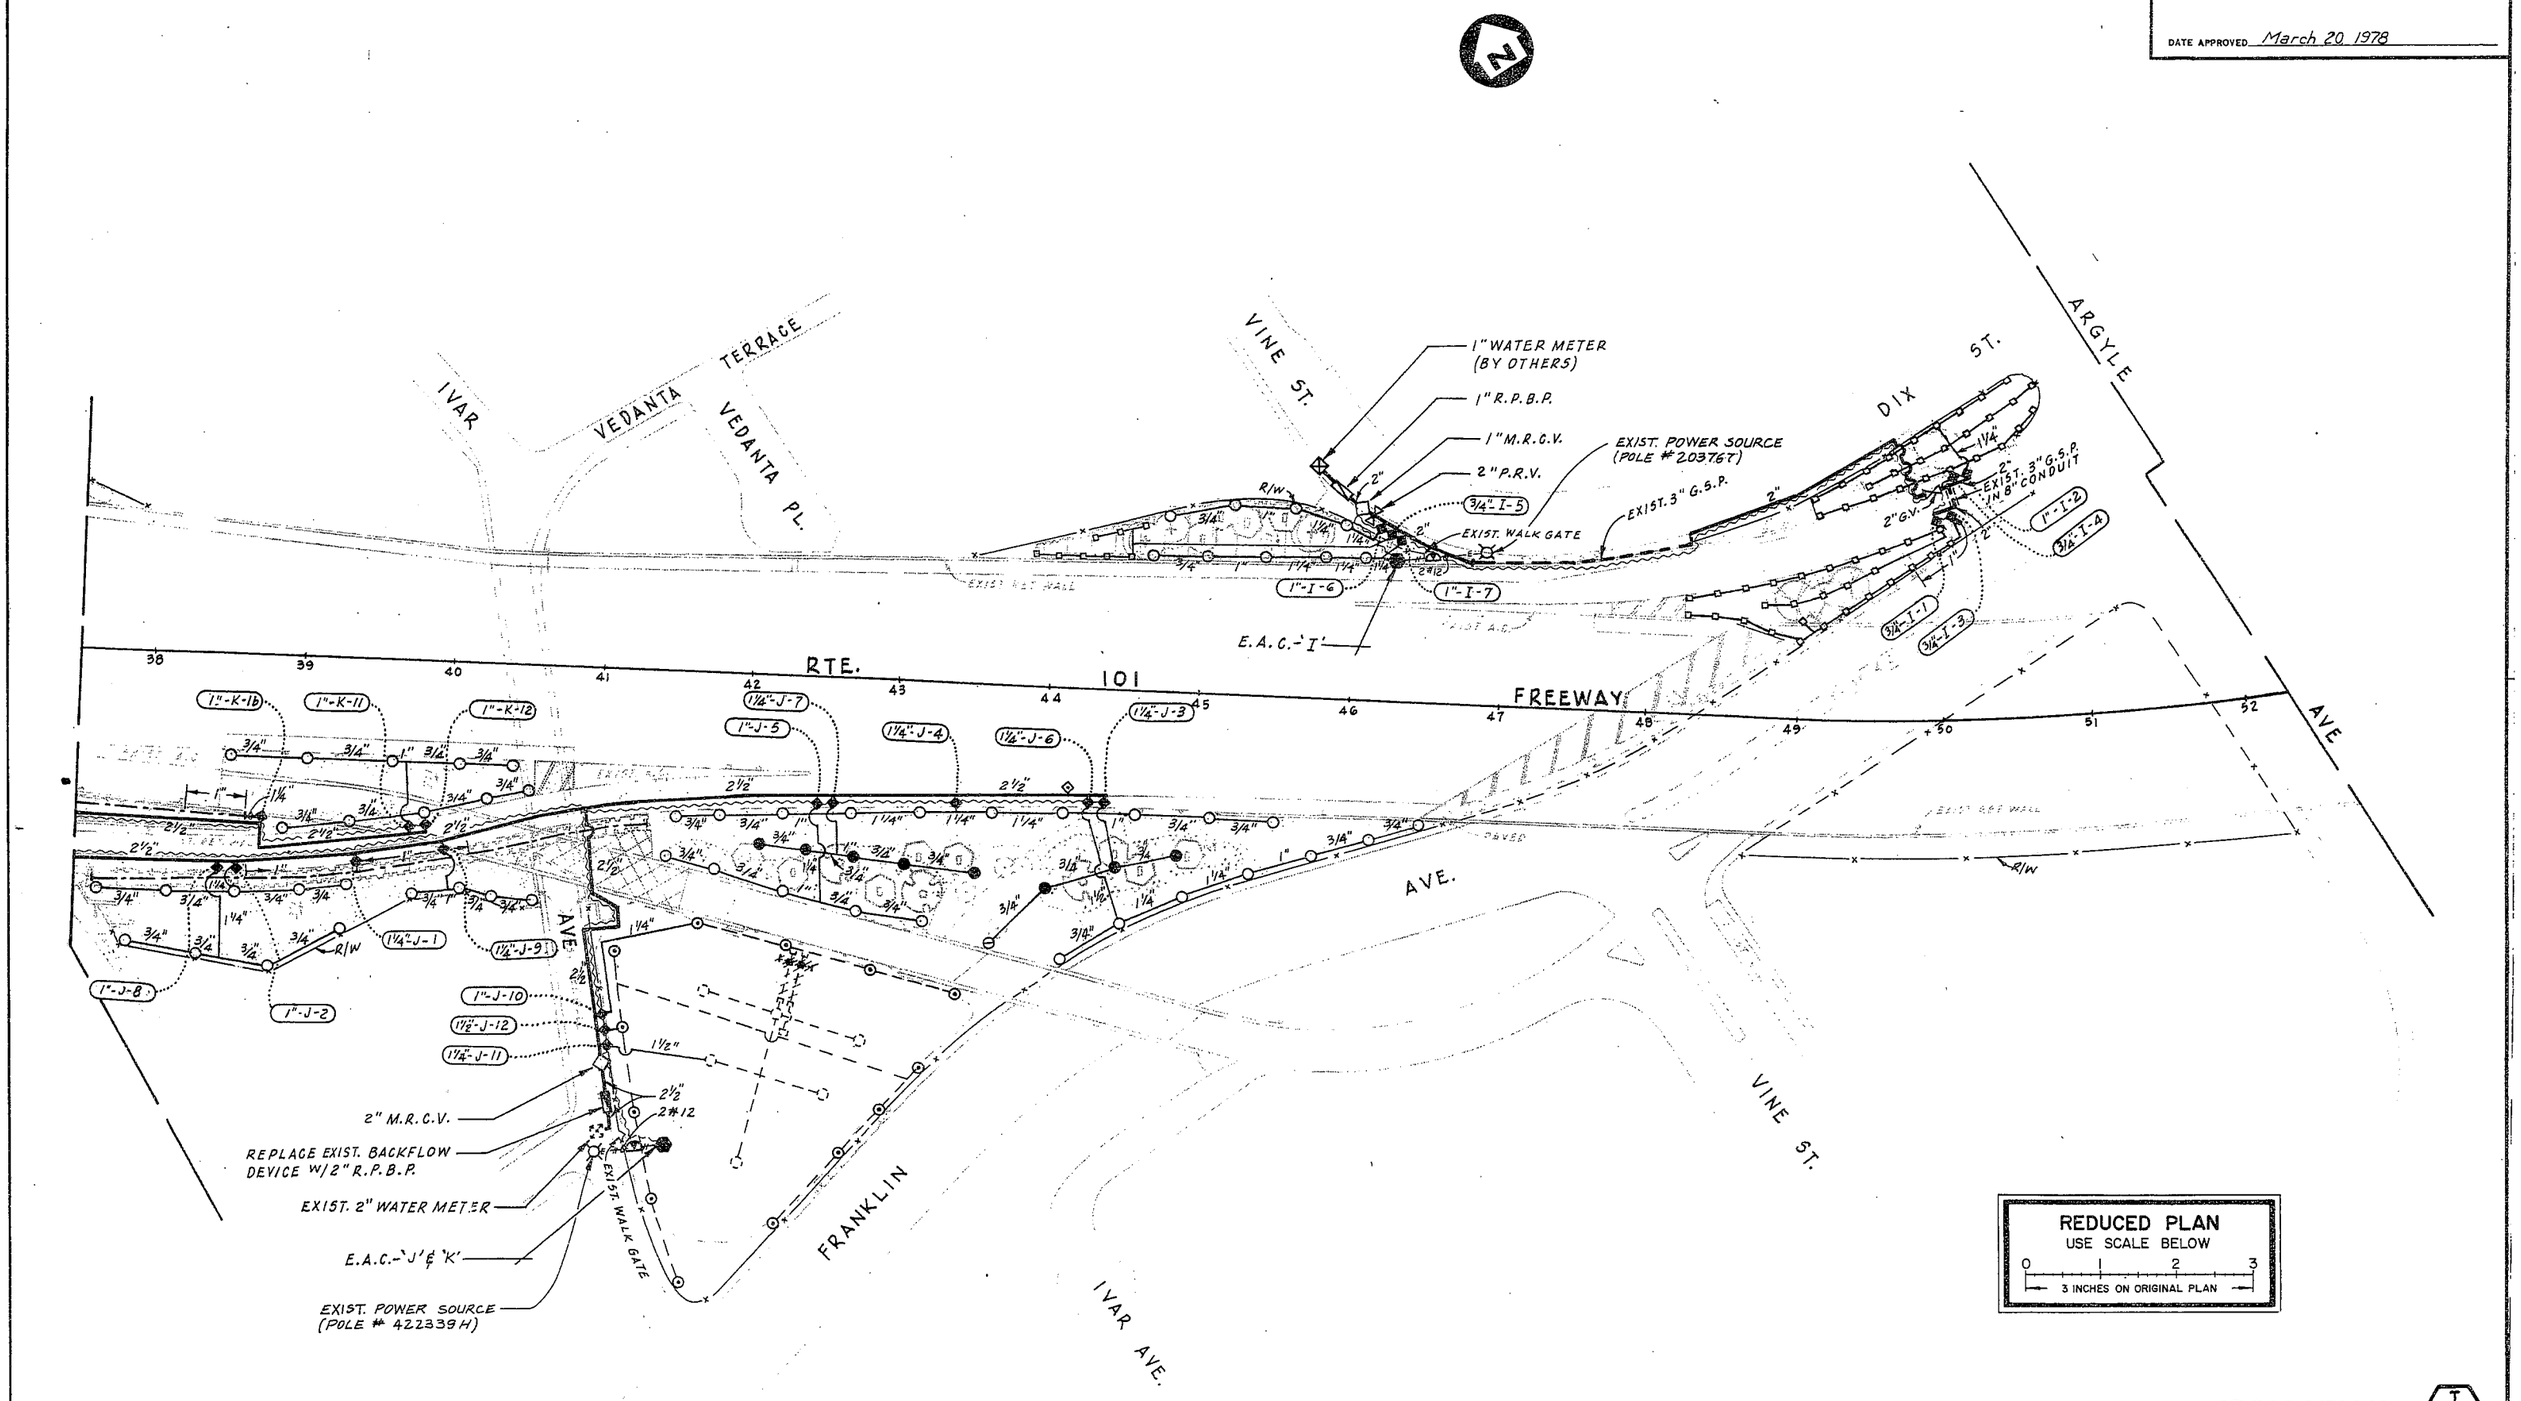

REDUCED PLAN
USE SCALE BELOW
0 1 2 3
3 INCHES ON ORIGINAL PLAN

IRRIGATION

I/4

Project Landscape Architect	Date	Design Landscape Architect	Date	Approval Recommended By	Date	Revised By	Date
							3-6-78

DIST.	COUNTY	ROUTE	POST MILES—TOTAL PROJECT	SHEET No.	TOTAL SHEETS
07	LA	101	6.3/8.3	15	26

LANDSCAPE ARCHITECT [signature]

REGISTRATION NO. 1139

DATE APPROVED March 20, 1978

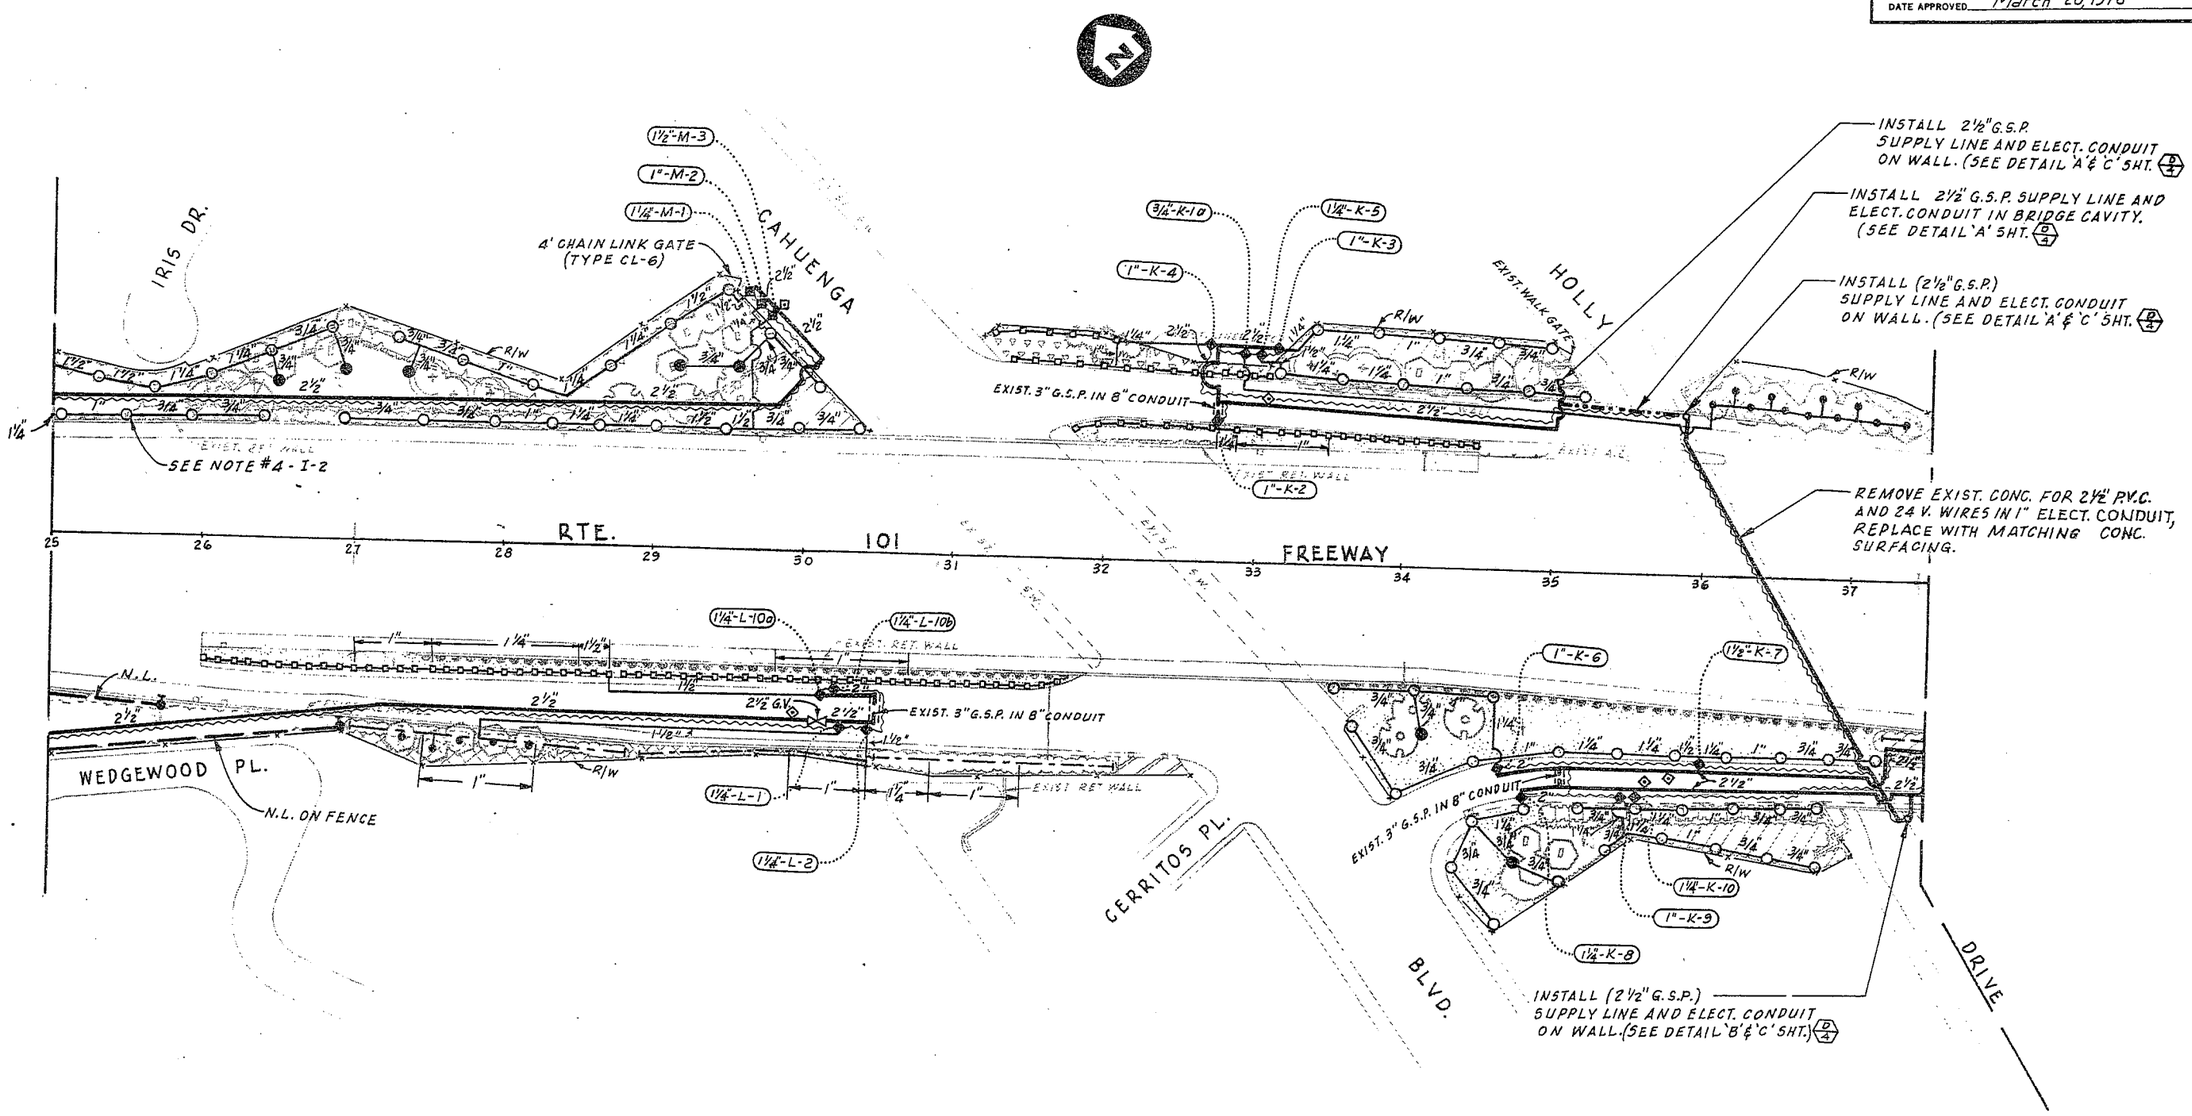

REDUCED PLAN
USE SCALE BELOW
0 1 2 3
3 INCHES ON ORIGINAL PLAN

IRRIGATION

I/5

Project Landscape Architect	Date	Design Landscape Architect	Date	Approval Recommended By	Date	Revised By	Date
[illegible]		M. SAKAMOTO		R. E. BLOCKER		L.T.	3-6-78

011541

DIST.	COUNTY	ROUTE	POST MILES—TOTAL PROJECT	SHEET No.	TOTAL SHEETS
07	LA	101	6.3/8.3	16	26

LANDSCAPE ARCHITECT [signature]

REGISTRATION NO. 1139

DATE APPROVED March 20, 1978

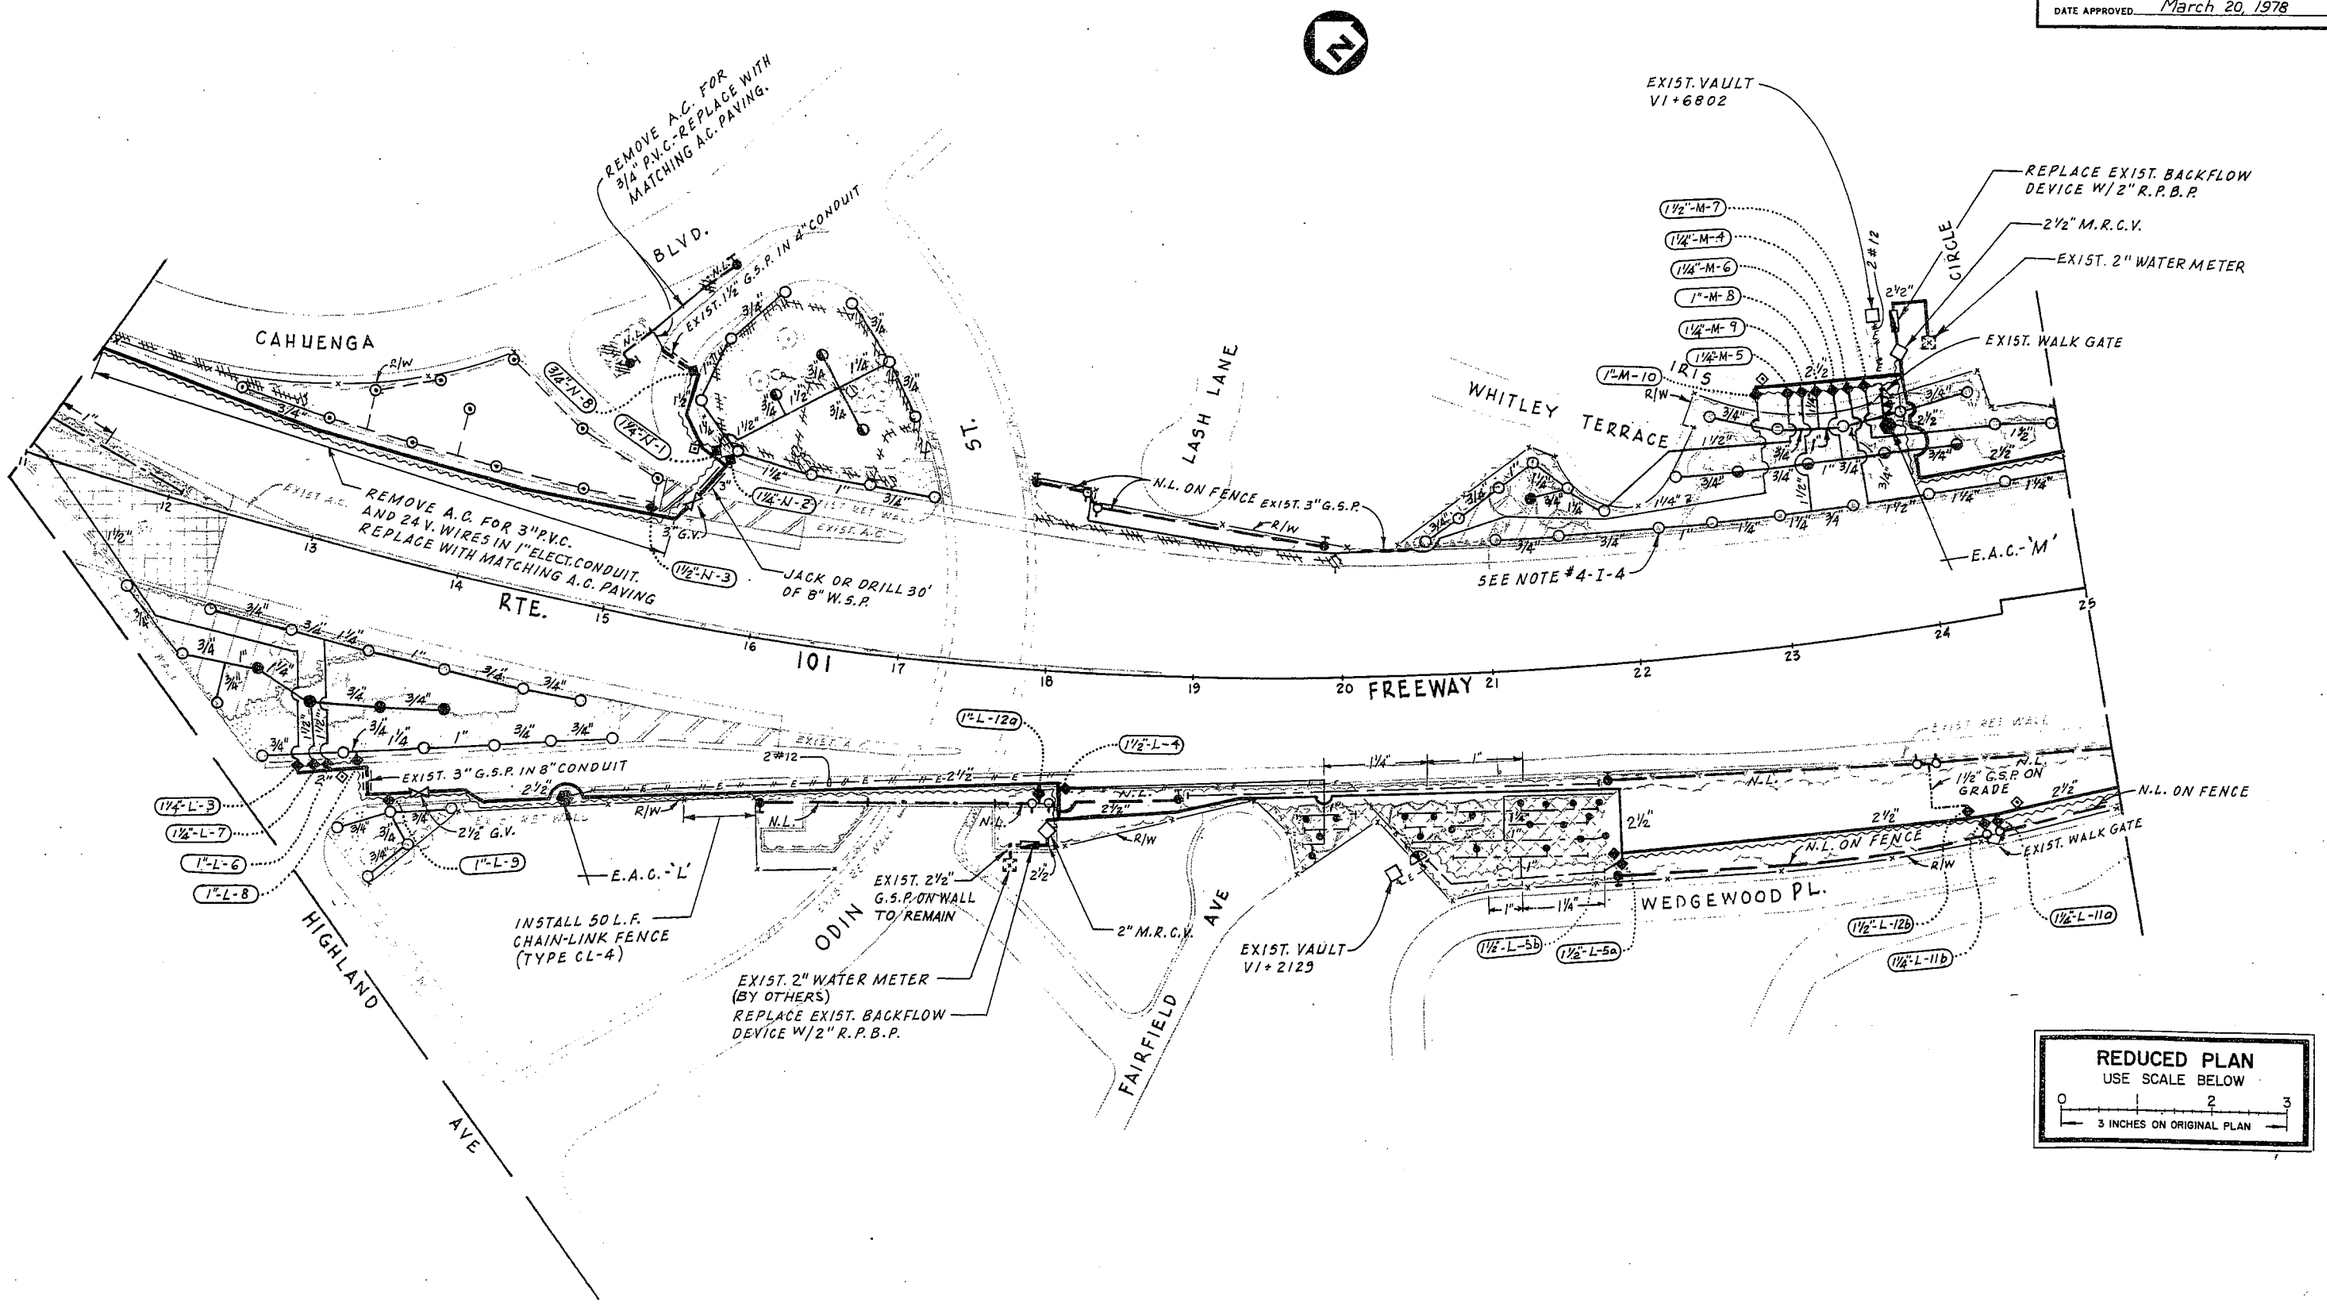

REDUCED PLAN
USE SCALE BELOW
0 1 2 3
3 INCHES ON ORIGINAL PLAN

IRRIGATION

I/6

Project Landscape Architect	Date	Design Landscape Architect	Date	Approval Recommended By	Date	Revised By	Date
[illegible]		M. SAKAMOTO		R. E. BLOCKER		[illegible]	3-6-78

DIST.	COUNTY	ROUTE	POST MILES—TOTAL PROJECT	SHEET NO.	TOTAL SHEETS
07	LA	101	6.3/8.3	17	26

LANDSCAPE ARCHITECT [signature]

REGISTRATION NO. 1139

DATE APPROVED March 20, 1978

REDUCED PLAN
USE SCALE BELOW
0 1 2 3
3 INCHES ON ORIGINAL PLAN

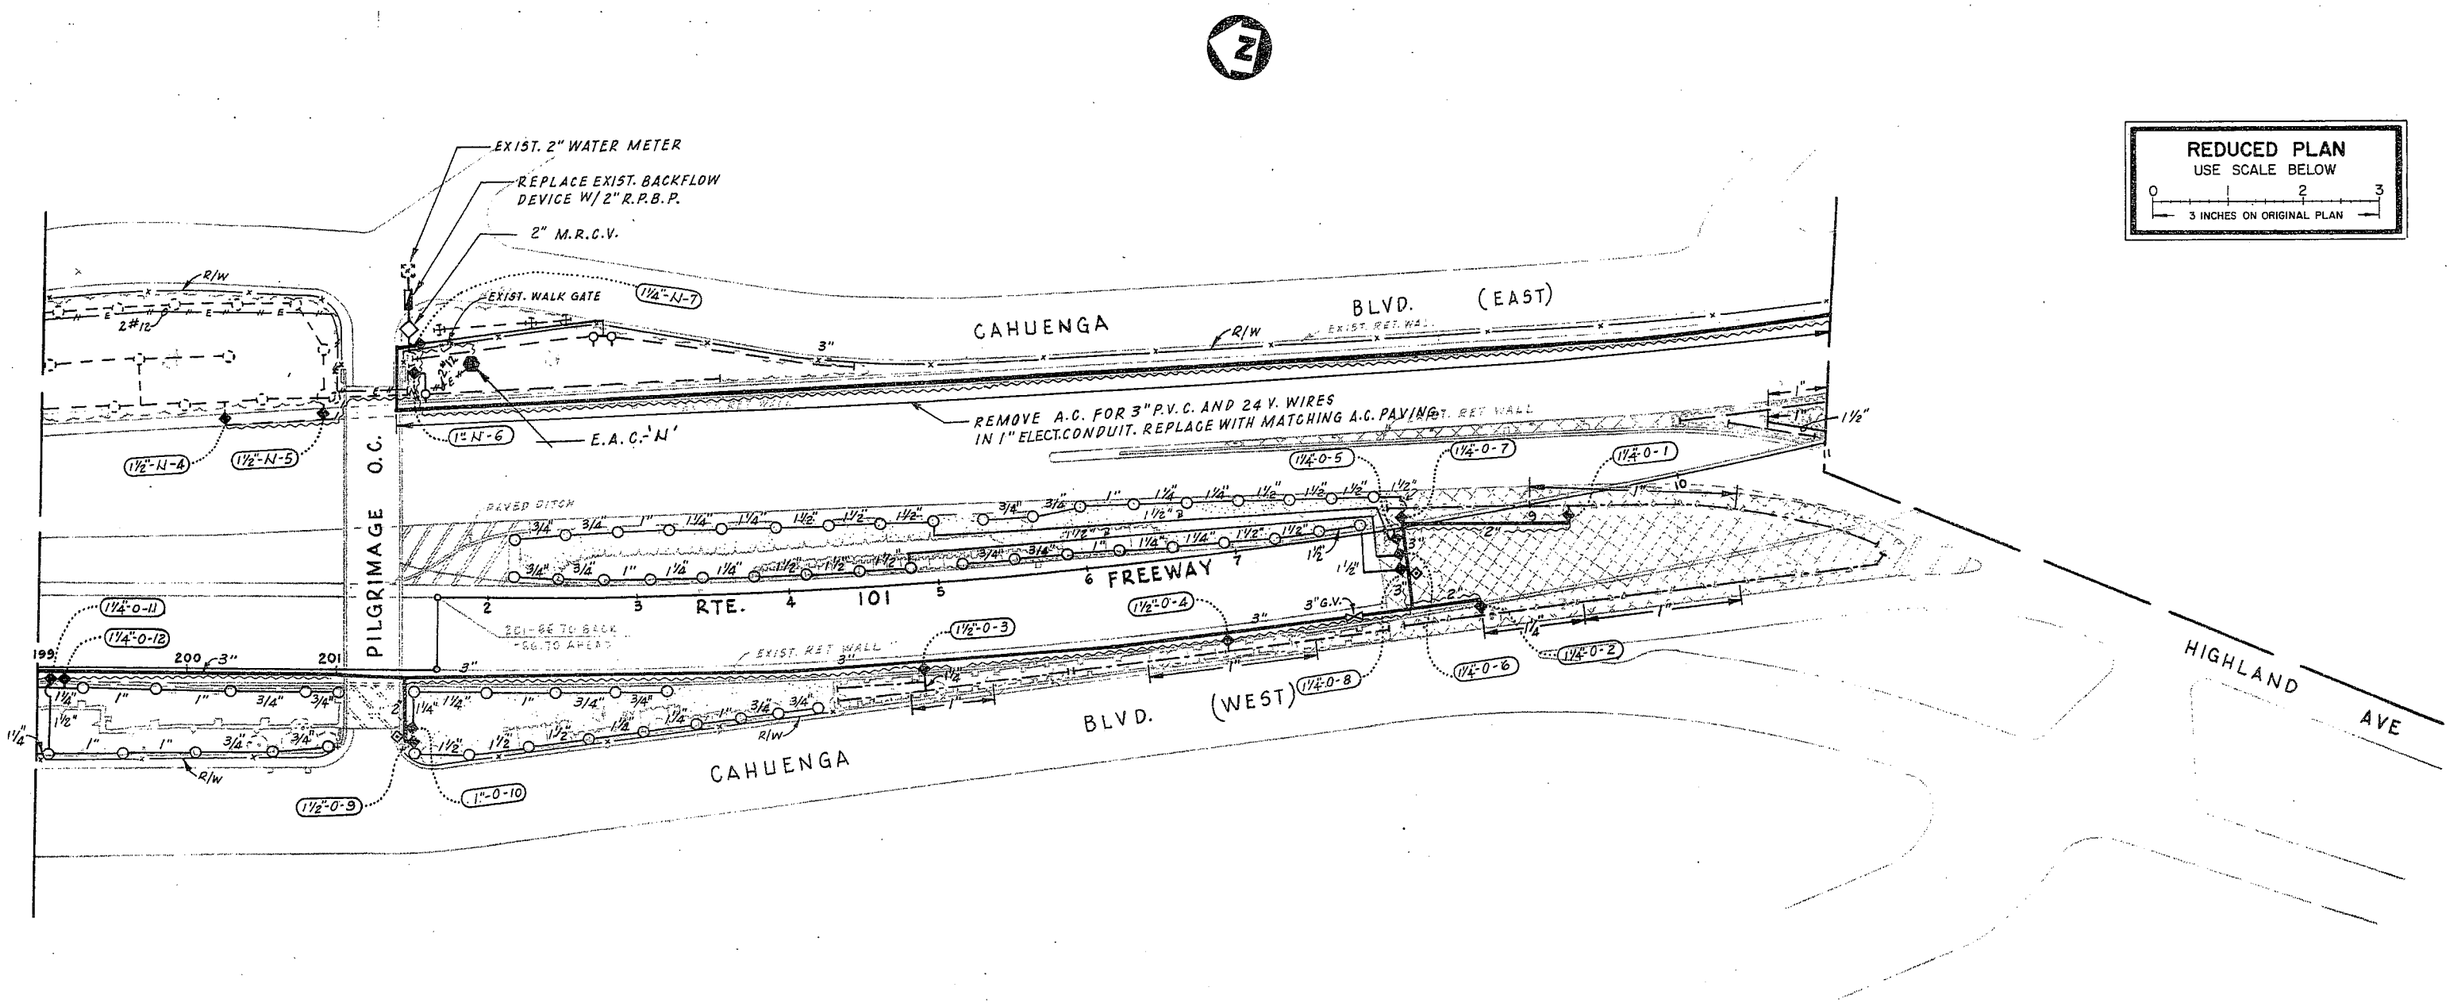

IRRIGATION

I/7

Landscape Architect	Date	Design Landscape Architect	Date	Approval Recommended By	Date	Revised By	Date

DIST.	COUNTY	ROUTE	POST MILES—TOTAL PROJECT	SHEET No.	TOTAL SHEETS
07	LA	101	6.3/8.3	18	26

LANDSCAPE ARCHITECT [signature]
REGISTRATION NO. 1139
DATE APPROVED March 20, 1978

REDUCED PLAN
USE SCALE BELOW
0 1 2 3
3 INCHES ON ORIGINAL PLAN

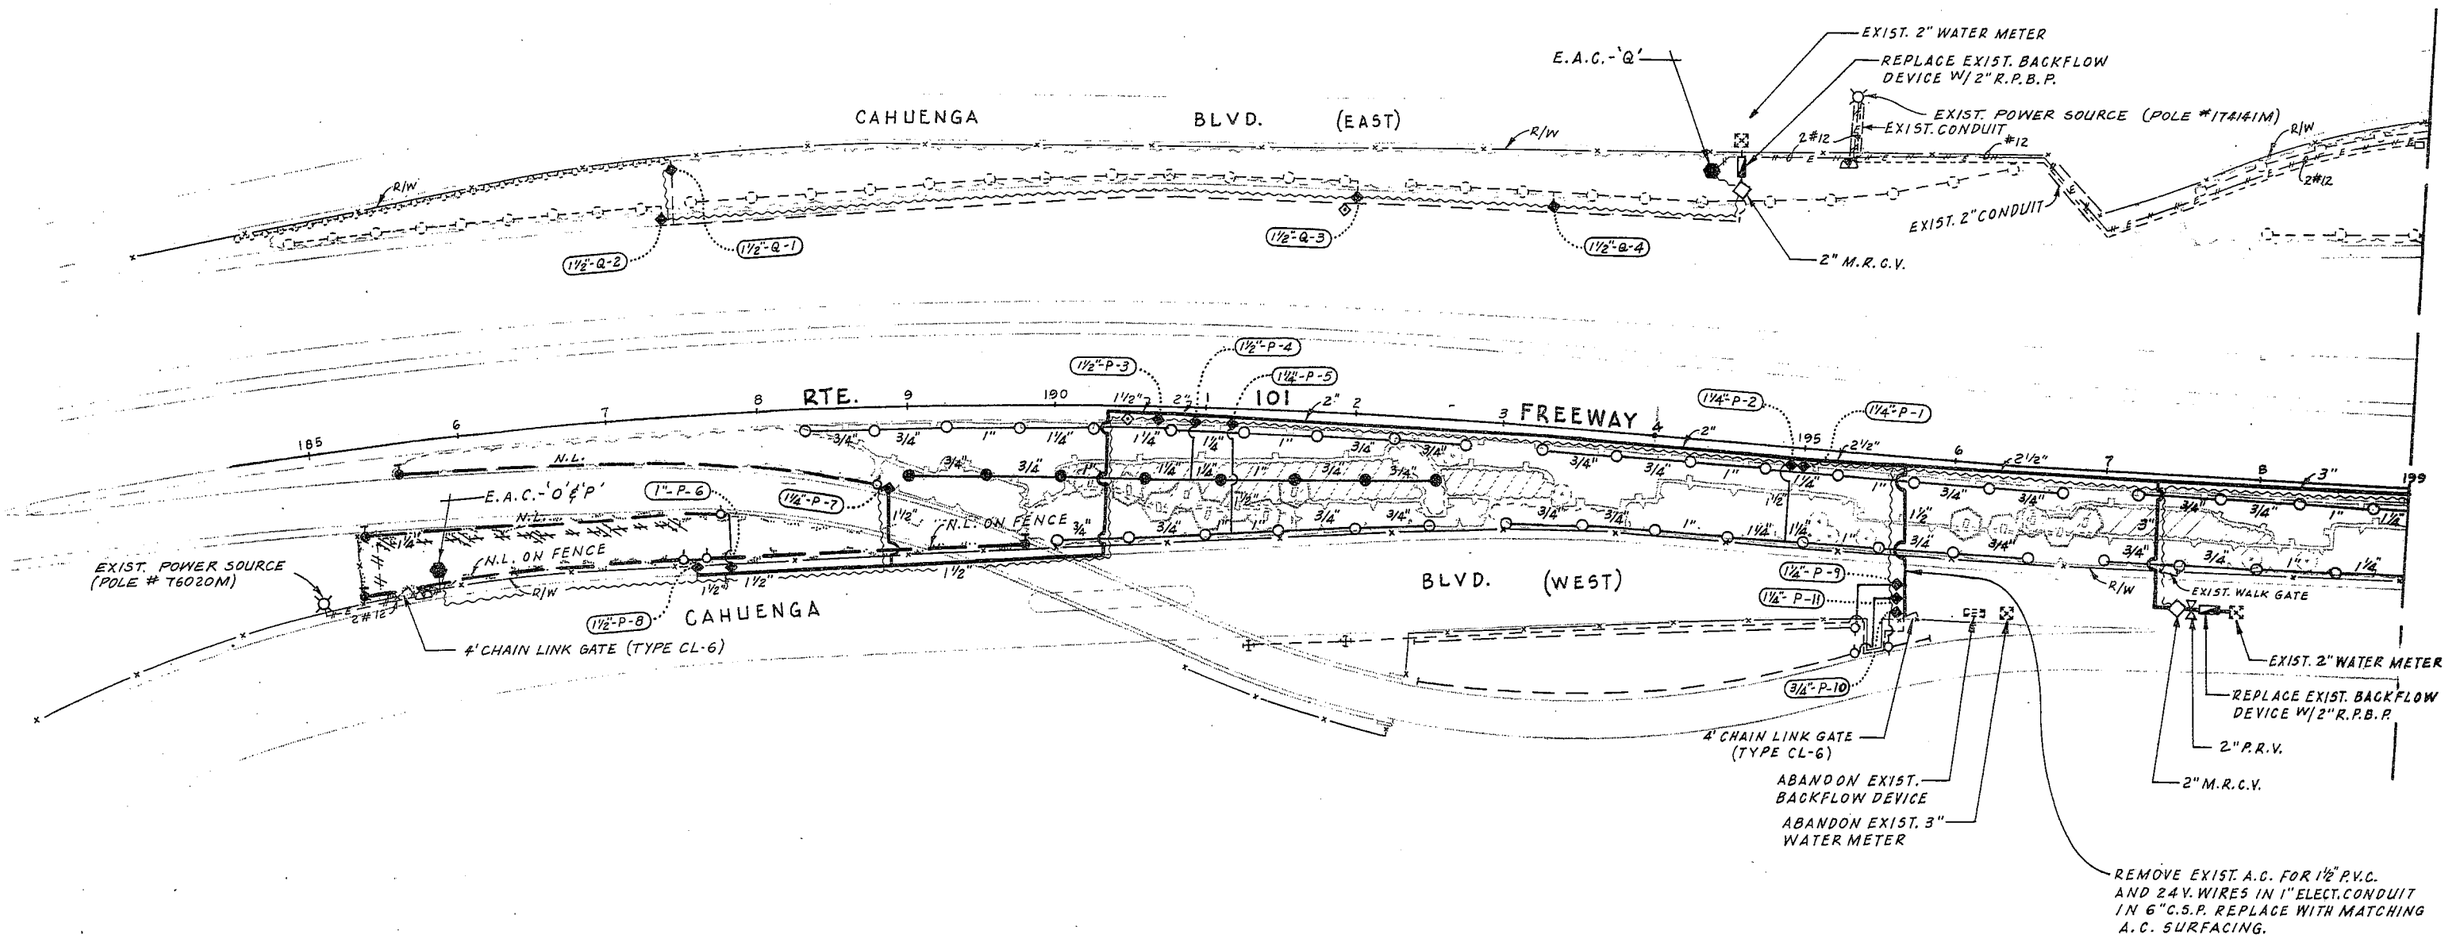

IRRIGATION

I/8

Project Landscape Architect	Date	Design Landscape Architect	Date	Approval Recommended By	Date	Revised By	Date
L. UYEMATSU		M. SAKAMOTO		R. E. BLOCKER		L.T.	3-6-78

011541