DIST	COUNTY	ROUTE	KILOMETER POST TOTAL PROJECT	SHEET No	TOTAL SHEETS
04	SF,Ala	80	12.2/14.3 0.0/4.0	407a 06S13	1204

Syn Yee Chin 03/08/10
REGISTERED ELECTRICAL ENGINEER DATE

05-06-2010
PLANS APPROVAL DATE

REGISTERED PROFESSIONAL ENGINEER
SYN YEE CHIN
No. 18186
Exp. 09/30/2011
ELECTRICAL
STATE OF CALIFORNIA

PB AMERICAS, Inc.
A Parsons Brinckerhoff Company
303 Second St., Suite 700N
San Francisco, CA 94107-1317

The State of California or its officers or agents shall not be responsible for the accuracy or completeness of electronic copies of this plan sheet.

Caltrans now has a web site! To get to the web site, go to http://www.dot.ca.gov

Caltrans Metric

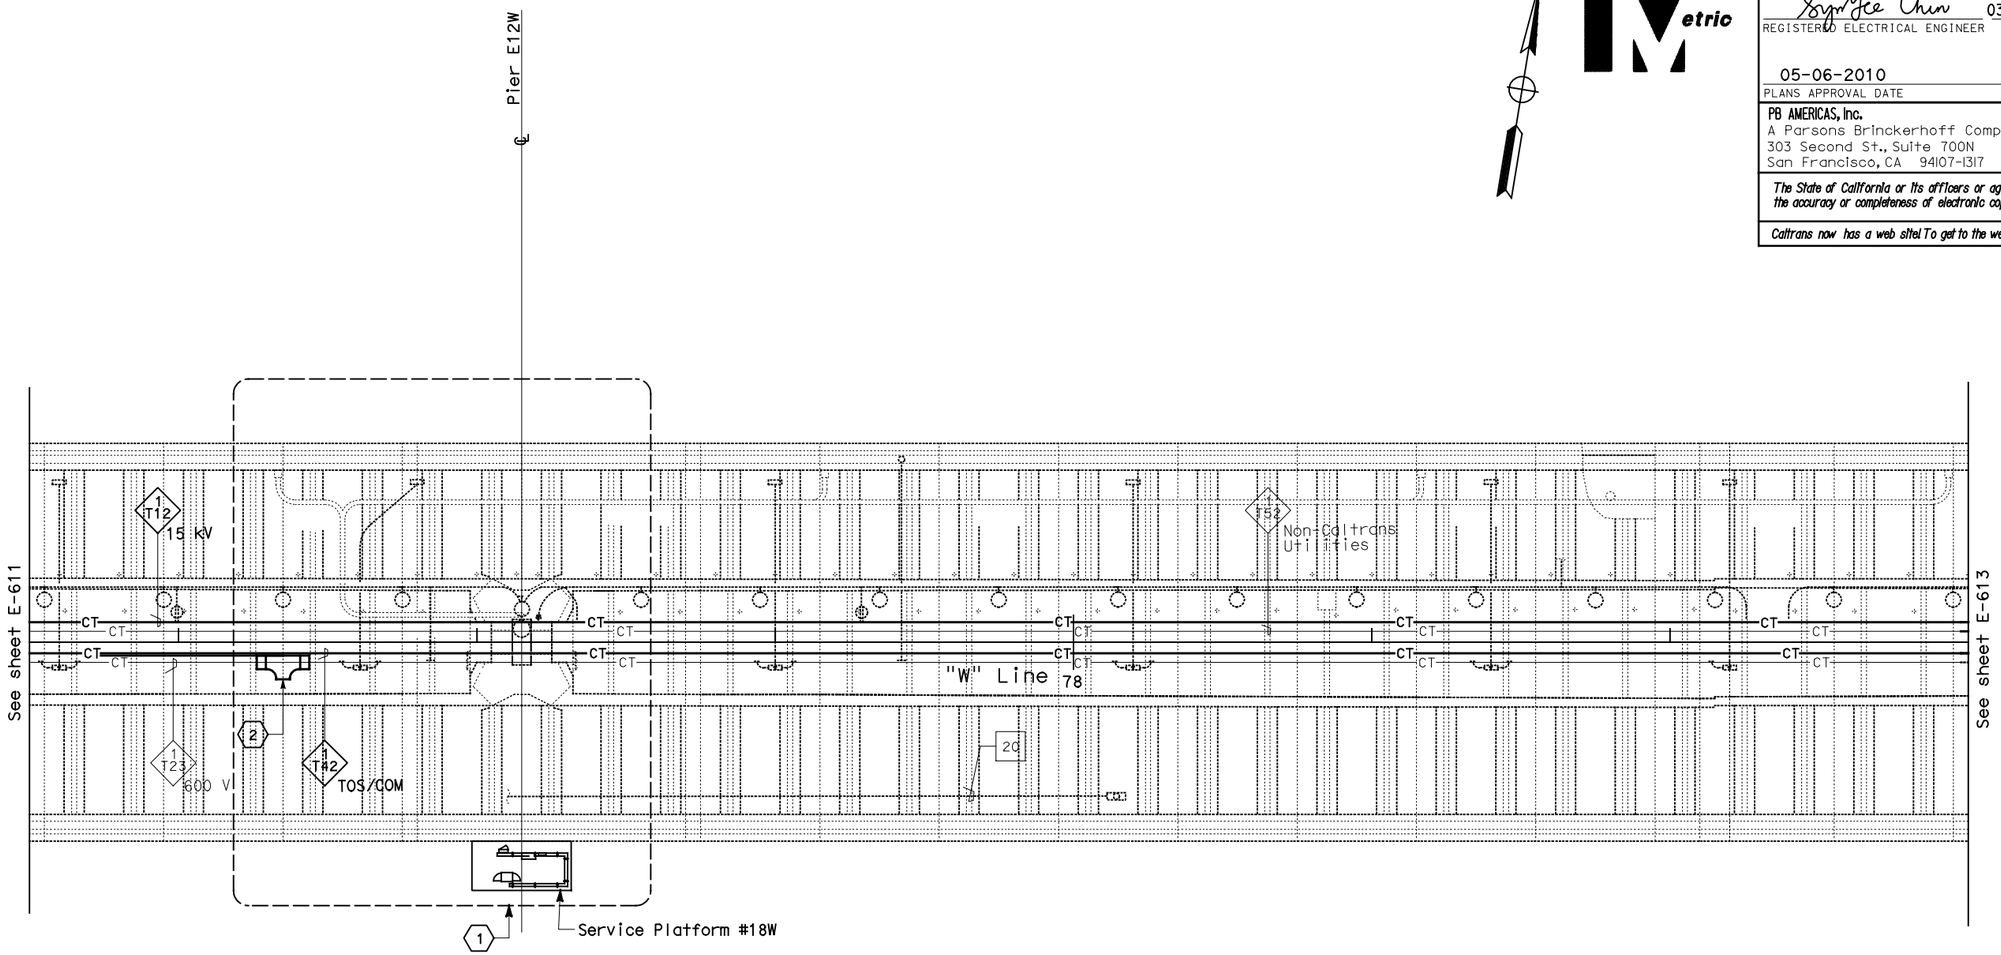

CONDUIT AND CABLE TRAY PLAN

NOTES:

1. This plan sheet is a record drawing from Skyway Structures contract. The Contractor shall verify the existing installation. See sheet EE-73 from Skyway Structures, contract No. 04-012024.
2. The installed components shall not be limited to the ones listed below, but shall be a complete installation. For details, see Bridge Structures Girder Westbound, typical Details sheets.
   - Furnish and install 15kV cables into existing cable tray shown on this drawing. Refer to riser diagram on sheets E-664 and E-665.
   - Furnish and install TOS fiber optic cables into existing cable tray shown on this drawing. Refer to riser diagram on sheets E-978 through E-981.
   - Inspect for system ground continuity. See sheets E-666 and E-667.
3. All cable trays shown on this drawing are existing. Bolds ones are to be used for pulling cable.

SHEET NOTES:

(1) For Service Platform #18W details, see sheet E-650.

(2) Furnish and install splice cable tray as shown on sheet E-663, plan detail 2.

REQUEST FOR INFORMATION NOT ADDRESSED IN THIS CCO REMAIN IN FORCE

MARK	DATE	DESCRIPTIONS	BY	CH'D	CCO#
0	03/08/10	MEP INTEGRATION	SYC	FW	110

REVISIONS

CONTRACT CHANGE ORDER NO._____
SHEET _____ OF _____

BRIDGE STRUCTURES GIRDER WESTBOUND
SKYWAY STRUCTURES
SCALE: 1:200

E-612

THIS PLAN ACCURATE FOR ELECTRICAL WORK ONLY.

ALL DIMENSIONS ARE IN METERS UNLESS OTHERWISE SHOWN

	DATE	REVISED BY
SYC	01/10	DATE REVISED
FW	01/10	

CALCULATED/DESIGNED BY
CHECKED BY

DESIGN OVERSIGHT
BEHZAD GOLEMOHAMMADI

STATE OF CALIFORNIA - DEPARTMENT OF TRANSPORTATION
Caltrans

LAST REVISION 00-00-00
DATE PLOTTED => 06-MAY-2010
TIME PLOTTED => 18:03