DIST	COUNTY	ROUTE	KILOMETER POST TOTAL PROJECT	SHEET No	TOTAL SHEETS
04	SF,Ala	80	12.2/14.3 0.0/4.0	407a 06S26	1204

Syn Yee Chin 03/08/10
REGISTERED ELECTRICAL ENGINEER DATE

05-06-2010
PLANS APPROVAL DATE

REGISTERED PROFESSIONAL ENGINEER
SYN YEE CHIN
No. 18186
Exp. 09/30/2011
ELECTRICAL
STATE OF CALIFORNIA

PB AMERICAS, Inc.
A Parsons Brinckerhoff Company
303 Second St., Suite 700N
San Francisco, CA 94107-1317

The State of California or its officers or agents shall not be responsible for the accuracy or completeness of electronic copies of this plan sheet.

Caltrans now has a web site! To get to the web site, go to http://www.dot.ca.gov

Caltrans Metric

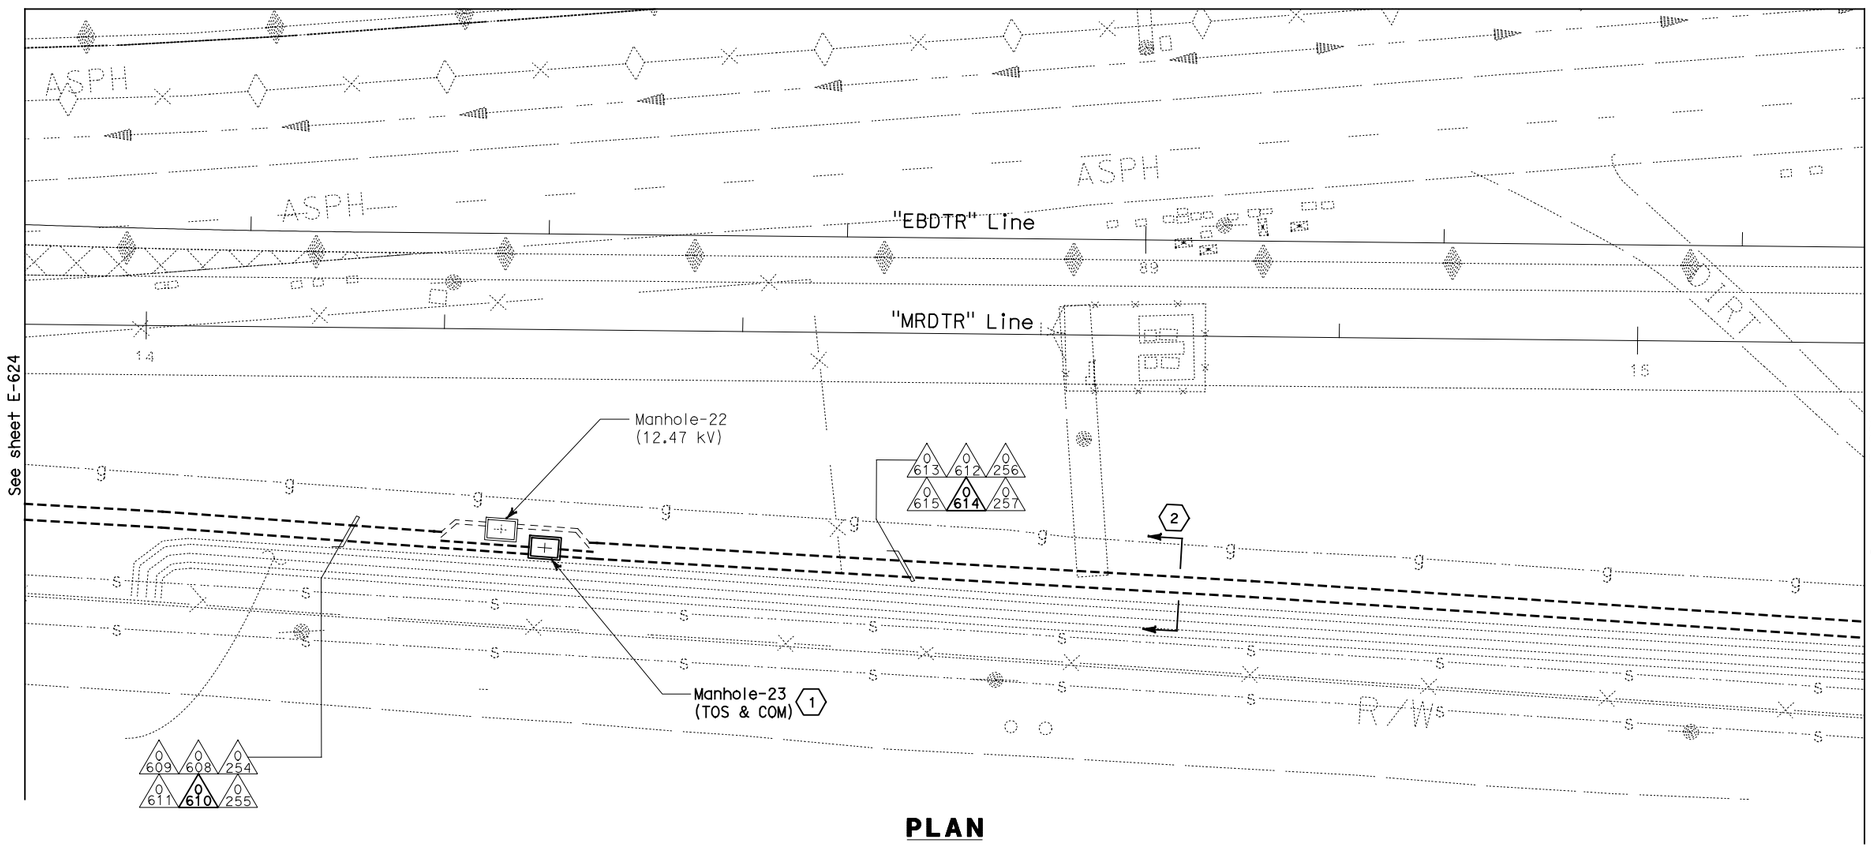

PLAN

NOTES:

1. This plan sheet is a record drawing from Oakland Touchdown 1 contract. The Contractor shall verify the existing installation. See sheet E-84 of Oakland Touchdown 1, contract No. 04-0120L4.
2. The installed components shall not be limited to the ones listed below, but shall be a complete installation. For details, see Bridge Structures Girder Westbound, typical Details sheets.
   - Furnish and install (4) one-inch inner-ducts with TOS fiber optic cables in one inner-duct, into existing conduit shown on this drawing. Refer to riser diagram on sheets E-978 through E-981 and detail on E-973.
3. All conduits shown on this drawings are existing. Bold ones are to be used for pulling cable.

THIS PLAN ACCURATE FOR ELECTRICAL WORK ONLY.

SHEET NOTES:

(1) For details on racking TOS fiber inside manhole, see E-663A, Detail 3.

(2) Cross section reference for conduit configuration.

ALL DIMENSIONS ARE IN METERS UNLESS OTHERWISE SHOWN

REQUEST FOR INFORMATION NOT ADDRESSED IN THIS CCO REMAIN IN FORCE

MARK	DATE	DESCRIPTIONS	BY	CH'D	CCO#
0	03/08/10	MEP INTEGRATION	SYC	FW	110

REVISIONS

CONTRACT CHANGE ORDER NO._____
SHEET _____ OF _____

BRIDGE STRUCTURES GIRDER WESTBOUND
OAKLAND APPROACH STRUCTURES UNDERGROUND

SCALE: 1:200

E-625

STATE OF CALIFORNIA - DEPARTMENT OF TRANSPORTATION
Caltrans

DESIGN OVERSIGHT
BEHZAD GOLEMOHAMMADI

CALCULATED/DESIGNED BY SYC DATE 01/10 REVISED BY
CHECKED BY FW 01/10 DATE REVISED

LAST REVISION 00-00-00
DATE PLOTTED => 06-MAY-2010
TIME PLOTTED => 18:04

FOR REDUCED PLANS ORIGINAL SCALE IS IN MILLIMETERS 0 20 40 60 80

DGN FILE =>04-0120f1_E-625.dgn
USERNAME =>llorico

CU 04251 EA 0120F1