

CONDUIT AND CABLE TRAY PLAN

NOTES:

- This plan sheet is a record drawing from Skyway Structures contract. The Contractor shall verify the existing installation. See sheet EE-97 from the Skyway Structures Contract No. 04-012024.
- The installed components shall not be limited to the ones listed below, but shall be a complete installation. For details, see Bridge Structures Girder Eastbound, typical Details sheets.
 - Furnish and install 15 kV cables into existing cable tray shown on this drawing. Refer to riser diagram on E-837.
 - Furnish and install TOS fiber optic cables into existing cable tray shown on this drawing. Refer to riser diagram on E-983.
 - Inspect for system ground continuity. See sheets E-839 and E-840.
- All cable trays shown on this drawing are existing. Bold ones are to be used for pulling cable.

SHEET NOTES:

- For Hinge EE area details, see sheet E-835.
- Furnish and install splice cable tray as shown on sheet E-836A, plan detail 6.
- Furnish and install 15 kV cable with length up to this point for splicing by others.
- Furnish and install fiber optic cable with length up to this point for splicing by others.

REQUEST FOR INFORMATION NOT ADDRESSED IN THIS CCO REMAIN IN FORCE					
△	03/08/10	MEP INTEGRATION	SYC	FW	110
MARK	DATE	DESCRIPTIONS	BY	CH'D	CCO#
REVISIONS					


CONTRACT CHANGE ORDER NO. _____
 SHEET _____ OF _____

**BRIDGE STRUCTURES GIRDER EASTBOUND
 SKYWAY STRUCTURES**
 SCALE: 1:200

E-816

THIS PLAN ACCURATE FOR ELECTRICAL WORK ONLY.

ALL DIMENSIONS ARE IN METERS UNLESS OTHERWISE SHOWN

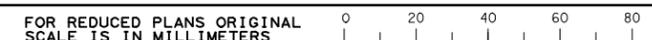


DGN FILE => 04-0120f1_E-816.dgn
 USERNAME => ilorico

CU 04251

EA 0120F1

DIST	COUNTY	ROUTE	KILOMETER TOTAL PROJECT	POST PROJECT	SHEET No	TOTAL SHEETS
04	SF, Ala	80	12.2/14.3	0.0/4.0	407a	1204
					03/08/10	
					REGISTERED ELECTRICAL ENGINEER	DATE
					05-06-2010	
					PLANS APPROVAL DATE	
					PB AMERICAS, Inc.	
					A Parsons Brinckerhoff Company	
					303 Second St., Suite 700N	
					San Francisco, CA 94107-1317	
The State of California or its officers or agents shall not be responsible for the accuracy or completeness of electronic copies of this plan sheet.						
Caltrans now has a web site! To get to the web site, go to http://www.dot.ca.gov						

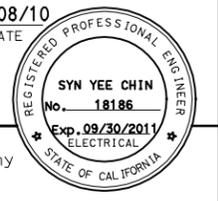

DATE PLOTTED => 06-MAY-2010
 TIME PLOTTED => 18:24
 LAST REVISION 00-00-00