

DIST	COUNTY	ROUTE	KILOMETER TOTAL PROJECT	POST PROJECT	SHEET No	TOTAL SHEETS
04	SF, Alameda	80	12.2/14.3	0.0/4.0	407a	1204
			03/08/10			
			REGISTERED ELECTRICAL ENGINEER		DATE	

Syn Yee Chin
 REGISTERED PROFESSIONAL ENGINEER
 No. 18186
 Exp. 09/30/2011
 STATE OF CALIFORNIA

PLANS APPROVAL DATE _____

PB AMERICAS, Inc.
 A Parsons Brinckerhoff Company
 303 Second St., Suite 700N
 San Francisco, CA 94107-1317

The State of California or its officers or agents shall not be responsible for the accuracy or completeness of electronic copies of this plan sheet.

Caltrans now has a web site! To get to the web site, go to <http://www.dot.ca.gov>

NOTES:

- This plan sheet is a record drawing from Skyway Structures contract. The Contractor shall verify the existing installation. See sheet EE-302A from Skyway Structures, contract No. 04-012024.
- The installed components shall not be limited to the ones listed below, but shall be a complete installation. For details, see Bridge Structures Girder Eastbound, typical Details sheets.
 - Furnish and install the 15kV cables into existing cable trays and conduits shown on this drawing. See sheet E-837.
 - Furnish and install fiber optic cables into existing cable trays and conduits shown on this drawing. See sheet E-983.
 - Inspect for system ground continuity. See sheets E-839 and E-840.
- All cable trays and conduits shown on this drawing are existing. Bold ones are to be used for pulling cable.

SHEET NOTES:

- Furnish and install splice cable tray as shown on sheet E-836, plan detail 1.
- Mount splice cable tray between diaphragms at Station 74+68 as shown on E-810 and secure properly. See sheet E-836, section detail 4.
- In order to be able to pull the 15 kV cable, the Contractor shall disassemble the 15 kV flexible conduit installation. The 15 kV flexible conduit shall be reinstalled after the 15 kV cable has been pulled.

REQUEST FOR INFORMATION NOT ADDRESSED IN THIS CCO REMAIN IN FORCE					
△	03/08/10	MEP INTEGRATION	SYC	FW	110
MARK	DATE	DESCRIPTIONS	BY	CH'D	CCO#
REVISIONS					

CONTRACT CHANGE ORDER NO. _____
 SHEET _____ OF _____


PLAN - HINGE CE
 SCALE: 1:75

DETAILS
 BRIDGE STRUCTURES GIRDER EASTBOUND
 SKYWAY STRUCTURES - HINGE CE
 SCALE AS NOTED

E-829A

THIS PLAN ACCURATE FOR ELECTRICAL WORK ONLY.

ALL DIMENSIONS ARE IN METERS UNLESS OTHERWISE SHOWN

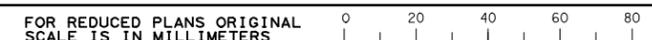

DGN FILE => 04-0120f1_E-829A.dgn
 USERNAME => llorico