DIST	COUNTY	ROUTE	KILOMETER POST TOTAL PROJECT	SHEET No	TOTAL SHEETS
04	SF,Ala	80	12.2/14.3 0.0/4.0	407a 08S39	1204

Syn Yee Chin 03/08/10
REGISTERED ELECTRICAL ENGINEER DATE

05-06-2010
PLANS APPROVAL DATE

REGISTERED PROFESSIONAL ENGINEER SYN YEE CHIN No. 18186 Exp. 09/30/2011 ELECTRICAL STATE OF CALIFORNIA

PB AMERICAS, Inc.
A Parsons Brinckerhoff Company
303 Second St., Suite 700N
San Francisco, CA 94107-1317

The State of California or its officers or agents shall not be responsible for the accuracy or completeness of electronic copies of this plan sheet.

Caltrans now has a web site! To get to the web site, go to http://www.dot.ca.gov

Skyway Structures Contract No. 04-012024 | Oakland Touchdown 1 Contract No. 04-0120L4

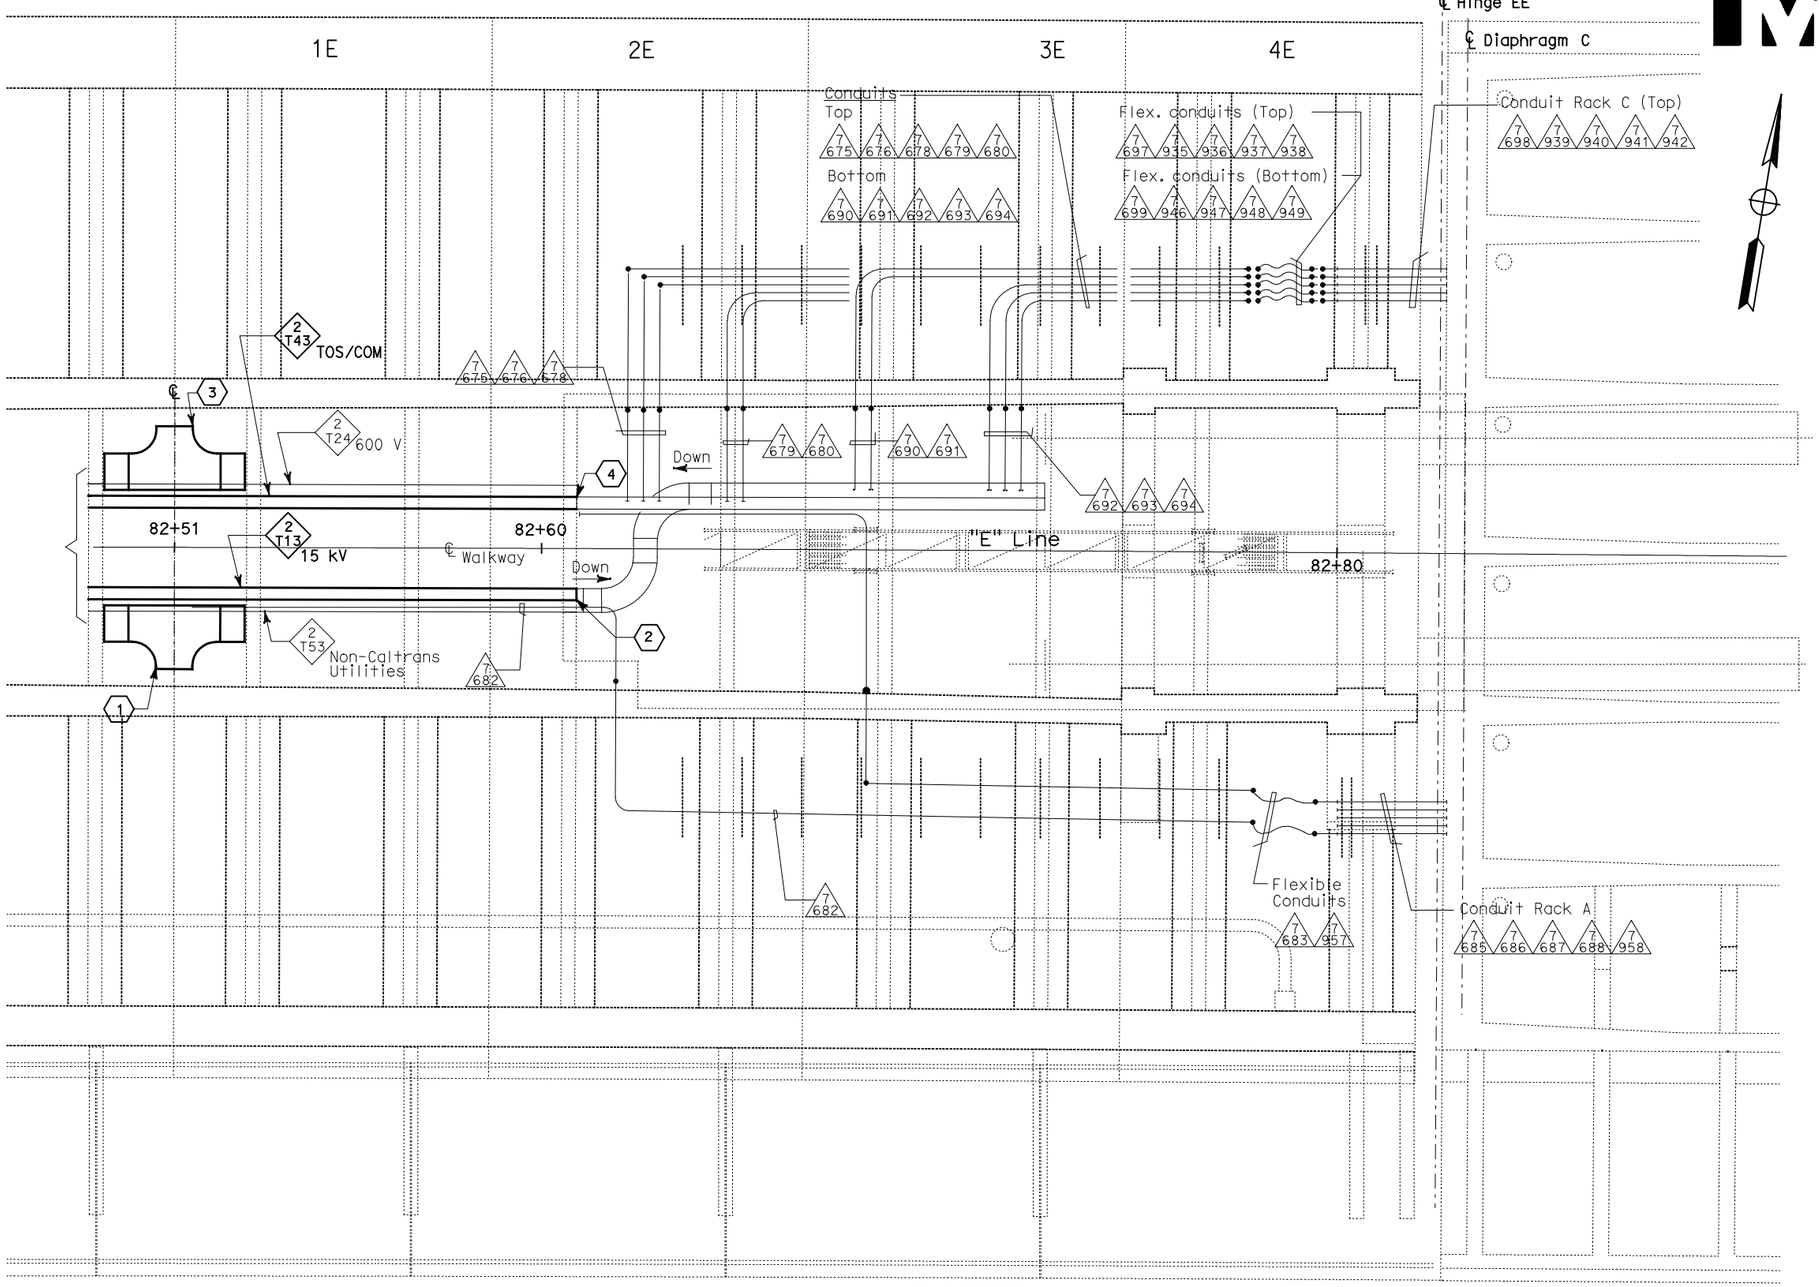

NOTES:

1. This plan sheet is a record drawing from Oakland Touchdown 1 contract. The Contractor shall verify the existing installation. See sheet E-59 from Oakland Touchdown 1, contract No. 04-0120L4.
2. The installed components shall not be limited to the ones listed below, but shall be a complete installation. For details, see Bridge Structures Girder Eastbound, typical Details sheets.
   - Furnish and install the 15kV cables into existing cable tray shown on this drawing. See sheet E-837.
   - Furnish and install the fiber optic cable into existing cable tray shown on this drawing. See sheet E-983 and E-984.
3. All cable trays and conduits shown on this drawing are existing. Bold ones are to be used for pulling cable.

SHEET NOTES:

1. Furnish and install splice cable tray as shown on sheet E-836A, Detail 6.
2. Furnish and install 15 kV cables with length up to this point for splicing by others.
3. Furnish and install splice cable tray as shown on sheet E-836A, Detail 7.
4. Furnish and install fiber optic cable with length up to this point for splicing by others.

PLAN - HINGE EE

SCALE: 1:75

REQUEST FOR INFORMATION NOT ADDRESSED IN THIS CCO REMAIN IN FORCE

MARK	DATE	DESCRIPTIONS	BY	CH'D	CCO#
0	03/08/10	MEP INTEGRATION	SYC	FW	110

REVISIONS

CONTRACT CHANGE ORDER NO._____
SHEET _____ OF _____

DETAILS
BRIDGE STRUCTURES GIRDER EASTBOUND
SKYWAY STRUCTURES-HINGE EE

SCALE: AS NOTED

E-835

THIS PLAN ACCURATE FOR ELECTRICAL WORK ONLY.

ALL DIMENSIONS ARE IN METERS UNLESS OTHERWISE SHOWN

FOR REDUCED PLANS ORIGINAL SCALE IS IN MILLIMETERS 0 20 40 60 80

DGN FILE =>04-0120f1_E-835.dgn
USERNAME =>llorico

CU 04251 | EA 0120F1

LAST REVISION 00-00-00 | DATE PLOTTED => 06-MAY-2010 TIME PLOTTED => 18:26

STATE OF CALIFORNIA - DEPARTMENT OF TRANSPORTATION
Caltrans

DESIGN OVERSIGHT
BEHZAD GOLEMOHAMMADI

CALCULATED/DESIGNED BY SYC | DATE 01/10 | REVISED BY
CHECKED BY FW | 01/10 | DATE REVISED