DIST	COUNTY	ROUTE	KILOMETER POST TOTAL PROJECT	SHEET No	TOTAL SHEETS
04	SF,Ala	80	12.2/14.3 0.0/4.0	407a 09S01	1204

Syn Yee Chin 03/08/10
REGISTERED ELECTRICAL ENGINEER DATE

05-06-2010
PLANS APPROVAL DATE

REGISTERED PROFESSIONAL ENGINEER SYN YEE CHIN No. 18186 Exp. 09/30/2011 ELECTRICAL STATE OF CALIFORNIA

PB AMERICAS, Inc.
A Parsons Brinckerhoff Company
303 Second St., Suite 700N
San Francisco, CA 94107-1317

The State of California or its officers or agents shall not be responsible for the accuracy or completeness of electronic copies of this plan sheet.

Caltrans now has a web site! To get to the web site, go to http://www.dot.ca.gov

Caltrans Metric

PLAN

NOTES:

1. This plan sheet is a record drawing from Skyway Structures contract. The Contractor shall verify the exising installation. See sheet EE-116 of Skyway Structures, contract No. 04-012024.
2. Contractor to furnish and install Equipment at the Service Platforms and inside the Substations as shown on the detailed plans.
3. Contractor to work on the Telephone Terminal Box located at each service platform and inside the Substations as noted on detailed plans.

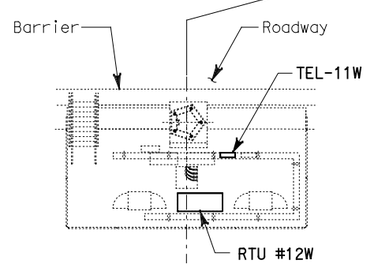

SERVICE PLATFORM #11W

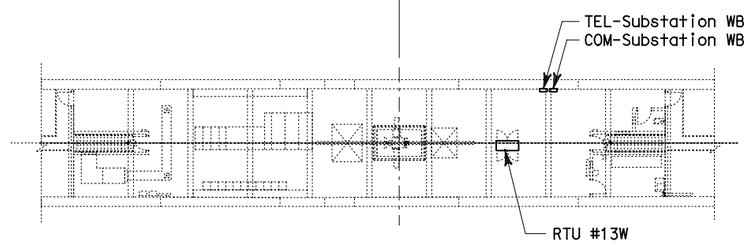

SUBSTATION WESTBOUND

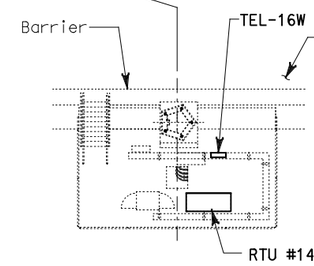

SERVICE PLATFORM #16W

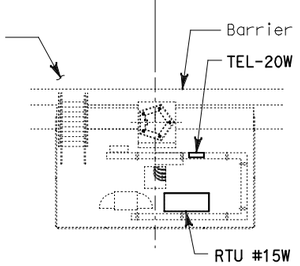

SERVICE PLATFORM #20W

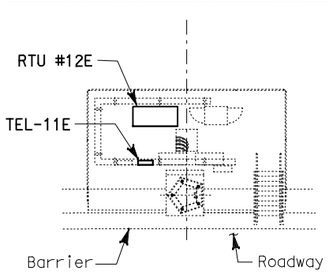

SERVICE PLATFORM #11E

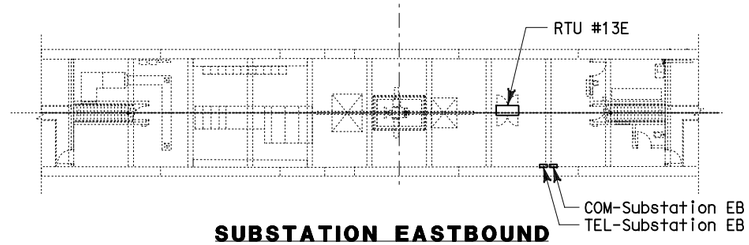

SUBSTATION EASTBOUND

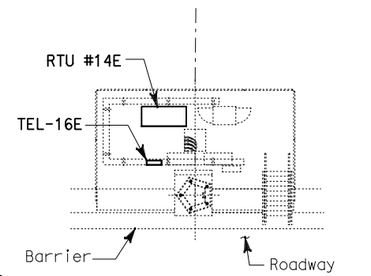

SERVICE PLATFORM #16E

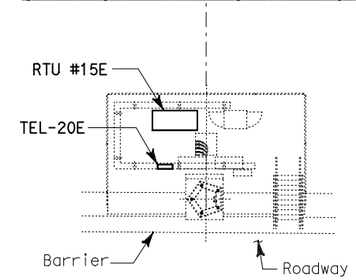

SERVICE PLATFORM #20E

REQUEST FOR INFORMATION NOT ADDRESSED IN THIS CCO REMAIN IN FORCE

MARK	DATE	DESCRIPTIONS	BY	CH'D	CCO#
0	03/08/10	MEP INTEGRATION	JE	FW	110

REVISIONS

CONTRACT CHANGE ORDER NO._____
SHEET _____ OF _____

SCADA REMOTE TERMINAL UNIT SYSTEM
SKYWAY STRUCTURES
EQUIPMENT LOCATIONS
NO SCALE

E-900

THIS PLAN ACCURATE FOR ELECTRICAL WORK ONLY.

DESIGN OVERSIGHT
BEHZAD GOLEMOHAMMADI

CALCULATED/DESIGNED BY SYC
CHECKED BY FW
DATE 01/10 01/10
REVISED BY
DATE REVISED

STATE OF CALIFORNIA - DEPARTMENT OF TRANSPORTATION
Caltrans

LAST REVISION 00-00-00
DATE PLOTTED => 25-MAY-2010
TIME PLOTTED => 15:02

FOR REDUCED PLANS ORIGINAL SCALE IS IN MILLIMETERS 0 20 40 60 80
DGN FILE =>04-0120f1_E-900.dgn
USERNAME =>llorico
CU 04251
EA 0120F1