DIST	COUNTY	ROUTE	KILOMETER POST TOTAL PROJECT	SHEET No	TOTAL SHEETS
04	SF,Ala	80	13.2 / 13.9	198S01	1204

Syn Yee Chin 10/28/10
REGISTERED ELECTRICAL ENGINEER DATE

PLANS APPROVAL DATE

REGISTERED PROFESSIONAL ENGINEER SYN YEE CHIN No. 18186 Exp. 09/30/2011 ELECTRICAL STATE OF CALIFORNIA

PB AMERICAS, Inc.
A Parsons Brinckerhoff Company
303 Second St., Suite 700N
San Francisco, CA 94107-1317

The State of California or its officers or agents shall not be responsible for the accuracy or completeness of electronic copies of this plan sheet.

Caltrans now has a web site! To get to the web site, go to http://www.dot.ca.gov

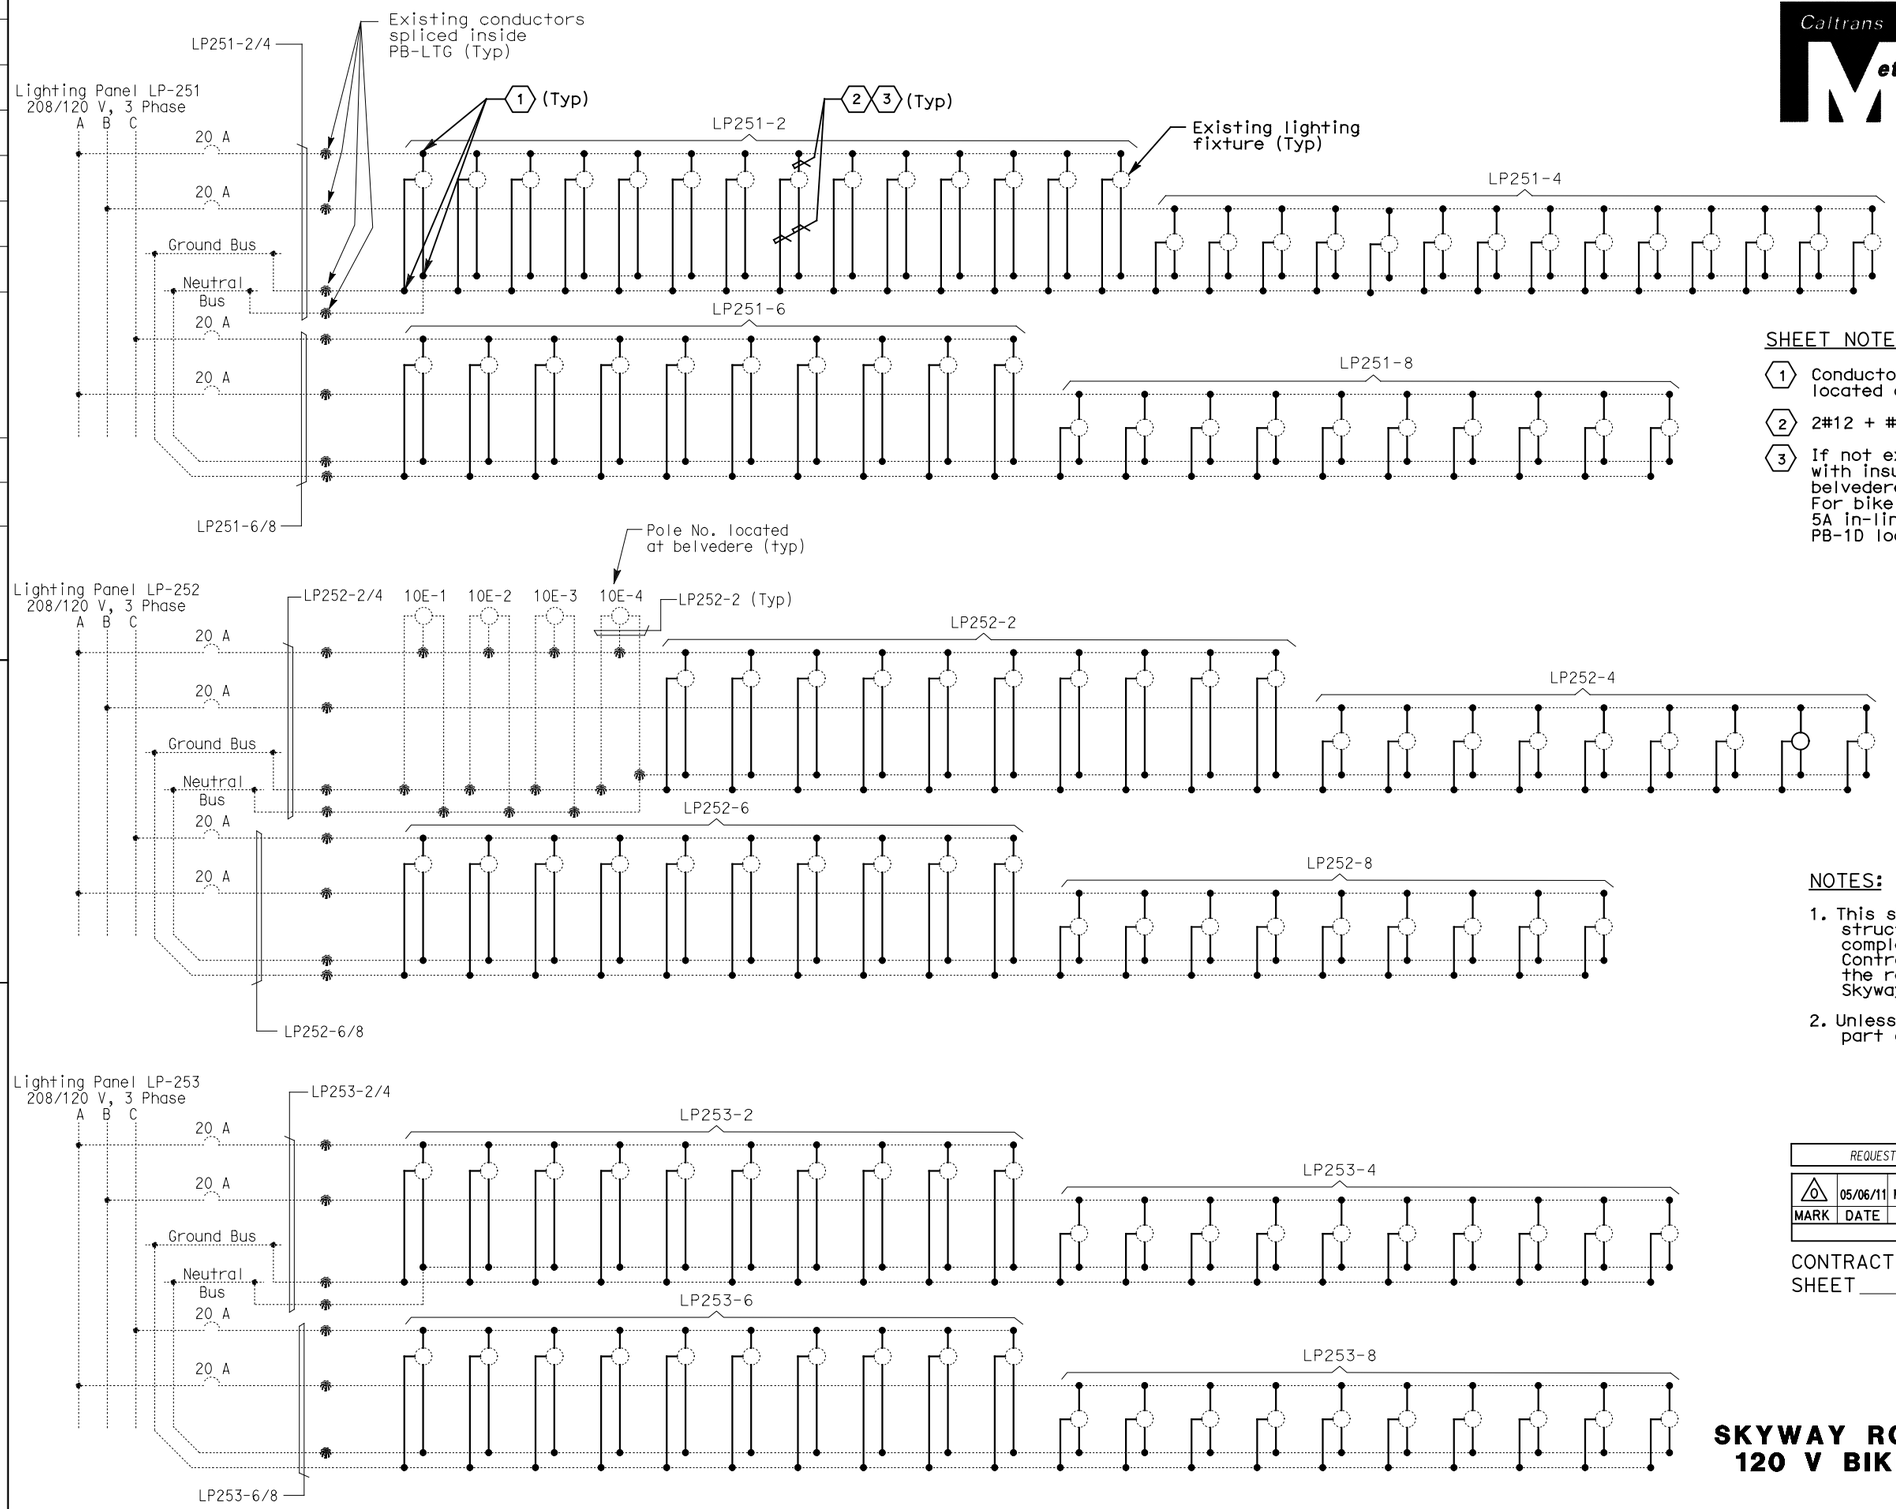

SHEET NOTES:

1. Conductors spliced inside PB-LTG (PB-1D) located at north side of Bike Path.
2. 2#12 + #12G, THWN. See Detail 1.
3. If not existing, install 5A in-line fuse in fuseholder with insulating boot per light fixture inside the belvedere light pole handhole for 10E-1 through 10E-4. For bike path lights (north/south hand railing) install 5A in-line fuses with water resistant fuseholder inside PB-1D located at north side of the bike path.

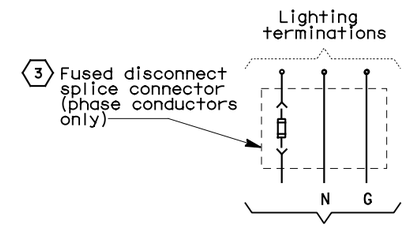

DETAIL-1
(TYP. FOR EACH BIKE PATH LIGHTING)

NOTES:

1. This sheet is a record drawing from Skyway structure. Existing condition shown may not completely reflect the actual as-built condition. Contractor to verify as-built prior to commencing the required modification. See Sheet EE-179 from Skyway Structures, contract No. 04-012024.
2. Unless shown in bold, everything else shown was part of Skyway Contract.

REQUEST FOR INFORMATION NOT ADDRESSED IN THIS CCO REMAIN IN FORCE

MARK	DATE	DESCRIPTIONS	BY	CH'D	CCO#
0	05/06/11	MEP INTEGRATION REV. & UPGRADES TO SYSTEMS	TW	RG	163

REVISIONS

CONTRACT CHANGE ORDER NO._____
SHEET _____ OF _____

SKYWAY ROADWAY LEVEL EASTBOUND 120 V BIKE PATH WIRING DIAGRAMS

NO SCALE

E-147A

THIS PLAN ACCURATE FOR ELECTRICAL WORK ONLY.

STATE OF CALIFORNIA - DEPARTMENT OF TRANSPORTATION
Caltrans

DESIGN OVERSIGHT: BEHZAD GOLEMOHAMMADI

CALCULATED/DESIGNED BY: XX | CHECKED BY: XX | DATE XX/10 | REVISED BY | DATE XX/10 | REVISED

LAST REVISION 00-00-00 | DATE PLOTTED => 10-MAY-2011 | TIME PLOTTED => 16:43

FOR REDUCED PLANS ORIGINAL SCALE IS IN MILLIMETERS 0 20 40 60 80

DGN FILE =>04-0120f1_0198S01.dgn
USERNAME =>llorico

CU 04251 | EA 0120F1