Notes

For Sprinkling System for Areas Adjacent to Phase I Wards, Kitchen-Dining Room-Commissary, Hospital, Schools, Phase II Wards, Employees Housing, Staff Housing, & Auditorium, See Contract 4144-Olivers' Nursery, Contractor - Wos. 2123, 2742, 2743, 2744 GC

STATE OF CALIFORNIA DIVISION OF HIGHWAYS
MATERIALS & RESEARCH DEPARTMENT

EQUI-POTENTIAL CONTOURS
PORTERVILLE STATE HOSPITAL

Lab. Auth. 100-S-6105

Survey Made May 7, 1957

EXHIBIT I

LEGEND

- Lubricated Plug Cock
- Fire Hydrant W/G.V.
- Line Valve
- B.O.W. Blow Off Valve
- Irrigation Valve

Note: All Potentials Are Negative (–) to a Copper-Sulfate Half Cell.

GAS LINES

Project	W.O.	Contract	Contractor	Symbol
Mechanical Services	2123	2784	Nomellini	—G-A—
Schools E-1-2-3-4	2123	3064	Newman Co	—G-B—
Phase II Wards	2742	3273	Wilner Plumbing Co.	—G-C—
Phase III & IV Wards	3144 3284	3863	S+E Pipe Line Co.	—G-D—
Fire House	3452	4289	R. Pederson & Sons	—G-E—
Incinerator	2123 3535	4252	R. Pederson & Sons	—G-F—

WATER LINES

Project	W.O.	Contract	Contractor	Symbol
Mechanical Services	2123	2784	Nomellini	---W-A---
Schools E-1-2-3-4	2123	3064	Newman Co.	---W-B---
Phase II Wards	2742	3273	Wilner Plumbing Co.	---W-C---
Phase III & IV Wards	3144 3284	3863	S&E Pipe Line Co.	---W-D---
Library & Therapy Bldg.	3536	4289	R. Pederson & Sons	---W-E---

THIS DRAWING IS HEREBY ACKNOWLEDGED TO BE PART OF THE PLANS REFERRED TO IN MY CONTRACT WITH THE STATE DEPARTMENT OF PUBLIC WORKS DIVISION OF ARCHITECTURE.

DATE

CONTRACTOR

STATE OF CALIFORNIA
DEPARTMENT OF PUBLIC WORKS
DIVISION OF ARCHITECTURE
SACRAMENTO
BY ASSISTANT STATE ARCHITECT

DESIGNED | DATE 4-16-55
DRAWN FITZNORRIS
TRACED | REVISED
CHECKED | FILE

SHEET TITLE WATER + GAS LINES
PROJECT AS BUILT MASTER PLAN
INSTITUTION PORTERVILLE STATE HOSPITAL
LOCATION PORTERVILLE CALIFORNIA

SHEET 1 OF THREE

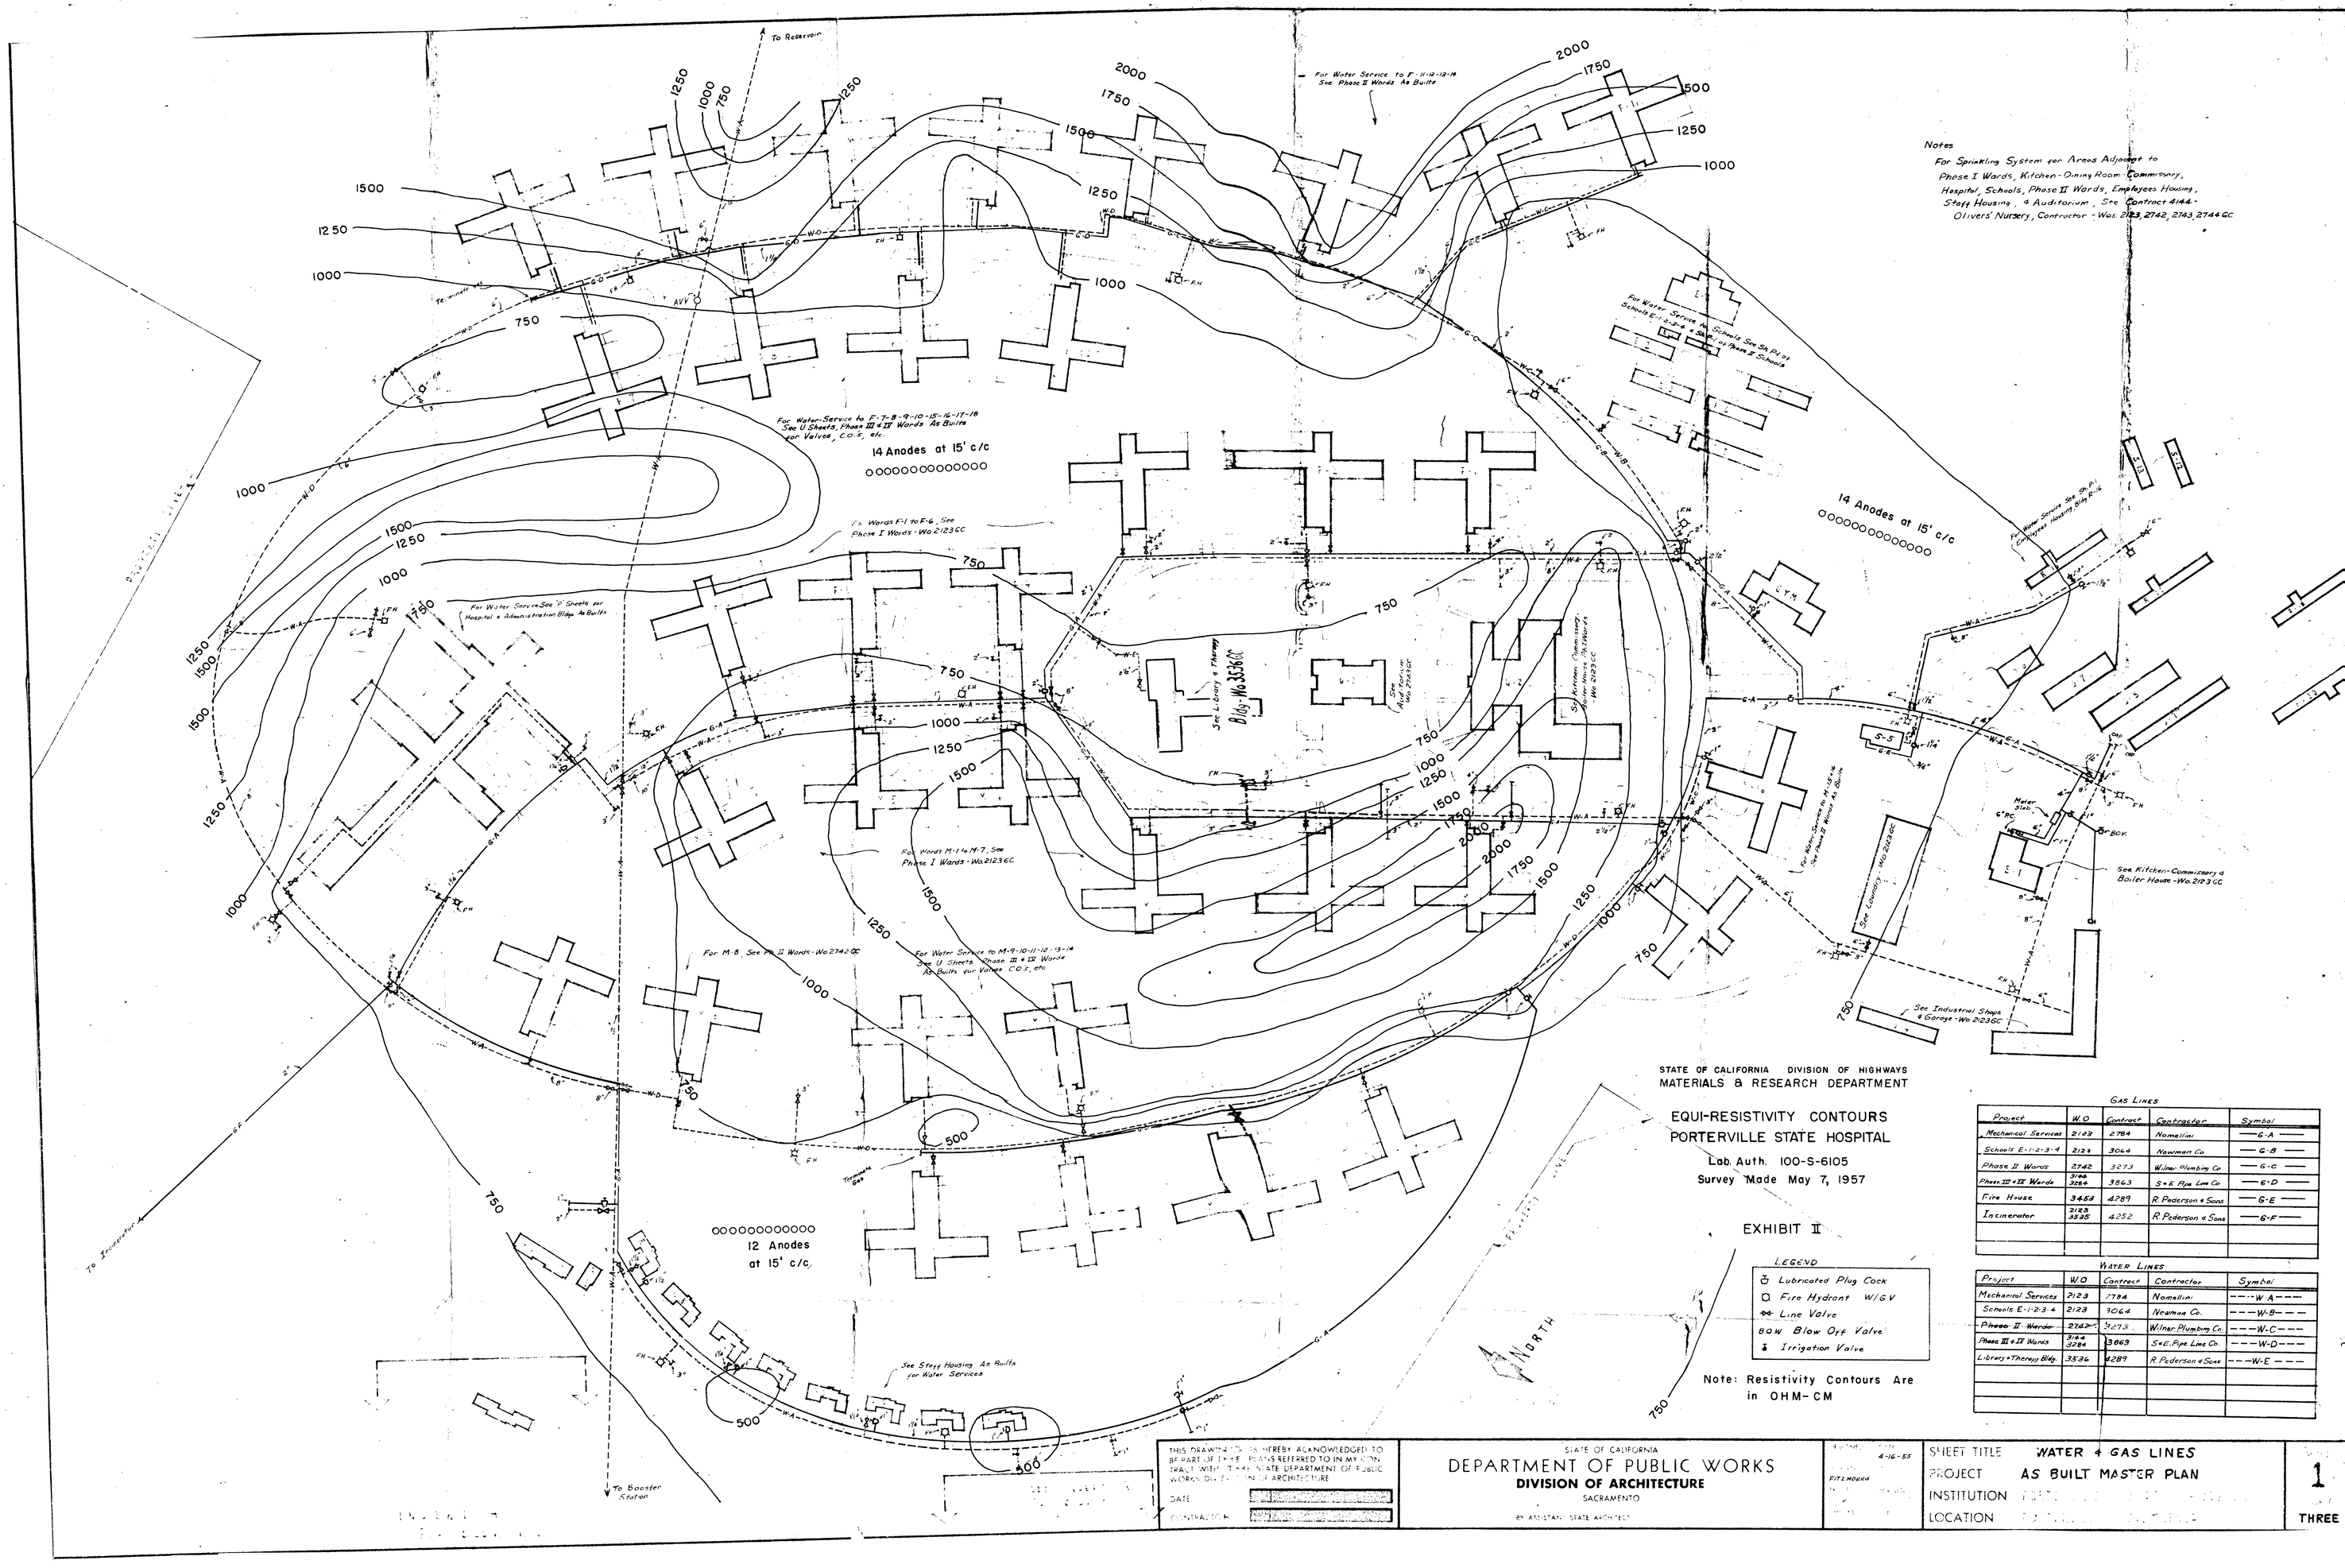

STATE OF CALIFORNIA DIVISION OF HIGHWAYS
MATERIALS & RESEARCH DEPARTMENT

EQUI-RESISTIVITY CONTOURS
PORTERVILLE STATE HOSPITAL

Lab. Auth. 100-S-6105
Survey Made May 7, 1957

EXHIBIT II

LEGEND

- Lubricated Plug Cock
- Fire Hydrant W/GV
- Line Valve
- BOW Blow Off Valve
- Irrigation Valve

Note: Resistivity Contours Are in OHM-CM

GAS LINES

Project	W.O.	Contract	Contractor	Symbol
Mechanical Services	2123	2784	Nomellini	G-A
Schools E-1-2-3-4	2123	3064	Newman Co.	G-B
Phase II Wards	2742	3273	Wilner Plumbing Co.	G-C
Phase III & IV Wards	3166 3284	3863	S & E Pipe Line Co.	G-D
Fire House	3453	4289	R. Pederson & Sons	G-E
Incinerator	3125 3525	4252	R. Pederson & Sons	G-F

WATER LINES

Project	W.O.	Contract	Contractor	Symbol
Mechanical Services	2123	2784	Nomellini	W-A
Schools E-1-2-3-4	2123	3064	Newman Co.	W-B
~~Phase II Wards~~	~~2742~~	~~3273~~	Wilner Plumbing Co.	W-C
Phase III & IV Wards	3166 3284	3863	S & E Pipe Line Co.	W-D
Library & Therapy Bldg.	3536	4289	R. Pederson & Sons	W-E

THIS DRAWING IS HEREBY ACKNOWLEDGED TO BE PART OF THE PLANS REFERRED TO IN MY CONTRACT WITH THE STATE DEPARTMENT OF PUBLIC WORKS, DIVISION OF ARCHITECTURE

DATE

SUPERVISING ARCHITECT

STATE OF CALIFORNIA
DEPARTMENT OF PUBLIC WORKS
DIVISION OF ARCHITECTURE
SACRAMENTO

BY ASSISTANT STATE ARCHITECT

4-16-55

FITZ MORRA

SHEET TITLE WATER & GAS LINES
PROJECT AS BUILT MASTER PLAN
INSTITUTION
LOCATION

SHEET 1 OF THREE